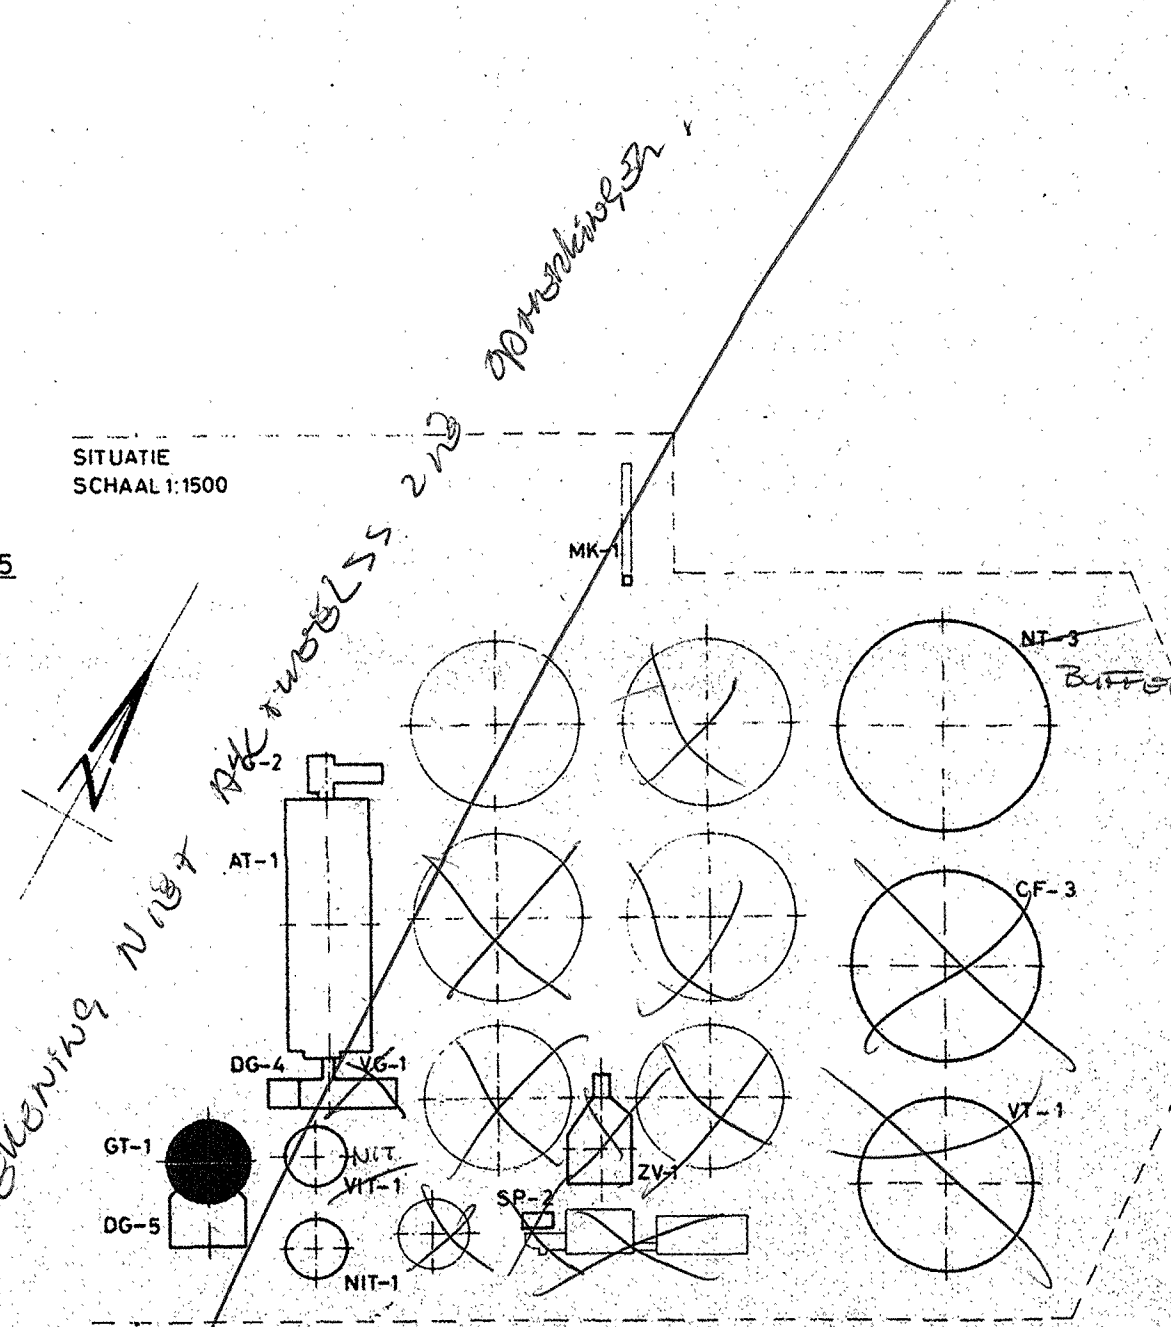
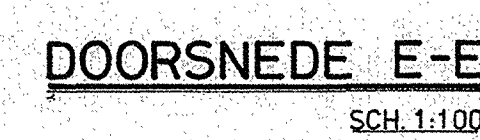
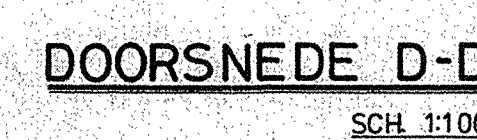
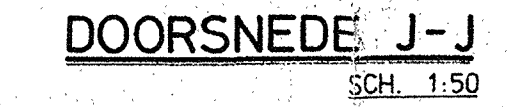
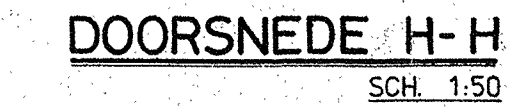
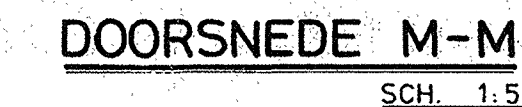
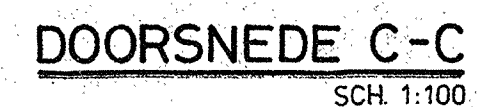
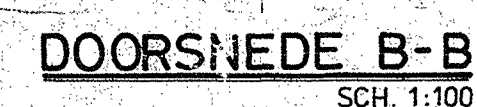
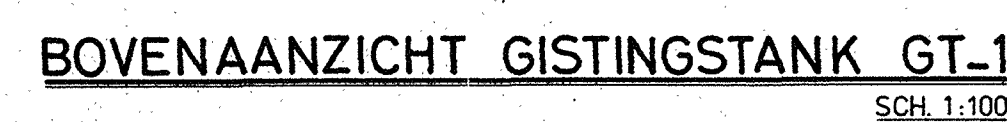


[illegible]