

4.


12

22

32


42

· ୨୭

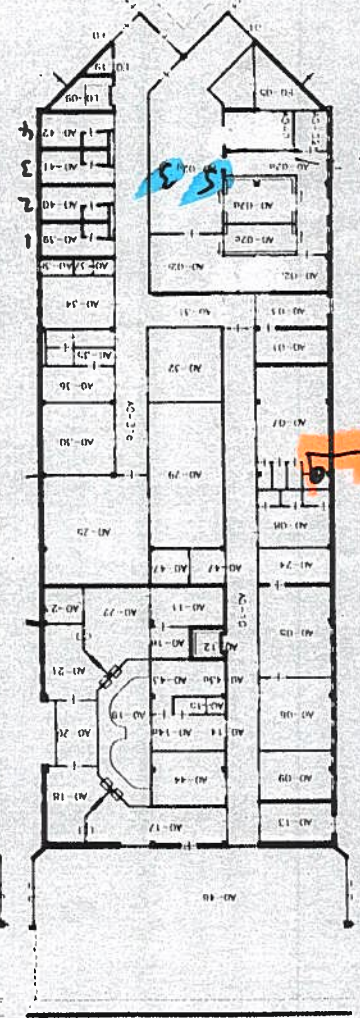


Week 2


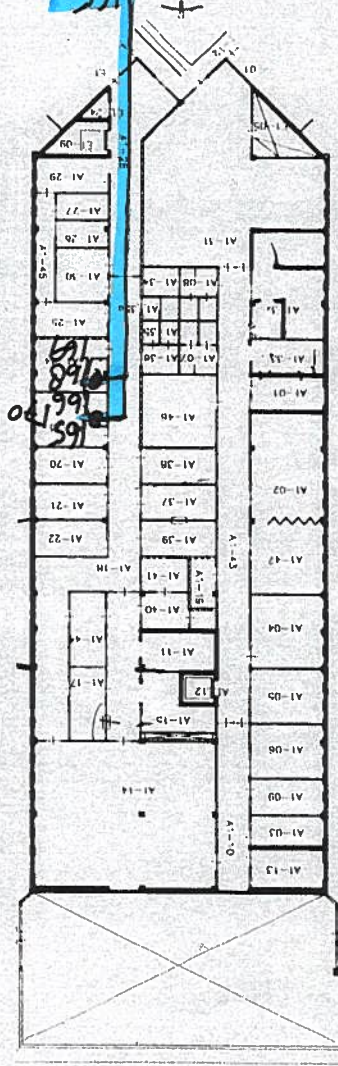


041
691
891
991
591

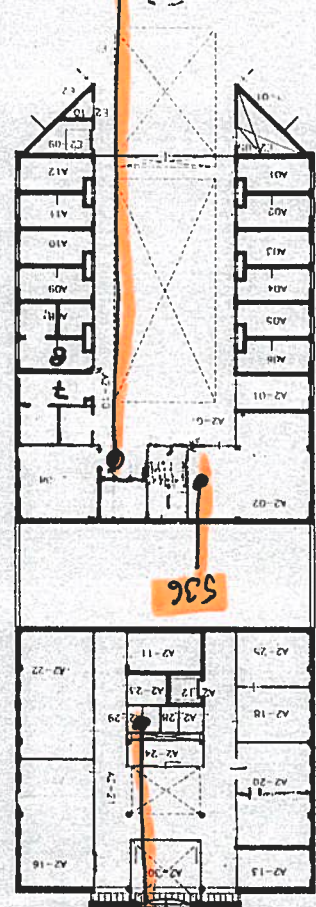


273

52

536

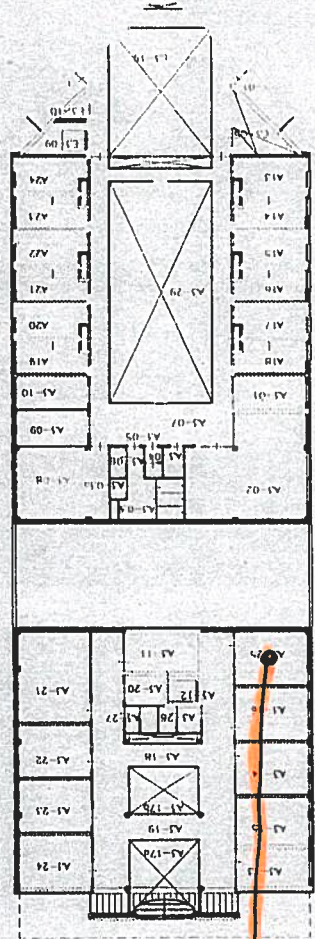

946

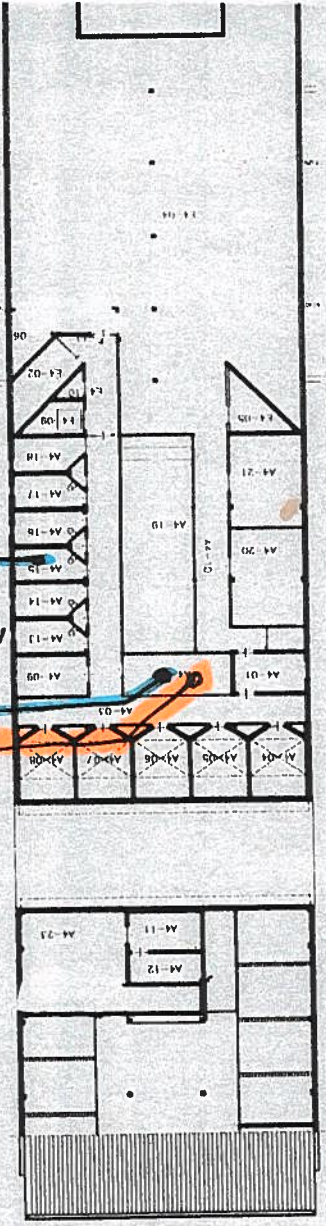

5
4

2
1 051





98t
48t

56t

884



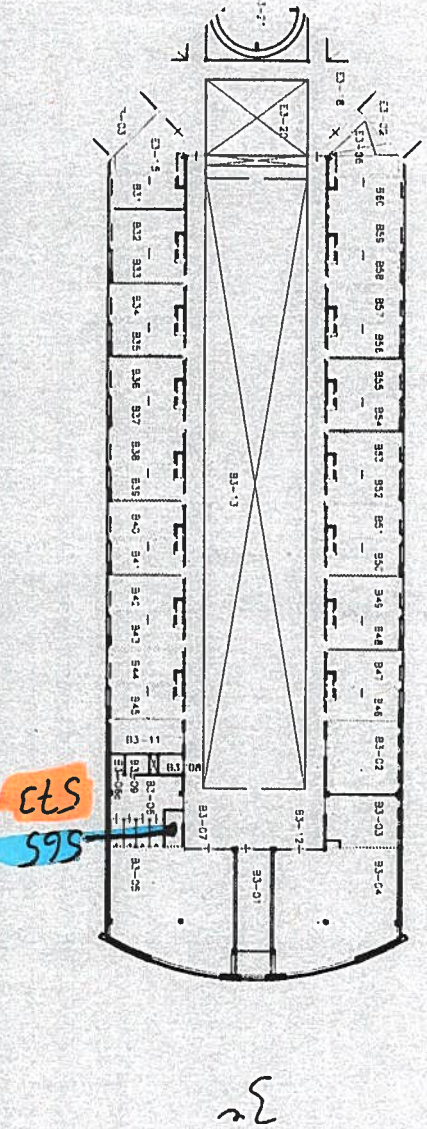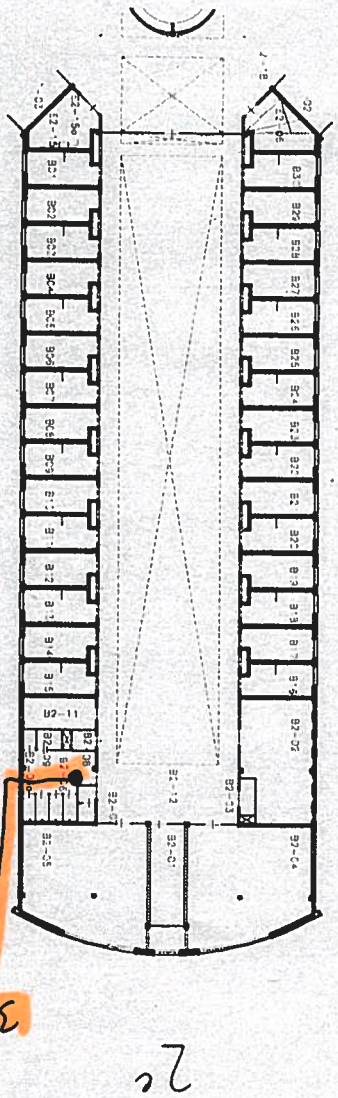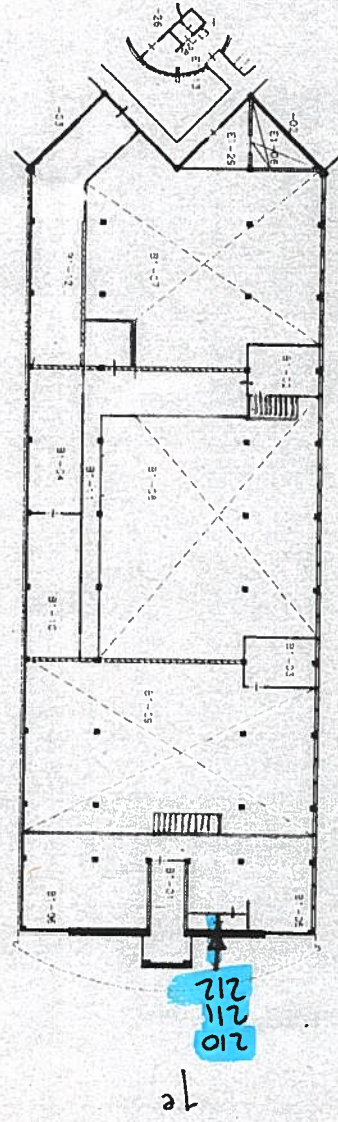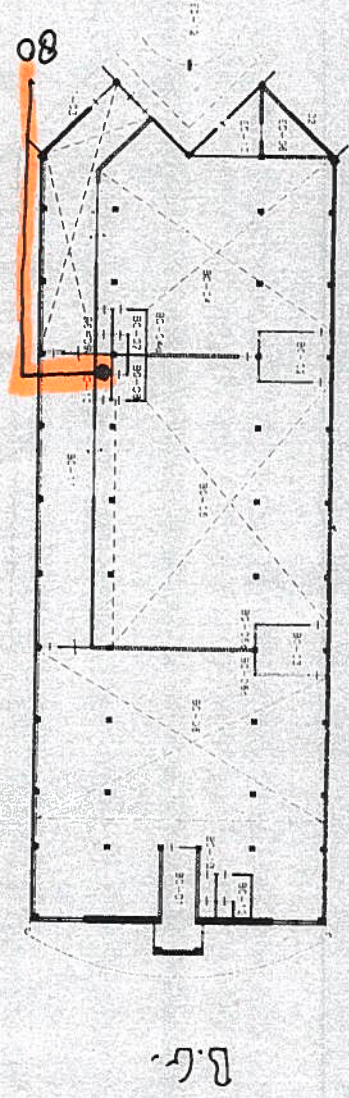





Booster C

B.G.

1c

2c

3c

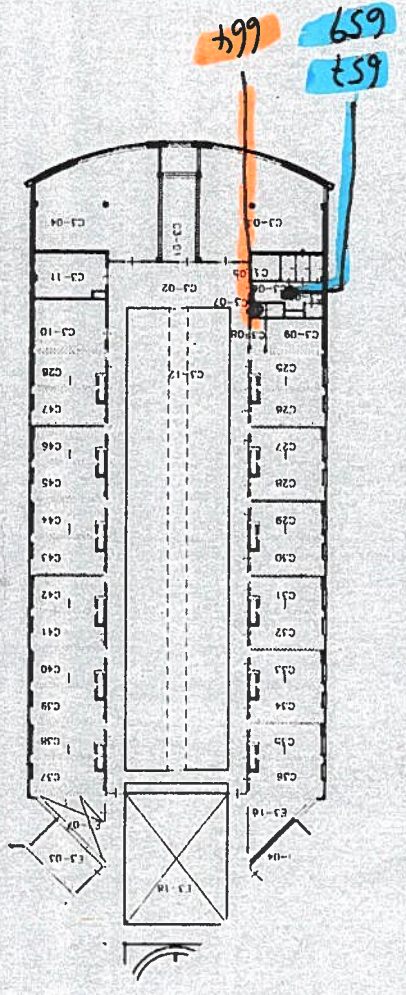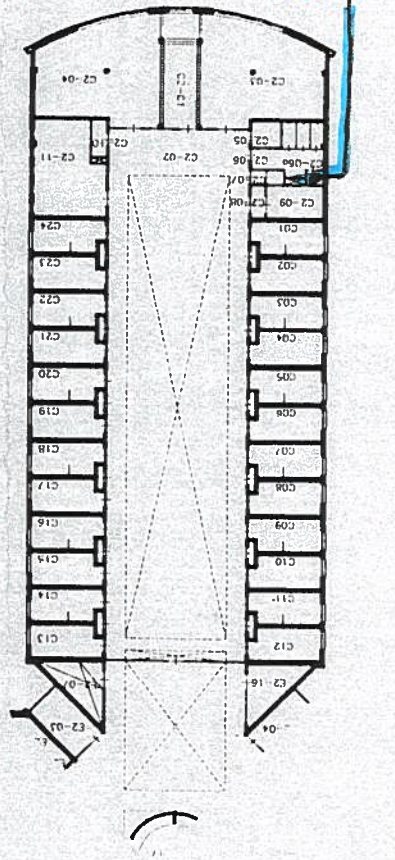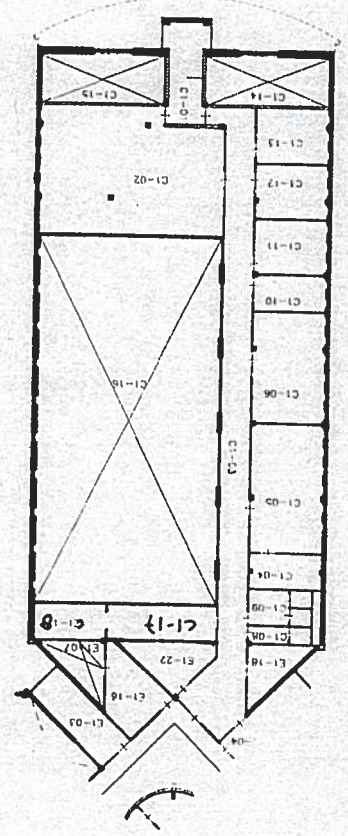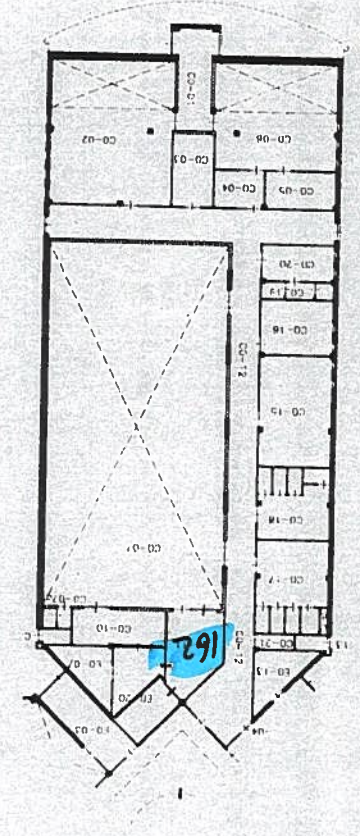




'D'




B.G.

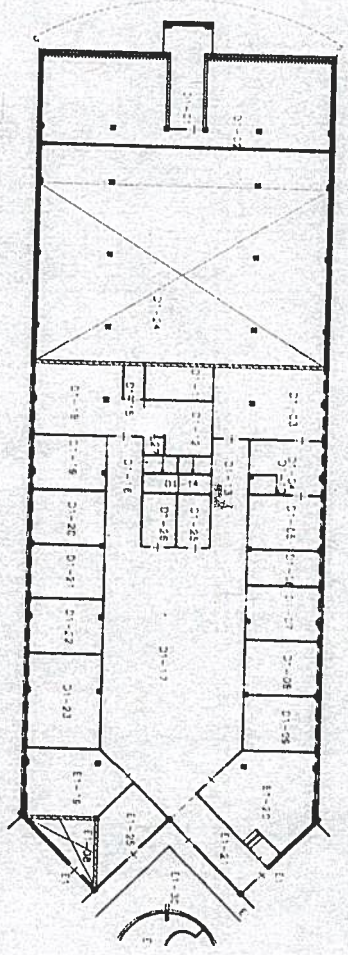

1c

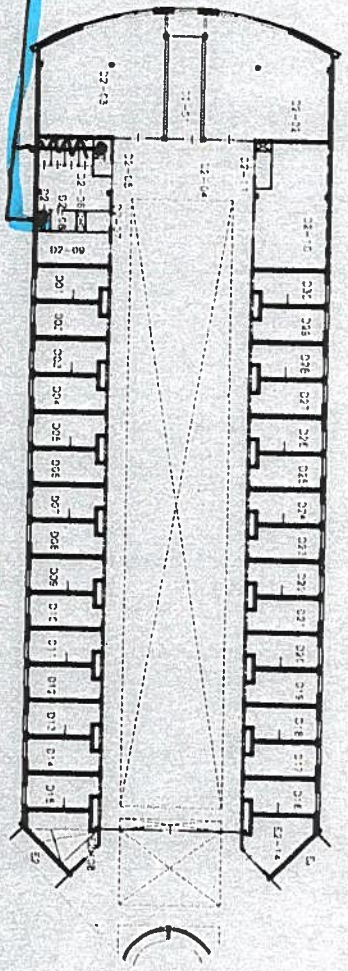

2c

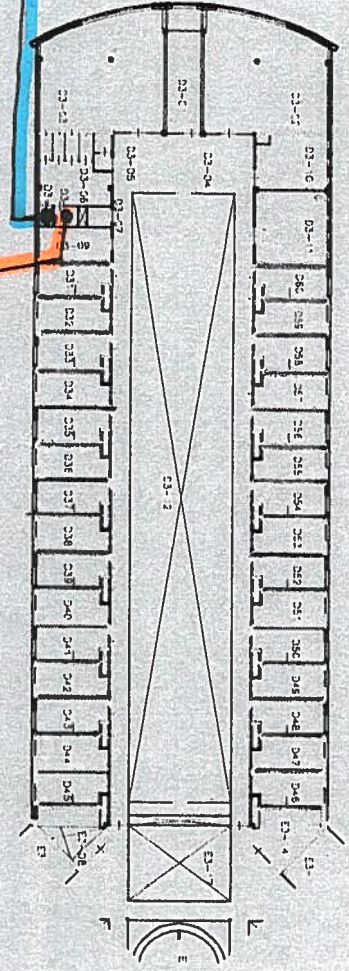

3c

6th

01E

720

140

Board 'E'






B.G.

1c

2c


3c

4c

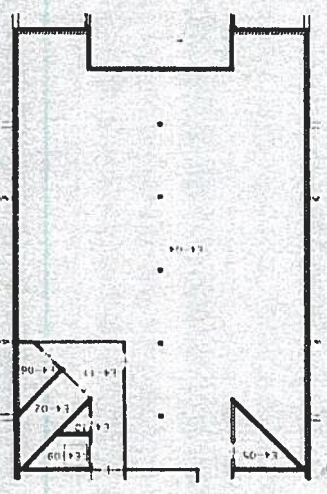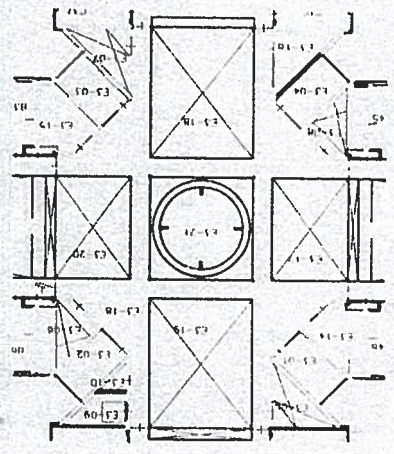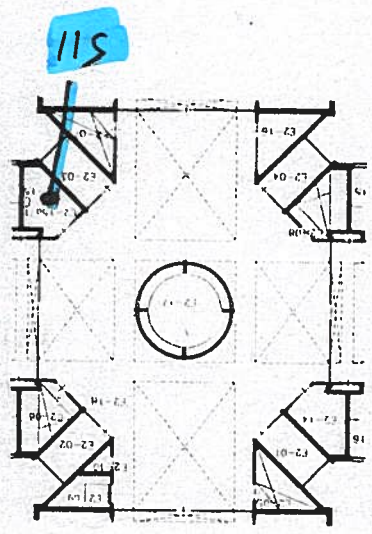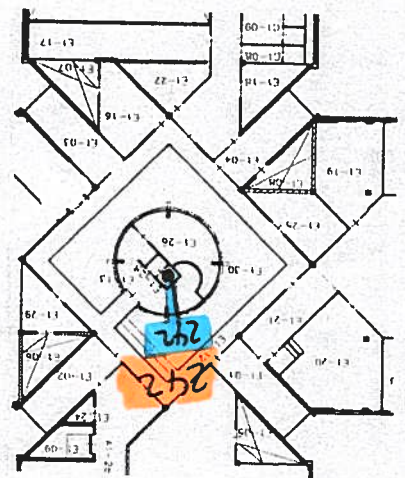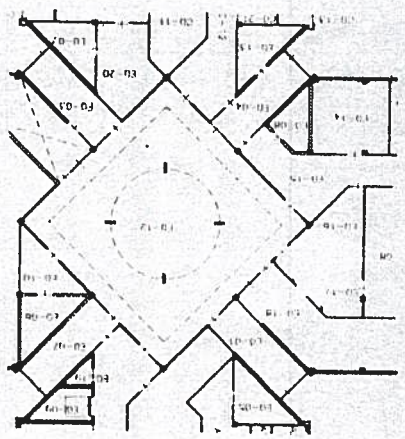

BBA

BOUWLAAG 0

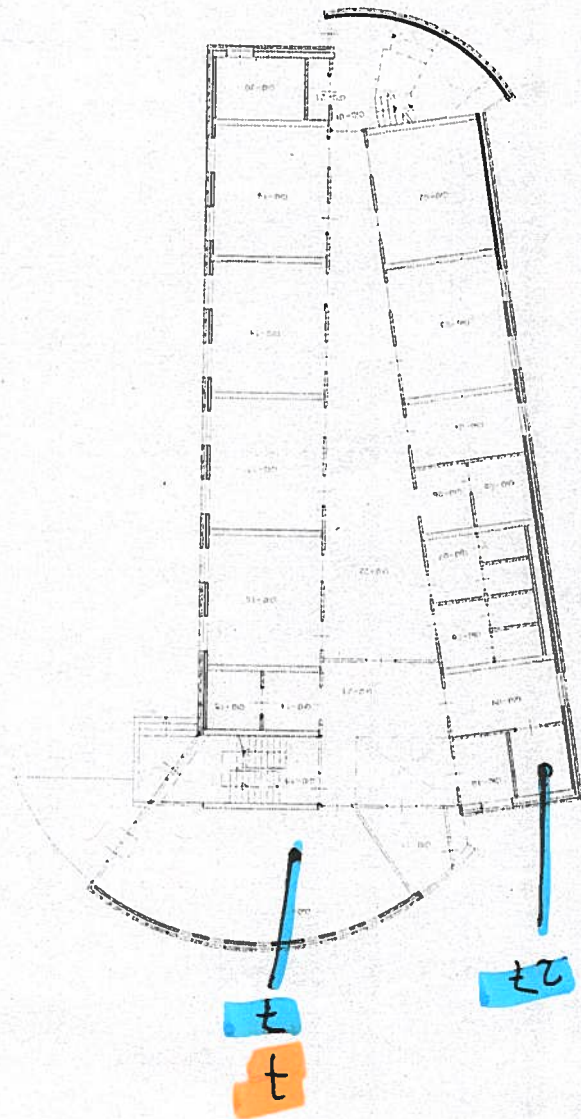

BOUWLAAG 1



BOUWLAAG 2

ALLE SLAAPKAMERS
BY LEESTAND RIJEN

