


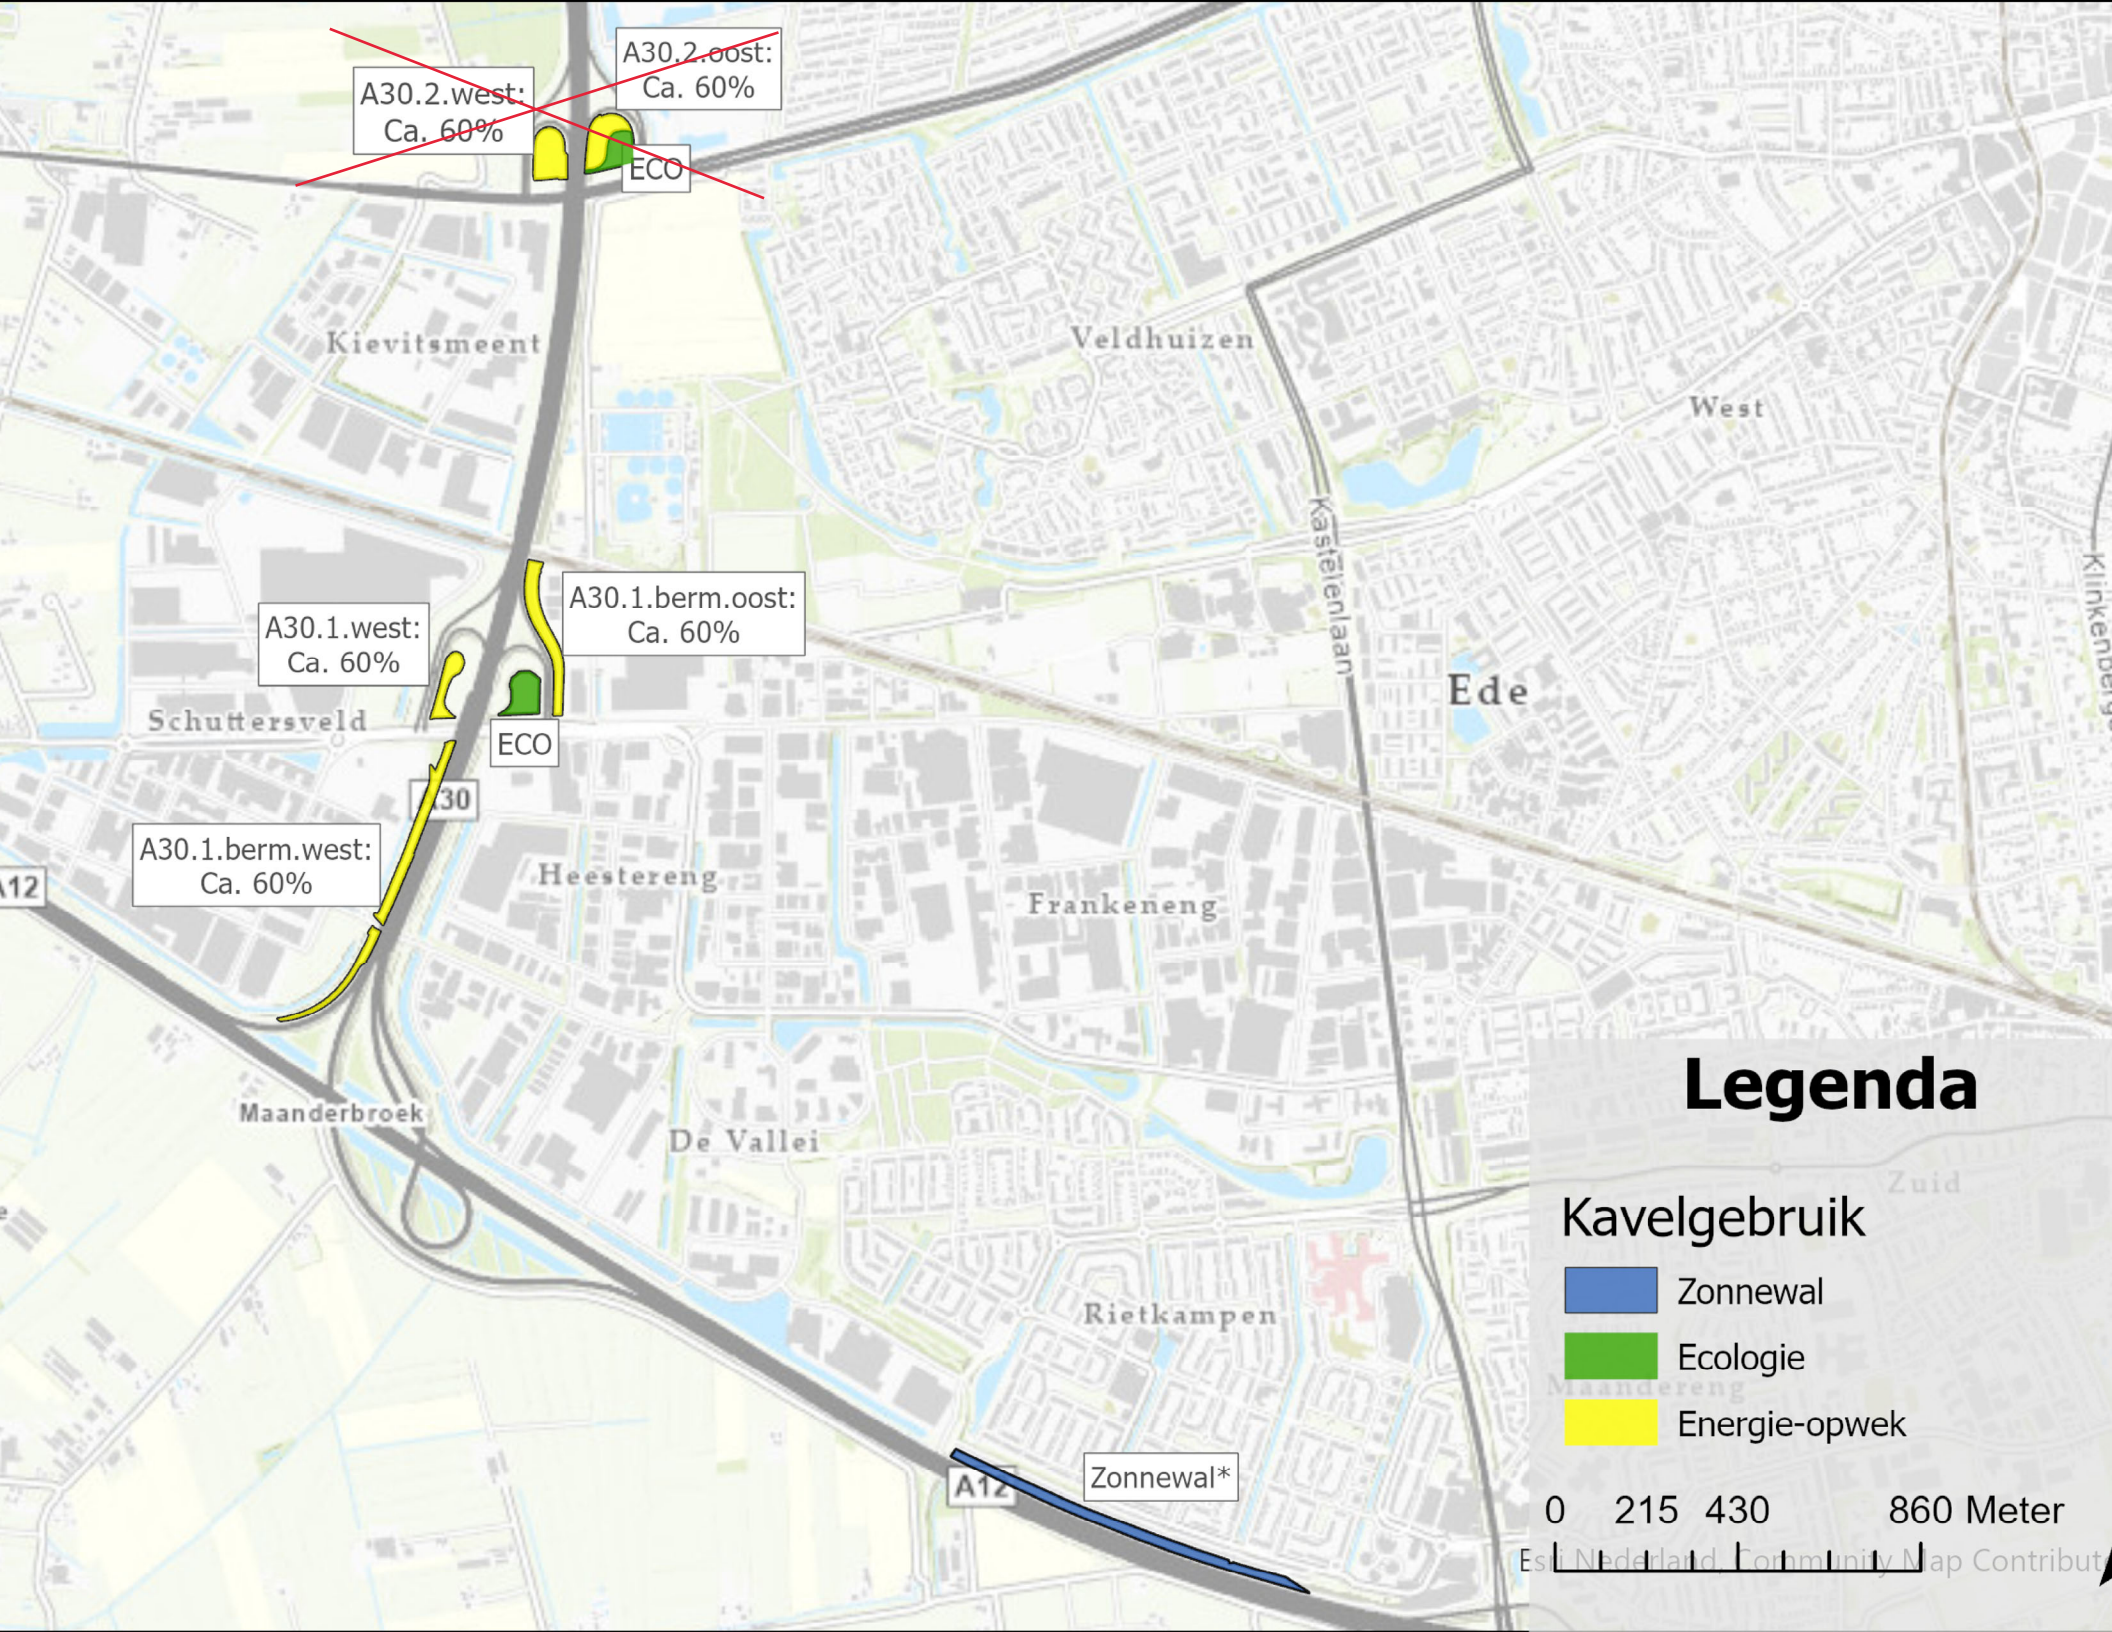

A30.2.west:
Ca. 60%

A30.2.oost:
Ca. 60%

ECO

Kievitsmeent

Veldhuizen

West

A30.1.west:
Ca. 60%

A30.1.berm.oost:
Ca. 60%

ECO

Schuttersveld

Ede

A30.1.berm.west:
Ca. 60%

A30

Heestereng

Frankeneng

Maanderbroek


De Vallei

Rietkampen

Zonnewal*

Legenda


Kavelgebruik

 

Zonnewal



Ecologie

 

Energie-opwek

0 215 430 860 Meter

Est Nederland Community Map Contributor



A30.1.west:
Ca. 60%


A30.1.berm.oost:
Ca. 60%

ECO

Legenda

 Kavel met verwachte
bedekkingsgraad

0 25 50 100 Meter

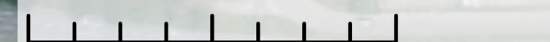



A30.1.berm.west:
Ca. 60%

Legenda

 Kavel met verwachte
bedekkingsgraad

0 37,5 75 150 Meter

