


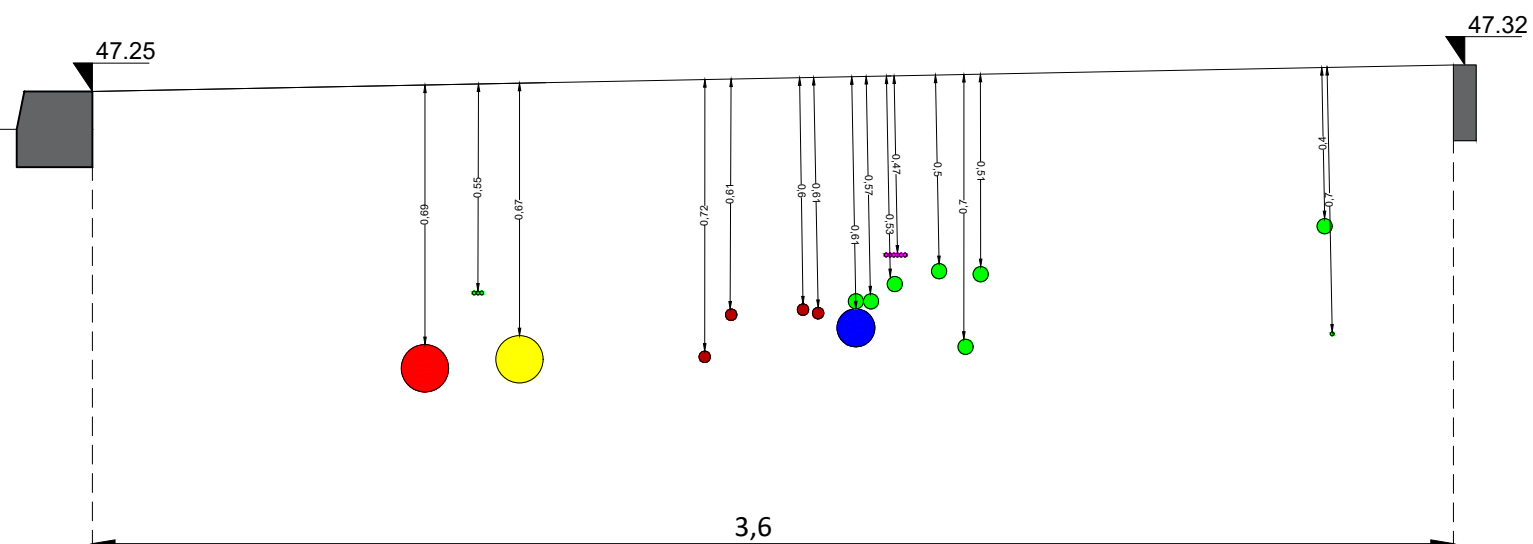

A3