


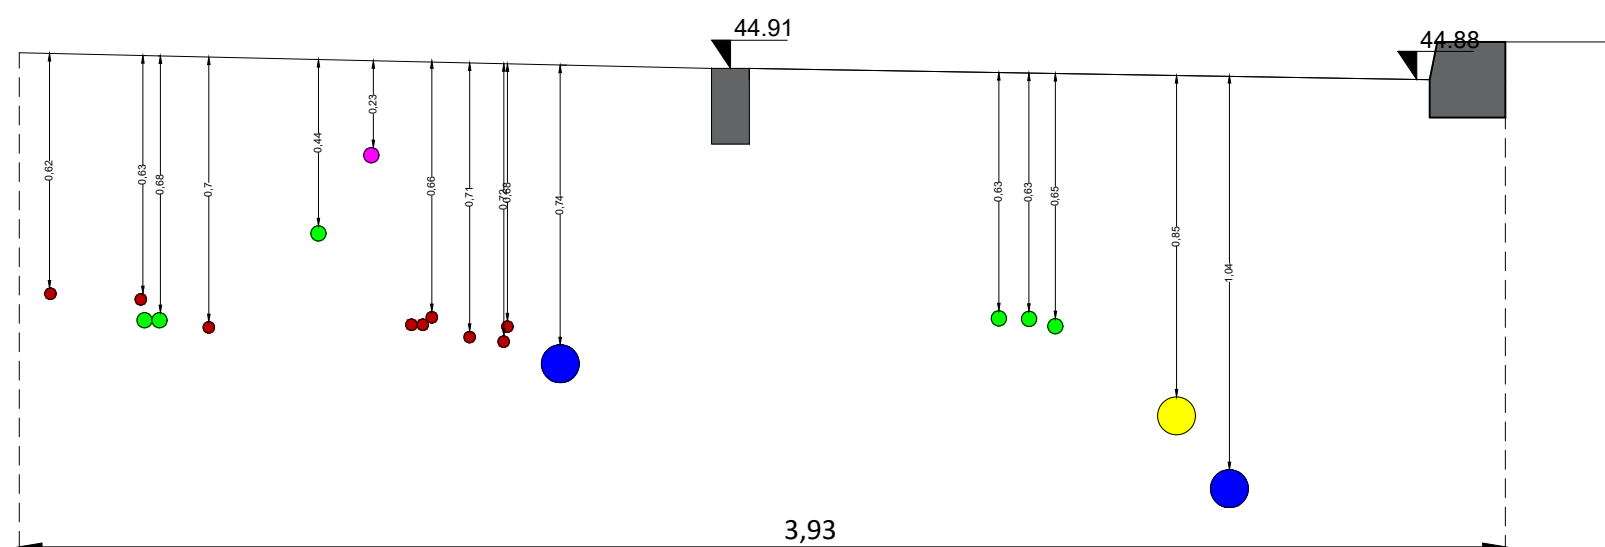

● RIOOL

1:200

Projectnr:	WN25	Datum:	1-06-2025
Besteknr:	n.v.t.		
Tekeningnr:	WN25307-13	Status:	Concept
Getekend:	SGo	Formaat:	A3
Schaal:	1:20 / 1:200		