


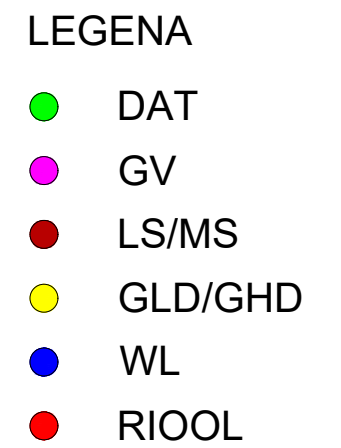

This topographic map shows a road intersection at a scale of 1:200. The map includes various elevation points (e.g., 46.22, 46.27, 46.29, 46.32, 46.38, 46.43, 46.46, 46.58, 46.36, 46.26, 46.19, 46.34, 46.28, 46.30, 46.31, 46.29, 46.38, 46.39, 46.42, 46.29, 46.17, 46.43) and a road labeled '33-35/11'. A scale bar indicates 1:200. The map also shows a road intersection and a road labeled 'gazon'.

OMSCHRIJVING:
Revisie proefsleuf 33B

6				
5				
4				
3				
2				
1				
0				
REVISIE	OMSCHRIJVING	GETEKEND	DATUM	
	Projectnr:	WN25	Datum:	1-06-2025
	Besteknr:	n.v.t.		
	Tekeningnr:	WN25307-21	Status:	Concept
	Getekend:	SGo	Formaat:	A3
	Schaal:	1:20 / 1:200		