



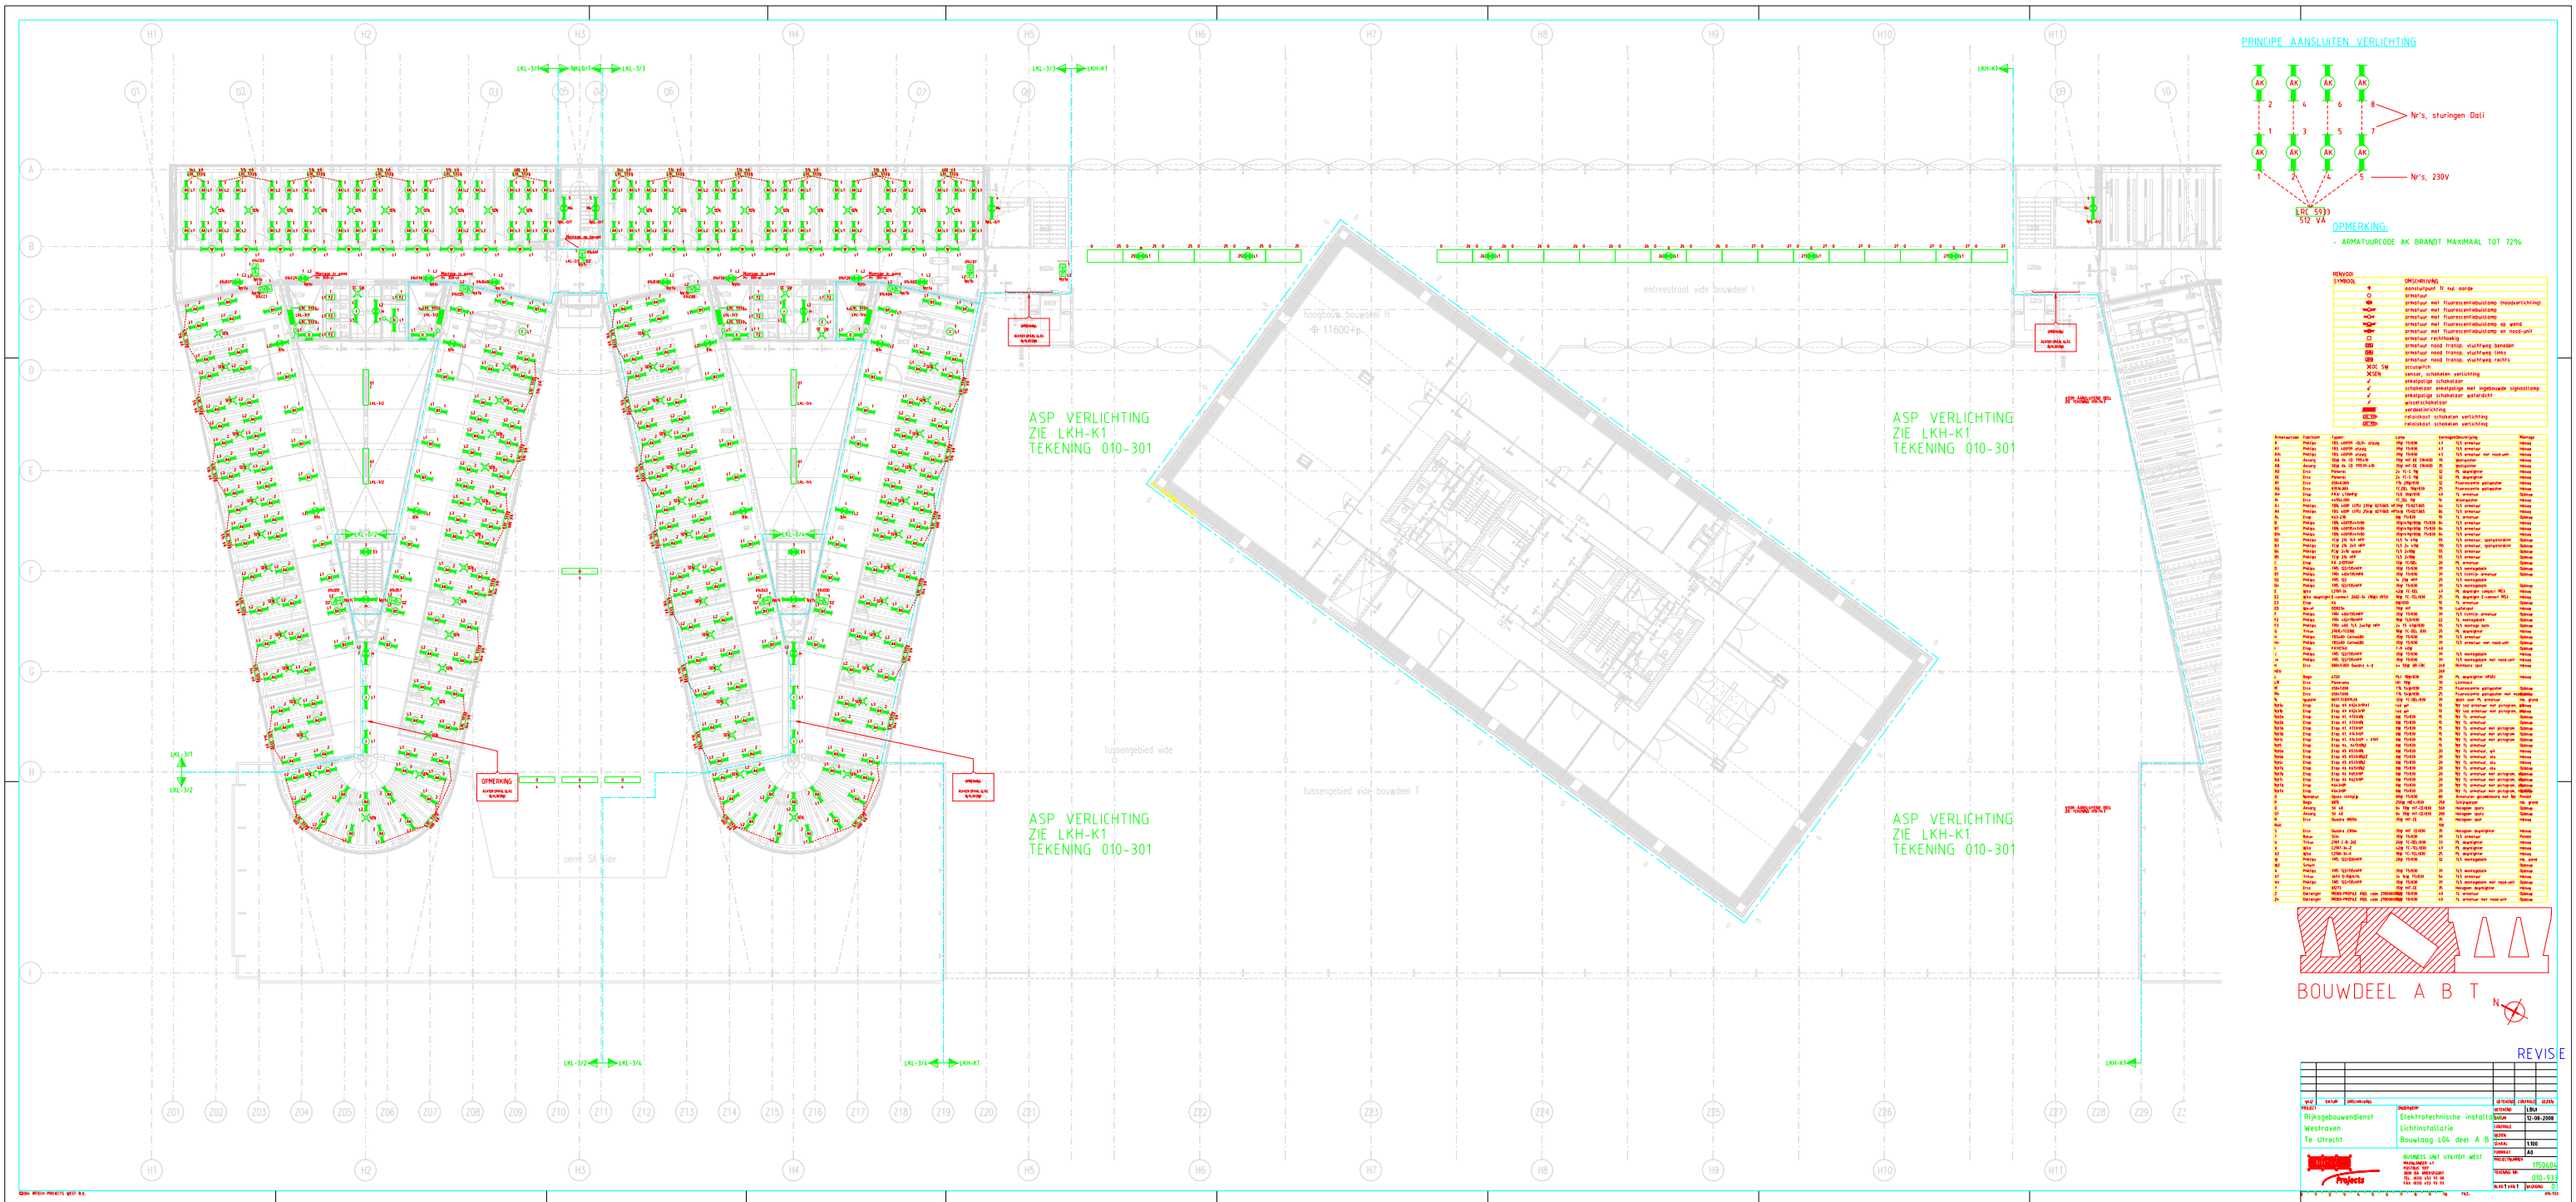

PRINCIP AANSluiten VERLICHTING

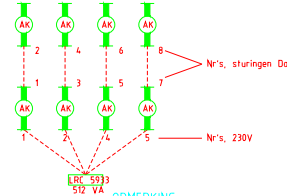

OPMERKING:
- ARMATUURCODE AK BRANDT MAXIMAAL TOT 72%




BOUWDEEL A B T

