





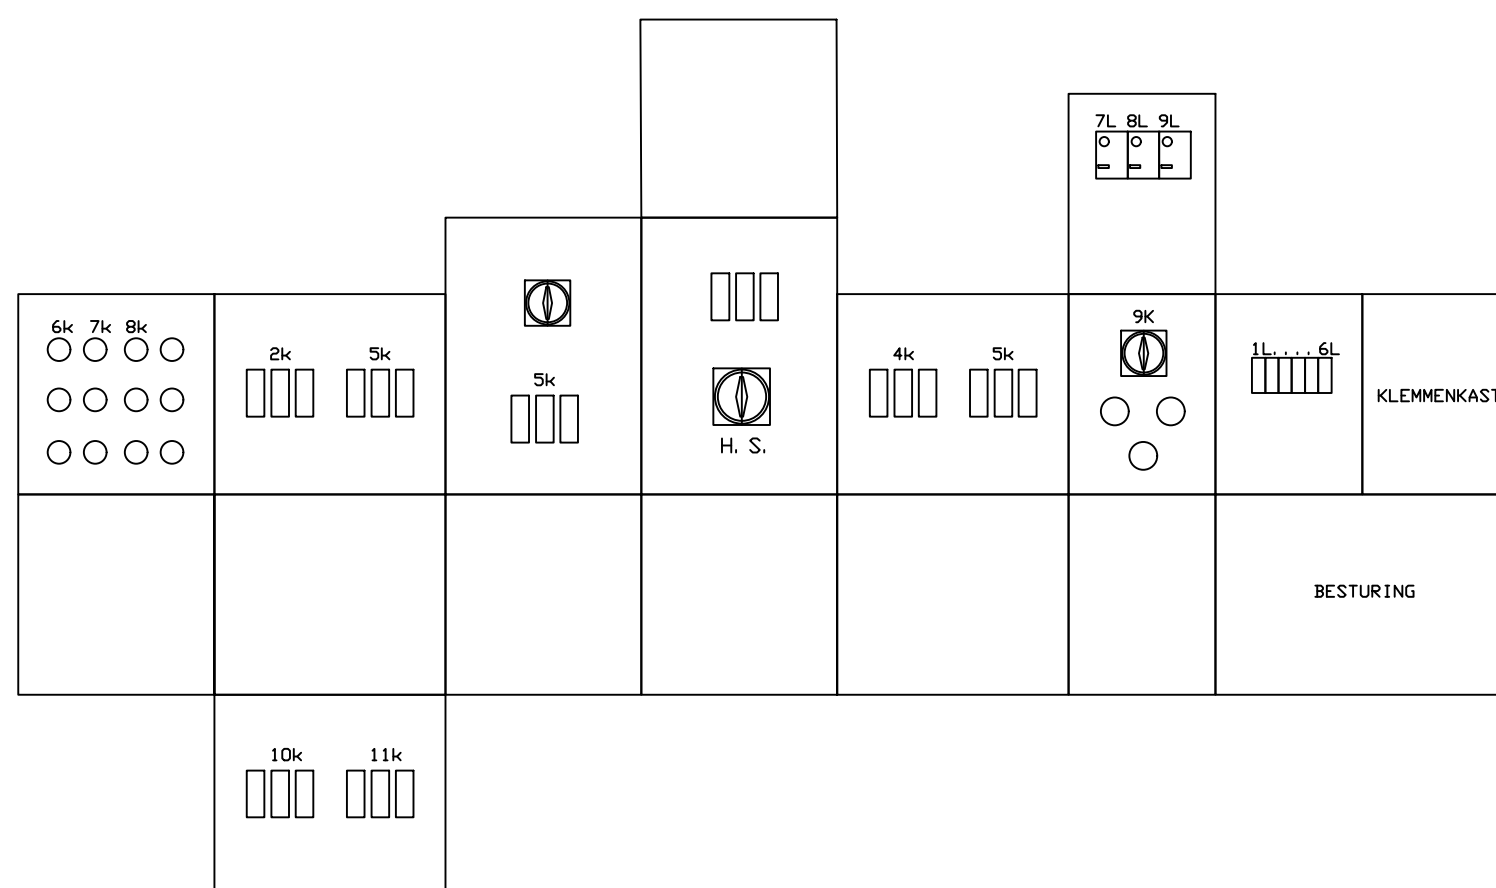

Symbolenlijst

Symbool	Omschrijving
	Armatuur met fluorescentiebuislamp 2x36 W
	Armatuur met invoegpunt aan buitenzijde
	Contactdoos 1-voudig met beschermingscontact, waterdicht
	Contactdoos 3 fasen, nul en beschermingscontact
	Lichtschakelaar, PIR, 180 graden
	Schakelaar. 1-poolig

FIG 1.3.: SYMBOLENLIJST


27B05 LEGERINGSGEBOUW Prinses Margrietkazerne Wezep
Specificatie: ELEKTROTECHISCHE INSTALLATIE Installatietekening Kelder Verlichting + wcd's

Objectnummer: 27B05	Getekend: KVO
Gebouwnummer: 26	Gecontroleerd:
Besteknummer:	Datum: 23-3-2020
Projectnummer:	Schaal: 1:100
Fase: Revisie	Formaat: A2
Versie: A	Documentcode: 27B05 26 E07 VVL K1

 Rijksvastgoedbedrijf Ministerie van Binnenlandse Zaken en Koninkrijksrelaties	Blad: E07 van
	Directie - Vastgoedbeheer www.rijksvastgoedbedrijf.nl 088 115 80 00