


RWZI Tilburg, Lavafilters VBT's

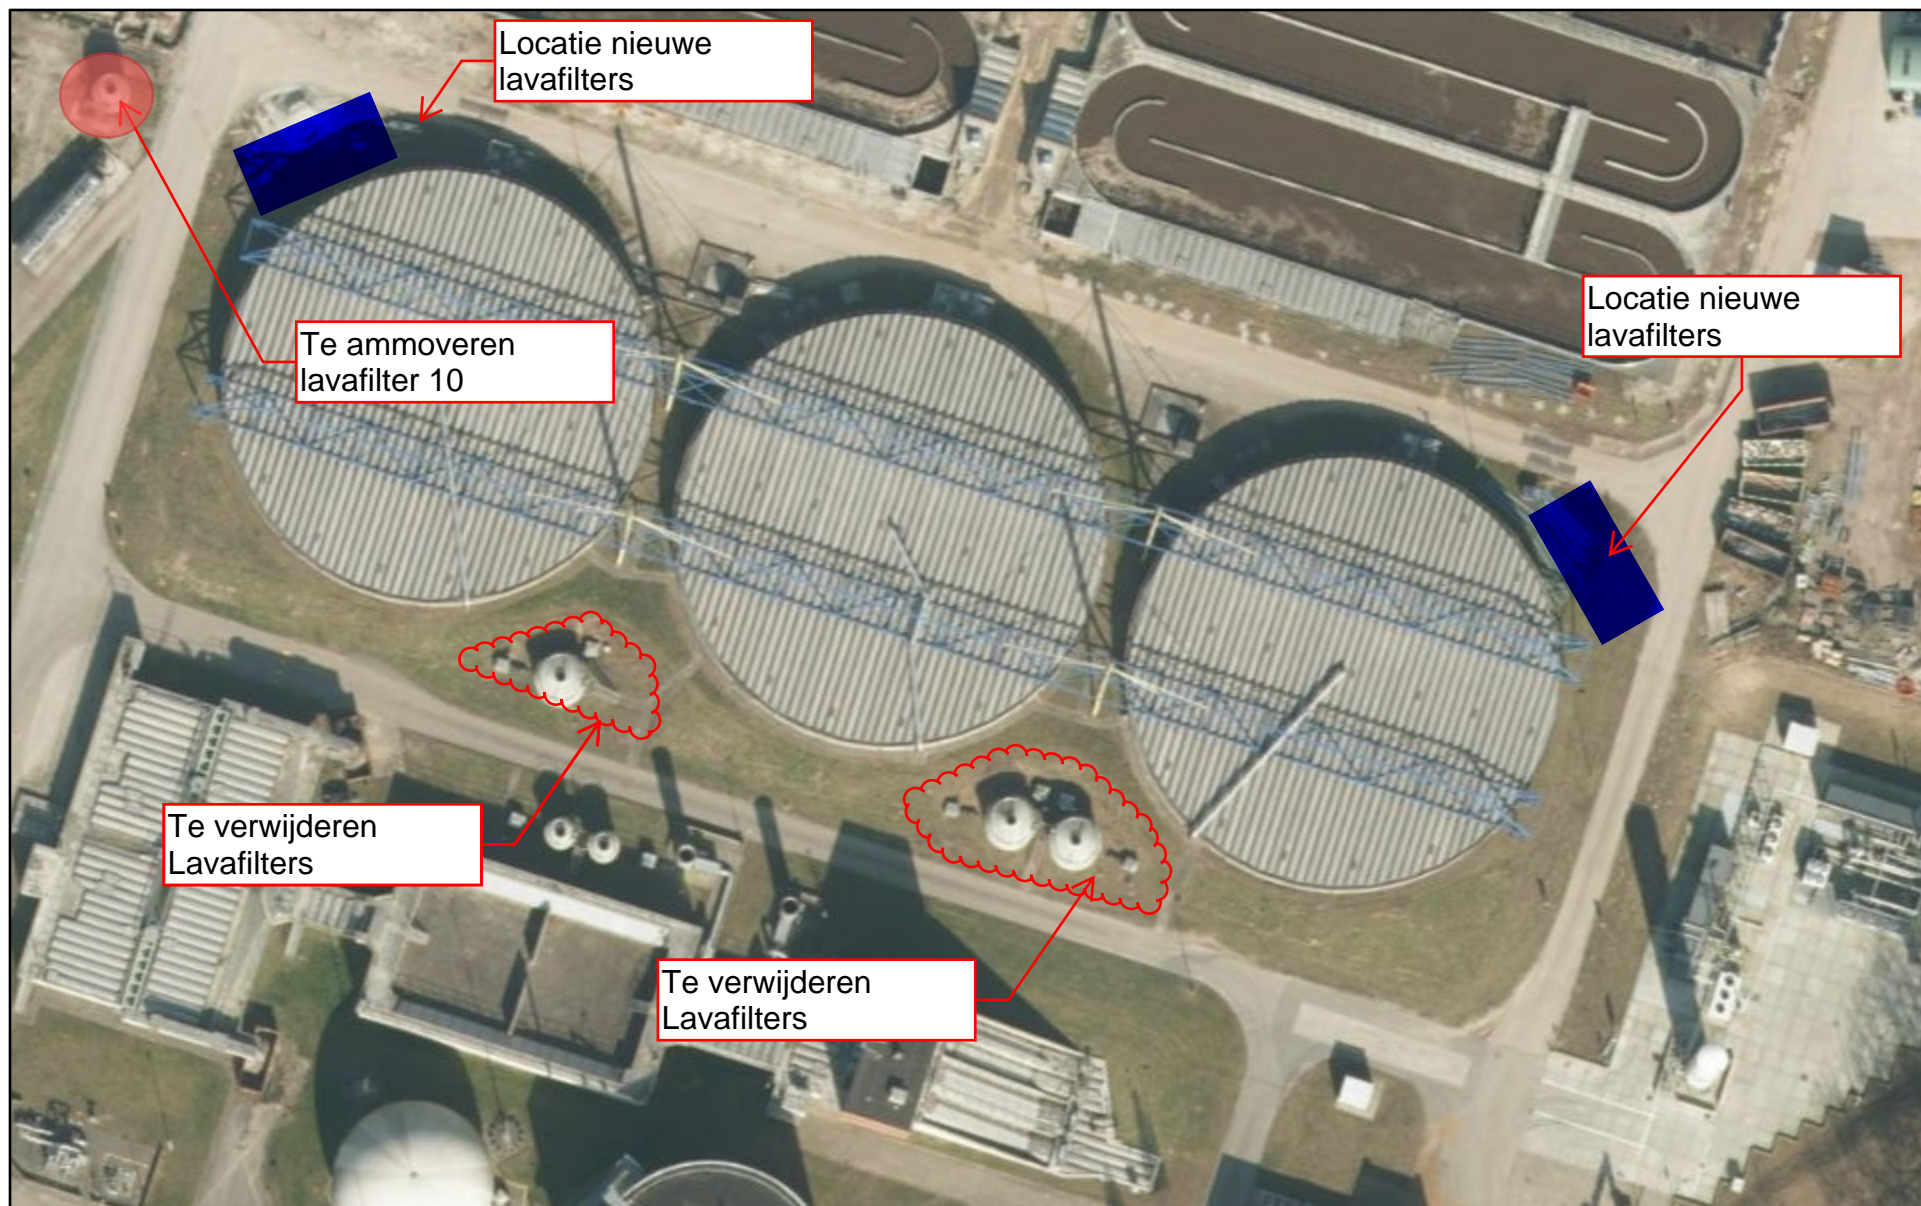

19-1-2026

