


BEGANE GROND

GO BLOK C BEGANEGROND		
Number	Name	Area
C_0.1	Room	140.73
C_0.2	Room	9.39
C_0.3	Room	4.86
C_0.4	Room	2.42
C_0.5	Room	13.21
C_0.6	Room	19.03
C_0.7	Overdekt buiten	44.50
C_0.8	Trap	12.42
C_0.9	Techniek	59.72
C_0.10	Overige	39.39
C_0.11	Overdekt buiten	177.38

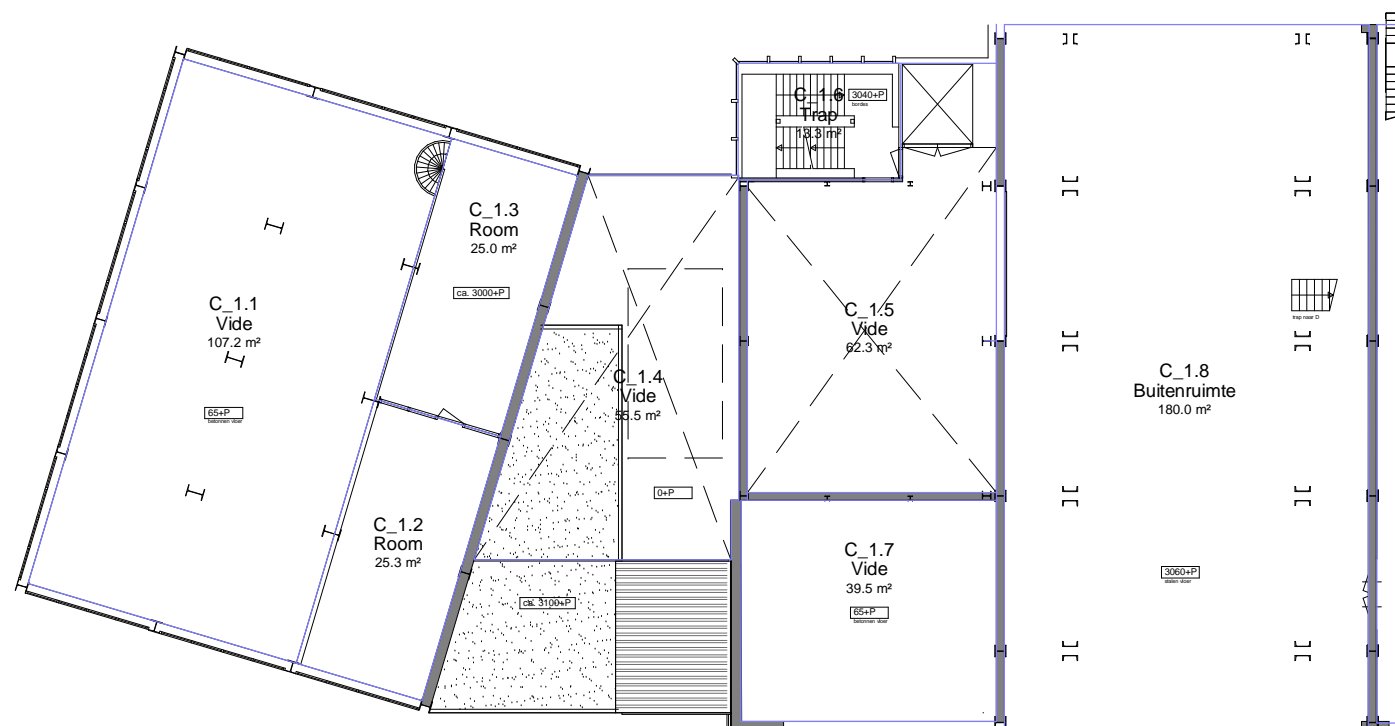

EERSTE VERDIEPING

GO BLOK C 1E VERD		
Number	Name	Area
C_1.1	Vide	107.21
C_1.2	Room	25.31
C_1.3	Room	24.99
C_1.4	Vide	55.53
C_1.5	Vide	62.26
C_1.6	Trap	13.28
C_1.7	Vide	39.50
C_1.8	Buitenruimte	180.00

HET INMETEN EN MODELLEREN VAN DE MENGFABRIEK

GO_C-01

FASE:
BESTAANDE TOESTAND

PROJECTNR:
18-046

FORMAAT:
A3

GEWIJZIGD:
A: 14-05-2019

DATUM:
23-04-2019

SCHAAL:
1:200

B:

ONDERDEEL:
GO BEG.GRND. + 1E
VERD. BLOK C

GETEKEND:
EH

C:
D:
E: