


Eerste verdieping

VVO BLOK C 1E VERD		
Number	Name	Area
OVERDEKT BUITEN-C		
C_1.7	OVERDEKT BUITEN-C	177.52 m²
		177.52 m²
VERKEER VER-C		
C_1.6	VERKEER VER-C	12.66 m²
		12.66 m²
VIDE-C		
C_1.1	VIDE-C	107.41 m²
C_1.4	VIDE-C	35.09 m²
C_1.5	VIDE-C	39.84 m²
		182.33 m²
VVO-C		
C_1.2	VVO-C	25.23 m²
C_1.3	VVO-C	24.98 m²
		50.22 m²
Grand total		422.73 m²

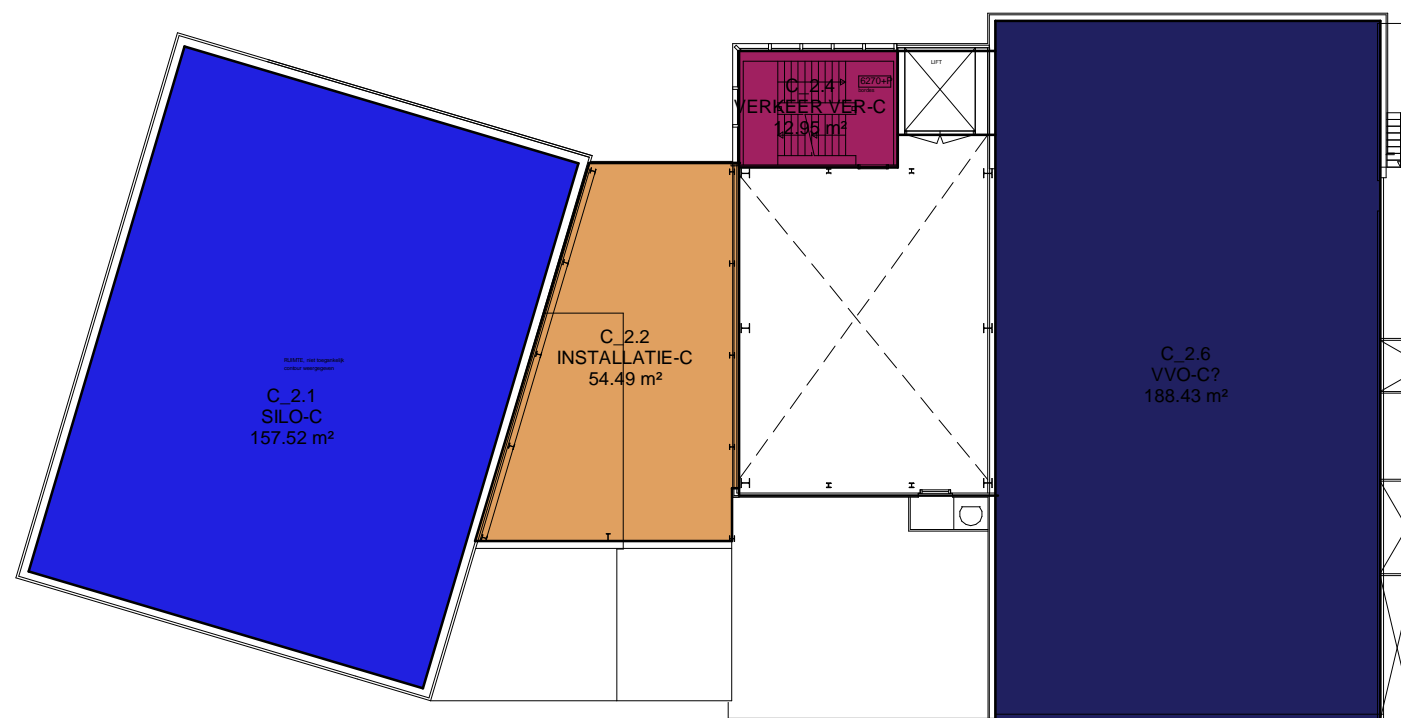

Tweede verdieping

VVO BLOK C 2E VERD		
Number	Name	Area
INSTALLATIE-C		
C_2.2	INSTALLATIE-C	54.49 m²
		54.49 m²
SILO-C		
C_2.1	SILO-C	157.52 m²
		157.52 m²
VERKEER VER-C		
C_2.4	VERKEER VER-C	12.95 m²
C_2.5	VERKEER VER-C	Not Placed
		12.95 m²
VVO-C?		
C_2.3	VVO-C?	Not Placed
C_2.6	VVO-C?	188.43 m²
		188.43 m²
Grand total		413.39 m²

HET INMETEN EN MODELLEREN VAN DE MENGFABRIEK

VVO_C-02

FASE:
BESTAANDE TOESTAND

PROJECTNR:
18-046

FORMAAT:
A3

GEWIJZIGD:
A: 14-05-2019

ONDERDEEL:
VVO 1E EN 2E
VERDIEPING BLOK C

DATUM:
23-04-2019
GETEKEND:
EH

SCHAAL:
1:200

B:
C:
D:
E:

