


Kelder

BVO BLOK E KELDER		
Number	Name	Area
E_-1.1	BVO-E	333.43 m²
Grand total		333.43 m²

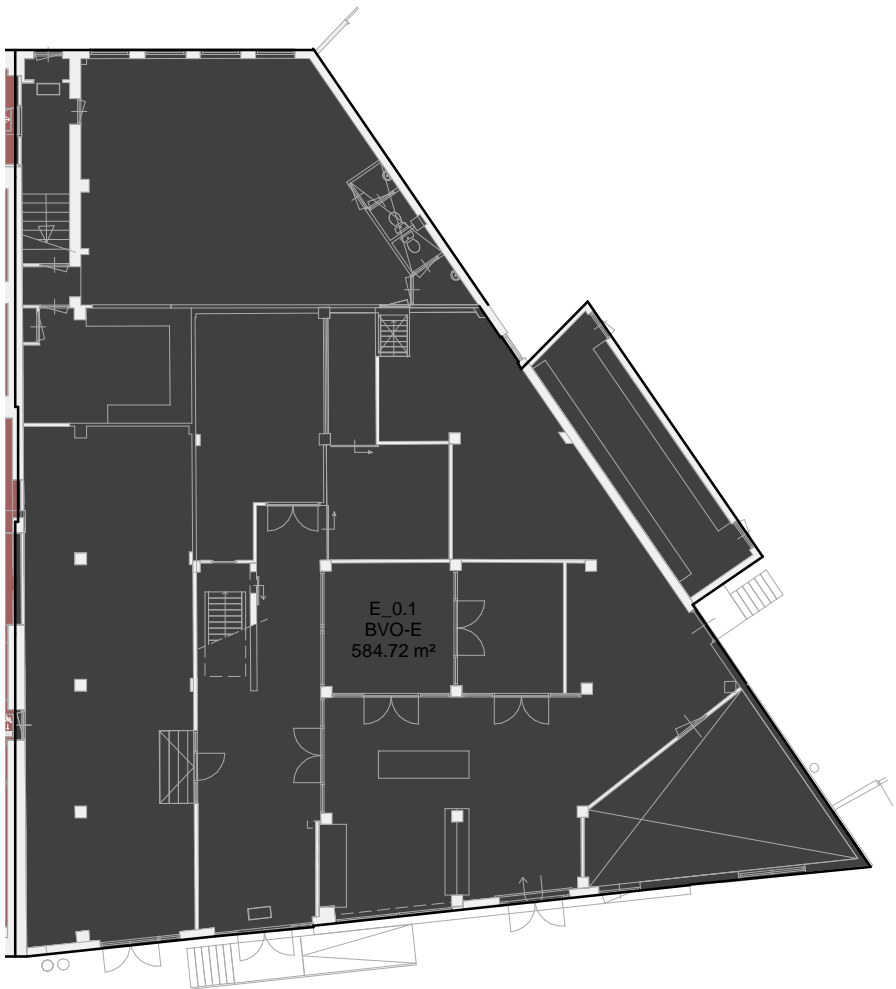

Begane grond

BVO BLOK E BEG. GRND		
Number	Name	Area
E_0.1	BVO-E	584.72 m²
E_0.2	BVO-E BUITEN	53.29 m²
Grand total		638.00 m²



Eerste verdieping

BVO BLOK E 1E VERD		
Number	Name	Area
E_1.1	BVO-E	609.87 m²
Grand total		609.87 m²

BVO BLOK E		
Number	Name	Area
	BVO-E	1528.01 m²
E_0.2	BVO-E BUITEN	53.29 m²
Grand total: 4		1581.30 m²

HET INMETEN EN MODELLEREN VAN DE MENGFABRIEK

BVO\_E-01

FASE:  
BESTAANDE TOESTAND

PROJECTNR:  
18-046

DATUM:  
23-04-2018

GETEKEND:  
EH

ONDERDEEL:  
KELDER/BEGGRND  
BLOK E

FORMAAT:  
A3  
SCHAAL:  
1:200

GEWIJZIGD:  
A: 14-05-2019  
B:  
C:  
D:  
E:

