



**INDELING\_26 08 2025**  
831 + 4 = 835 STOELN

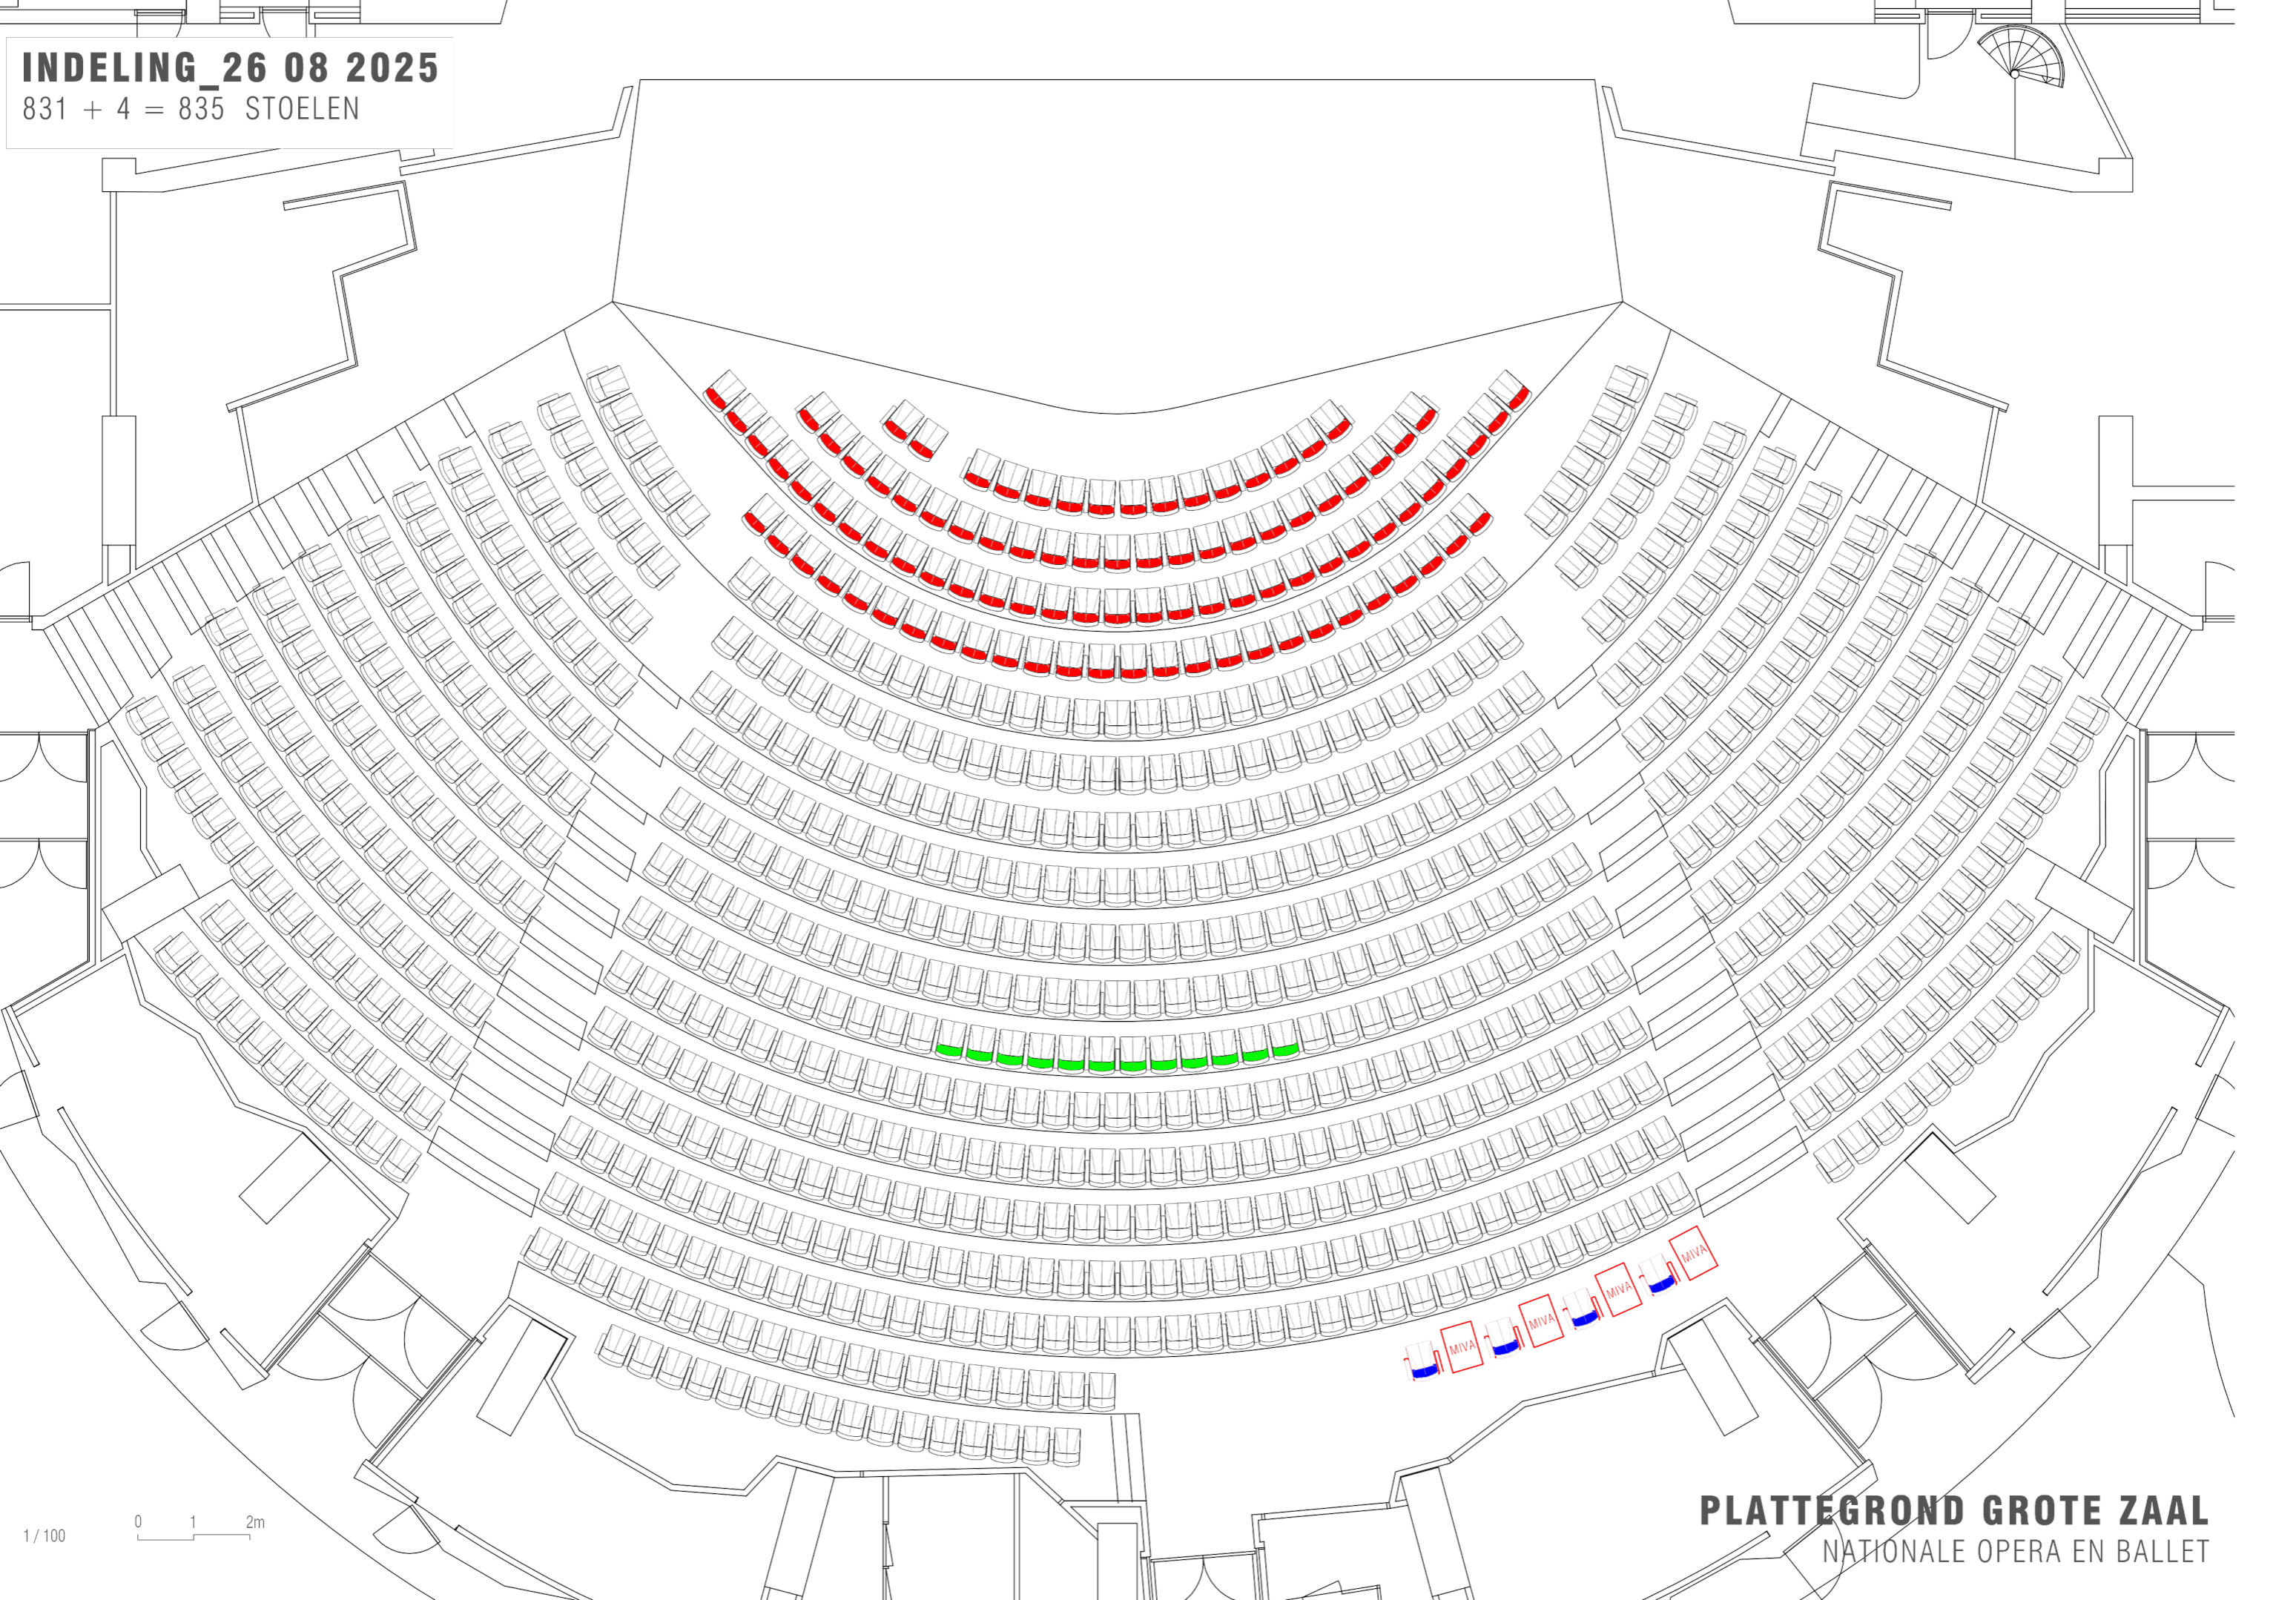

1 / 100  
0 1 2m

**PLATTEGROND GROTE ZAAL**  
NATIONALE OPERA EN BALLET


**INDELING\_26 08 2025**  
410 + 2 = 412 STOELN

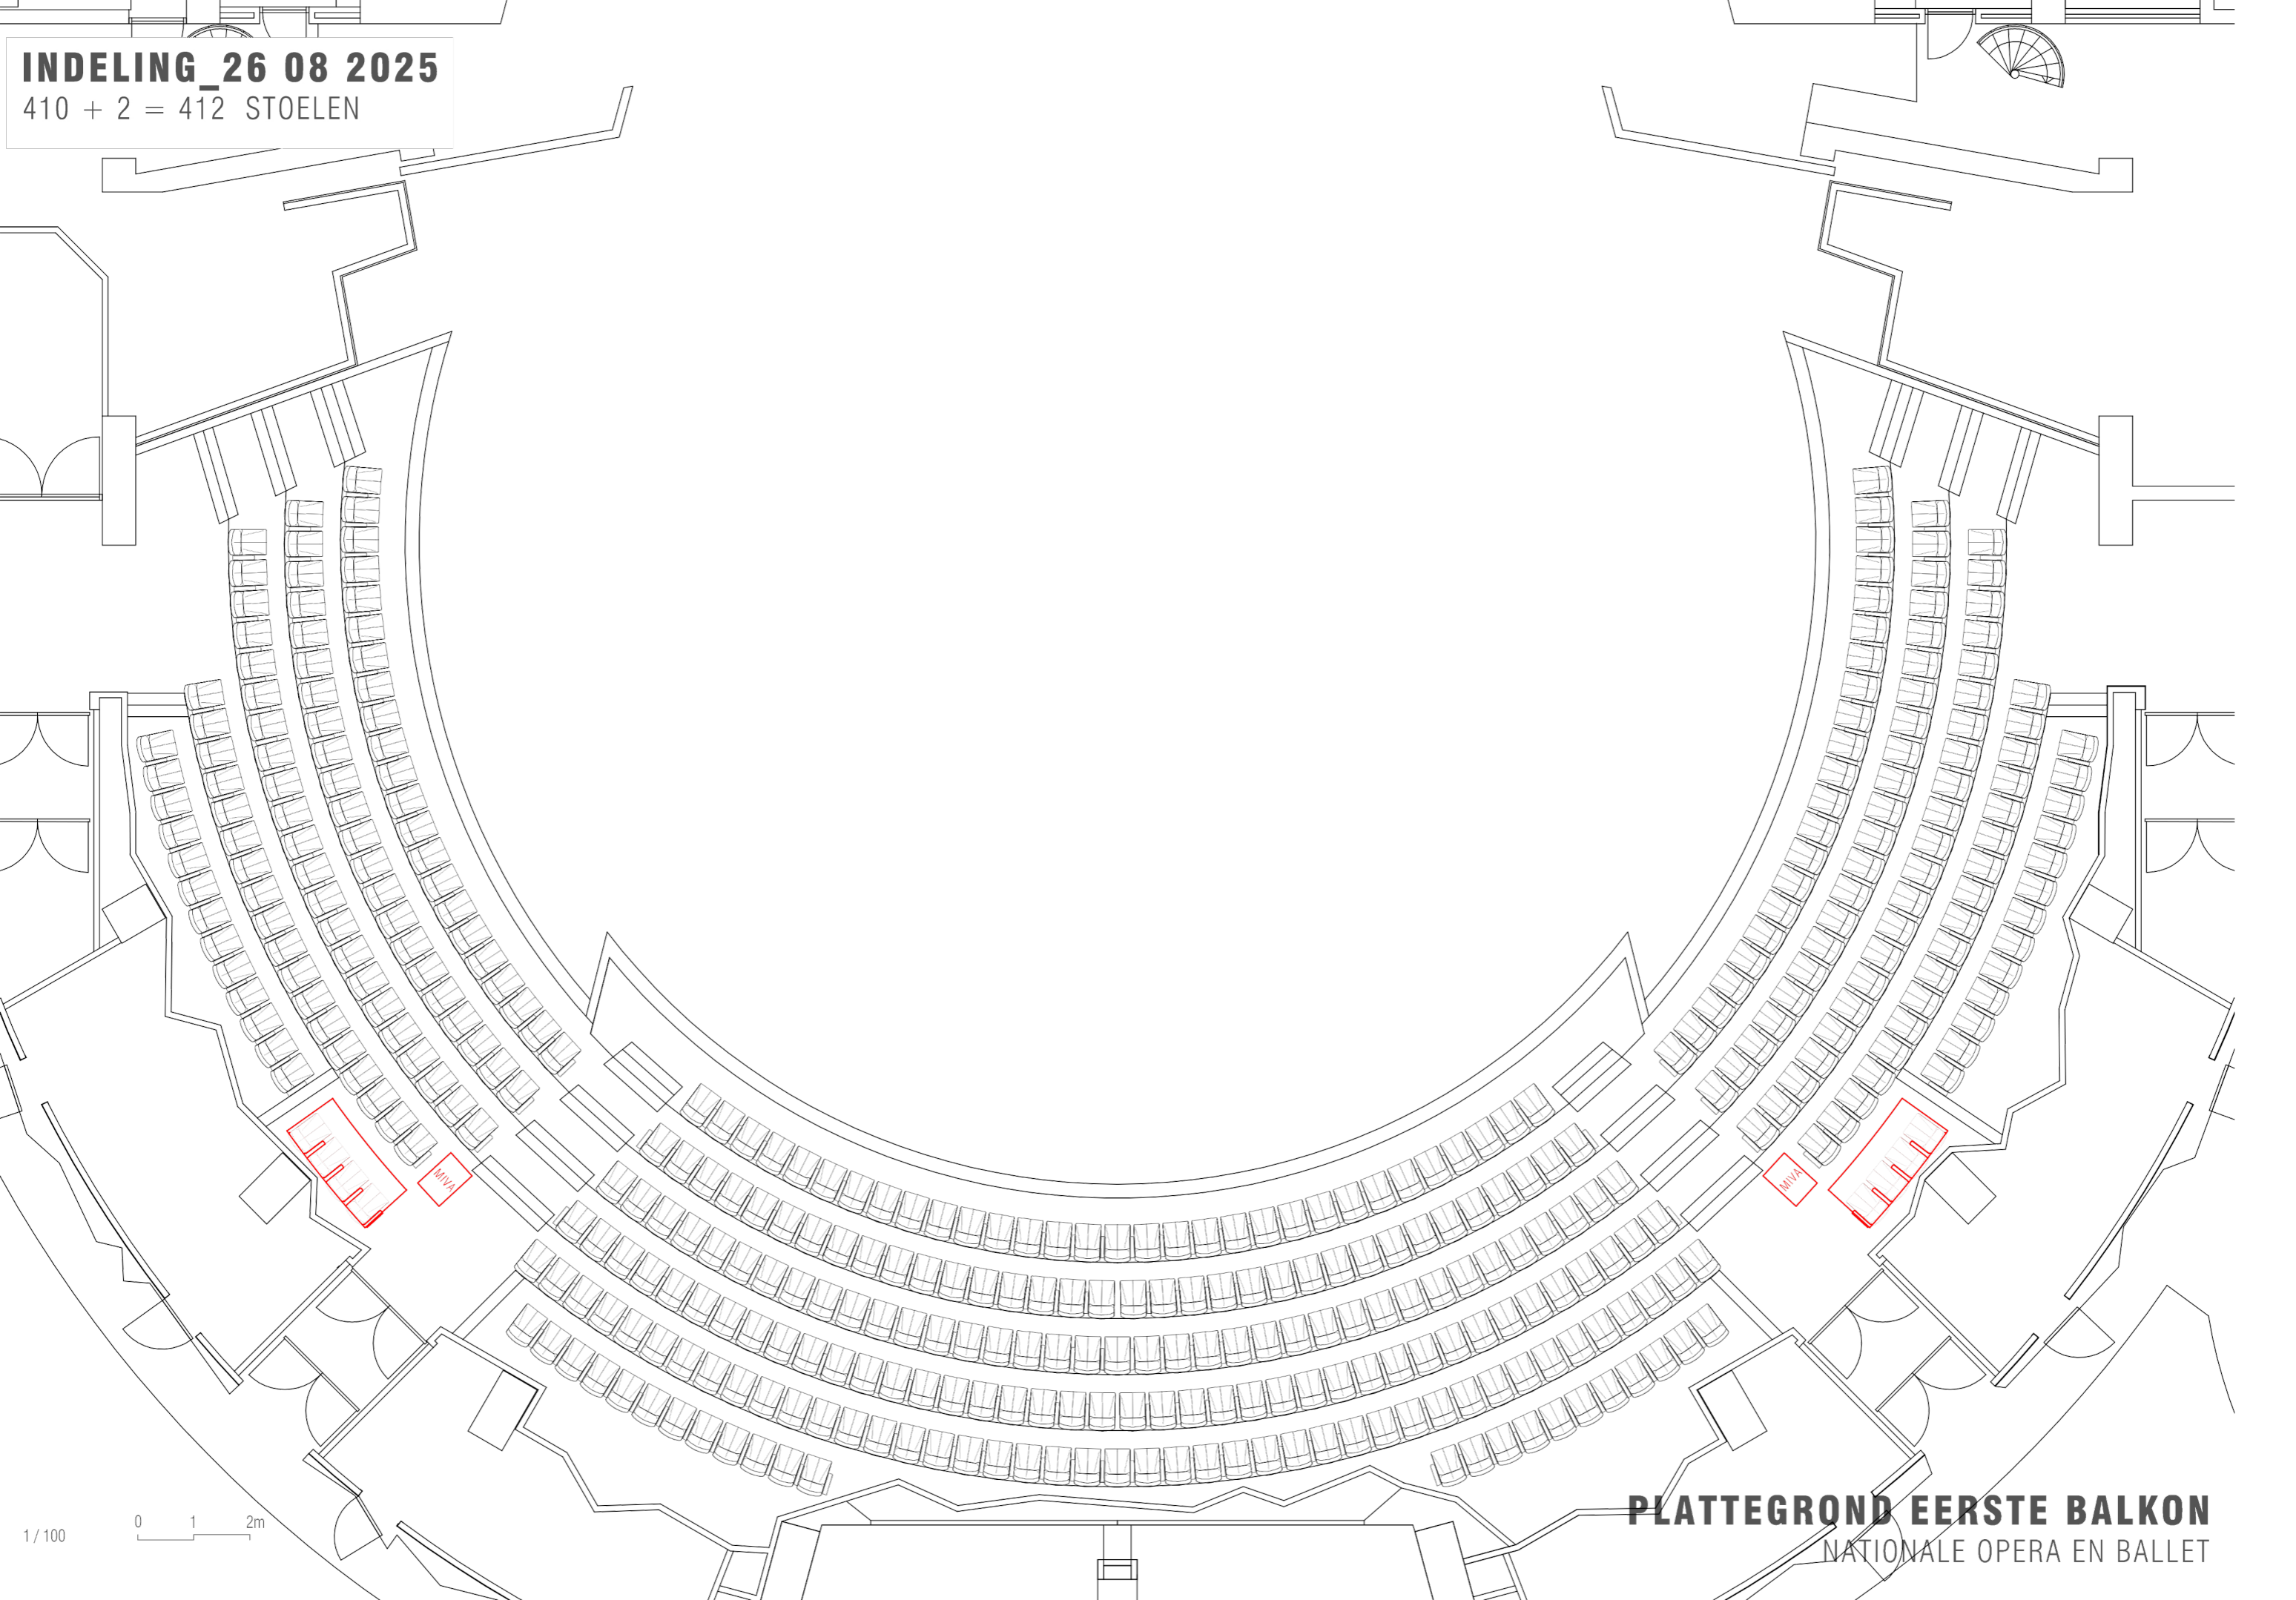

1/100  
0 1 2m

**PLATTEGROND EERSTE BALKON**  
NATIONALE OPERA EN BALLET

**INDELING\_26 08 2025**  
356 + 2 = 358 STOELN

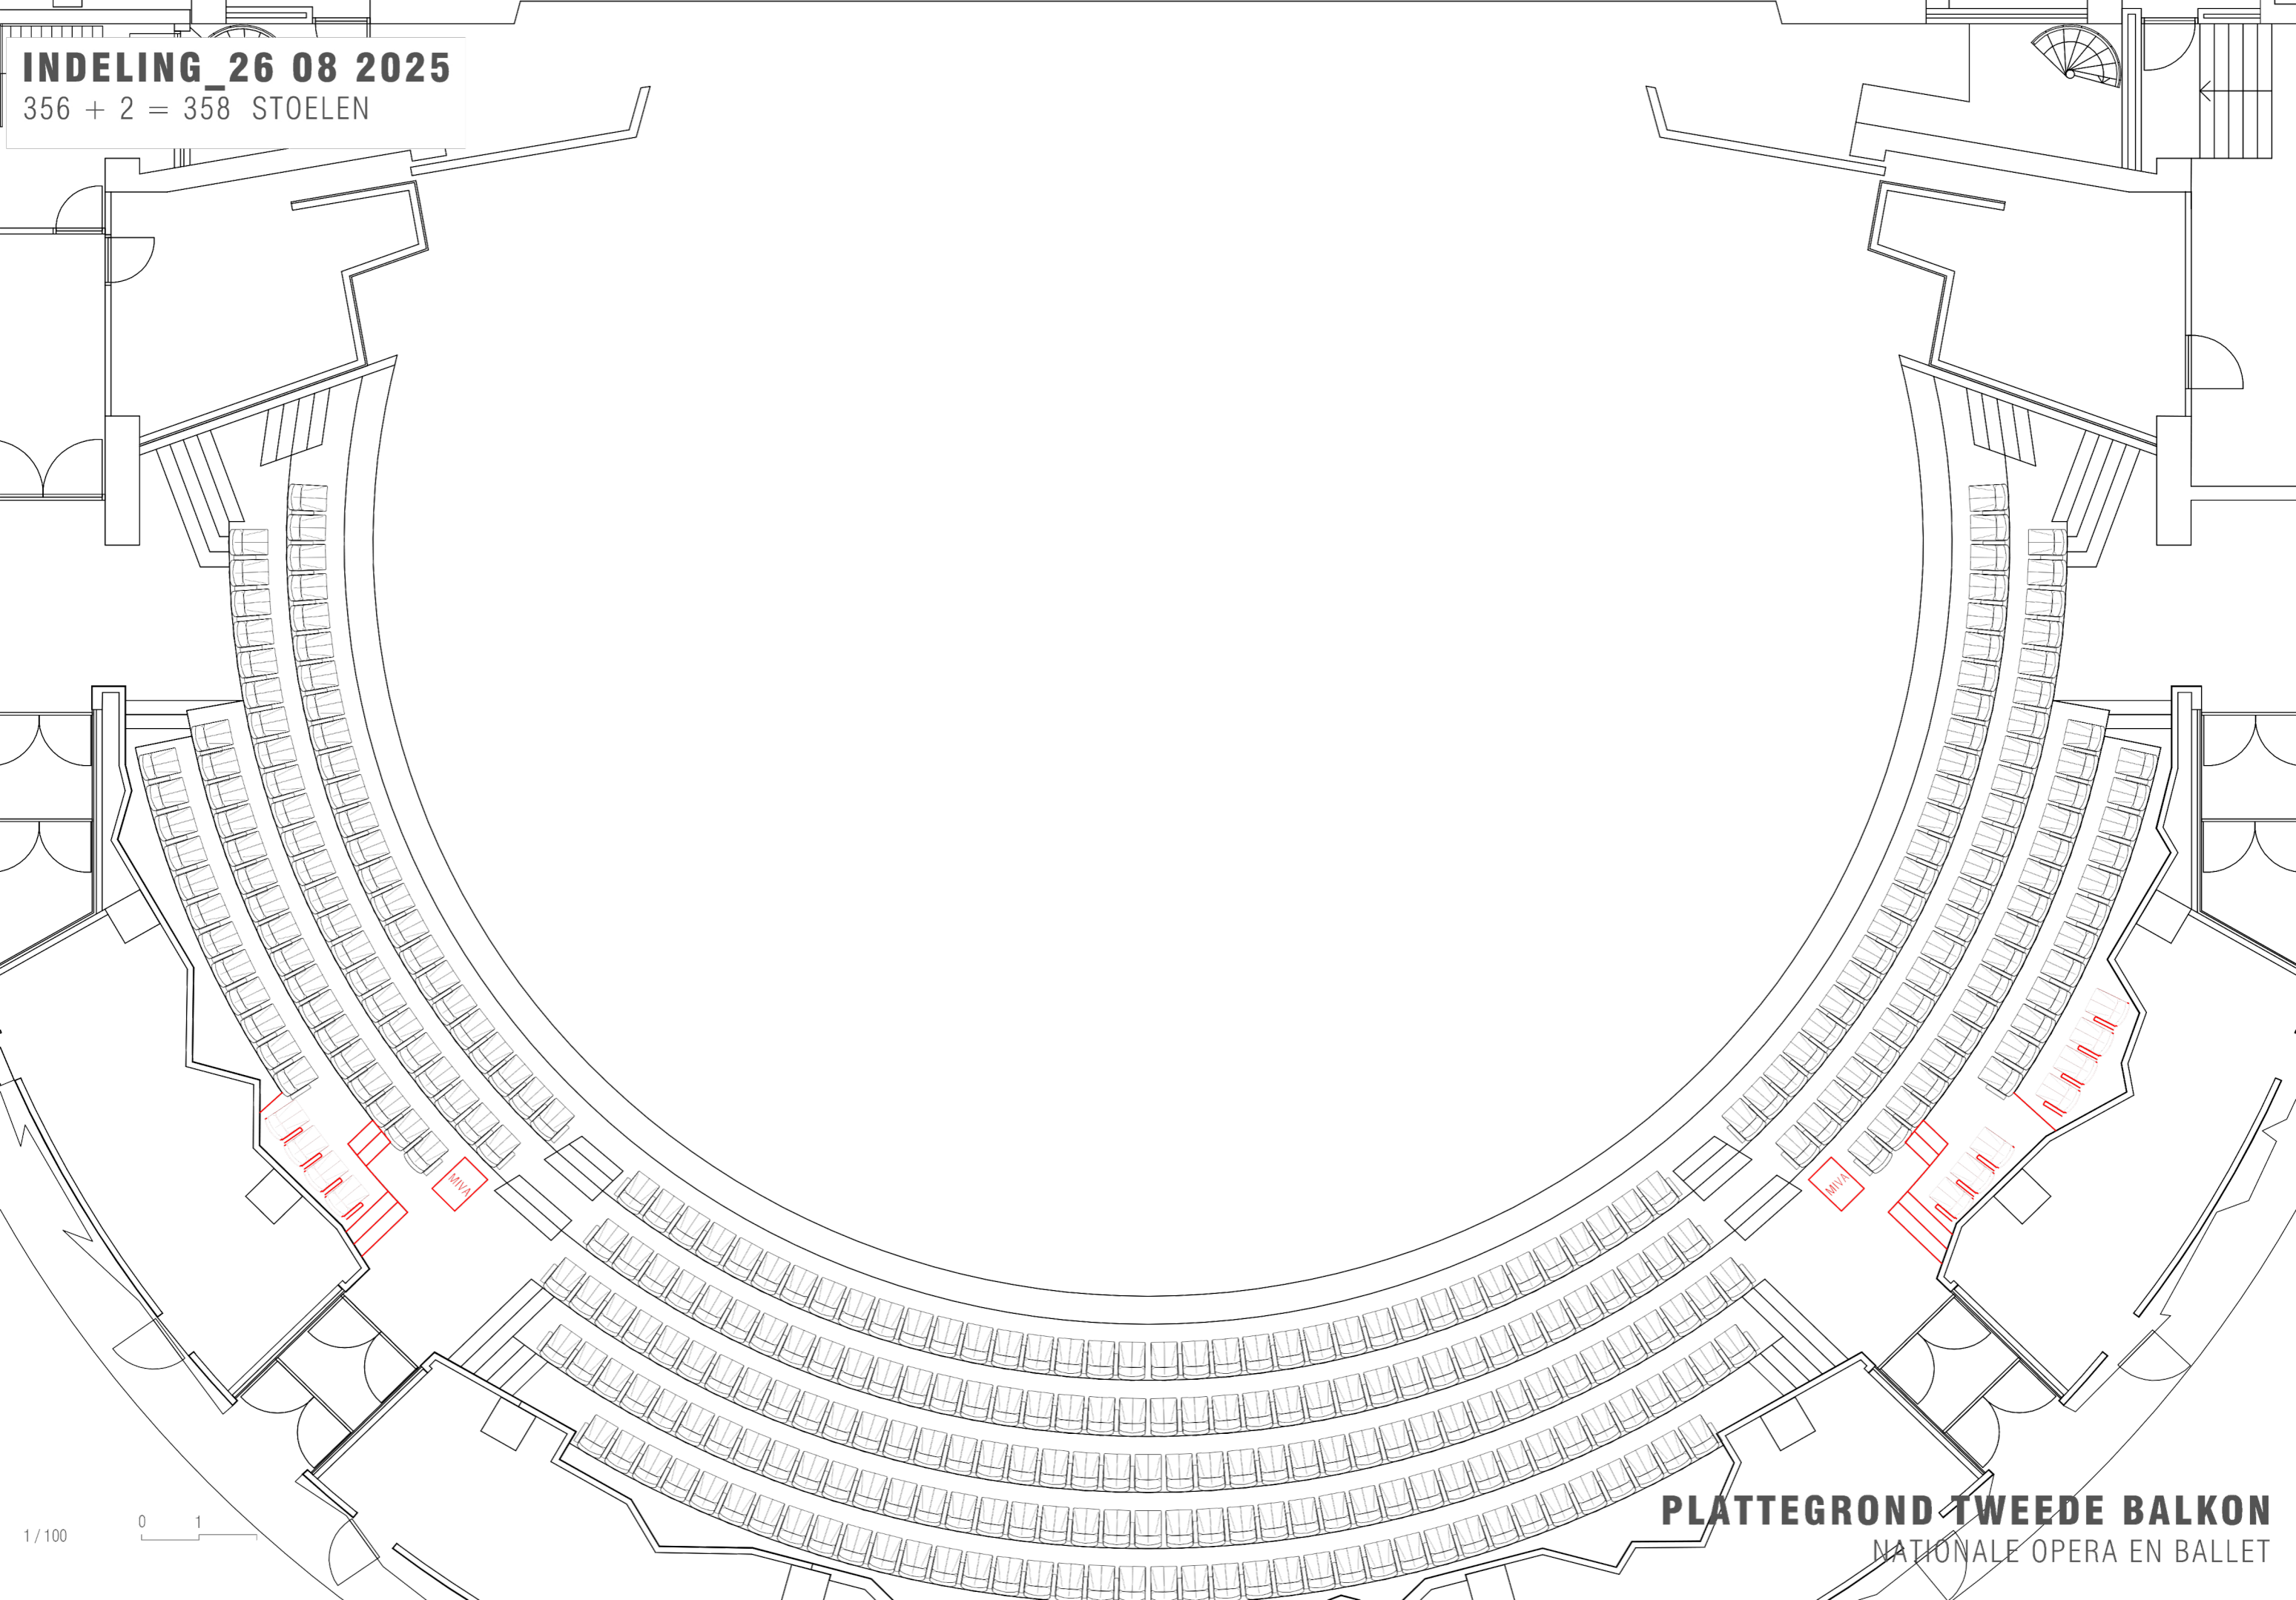

1/100 0 1

**PLATTEGROND TWEEDE BALKON**  
NATIONALE OPERA EN BALLET