



Noordgevel gewijzigd.

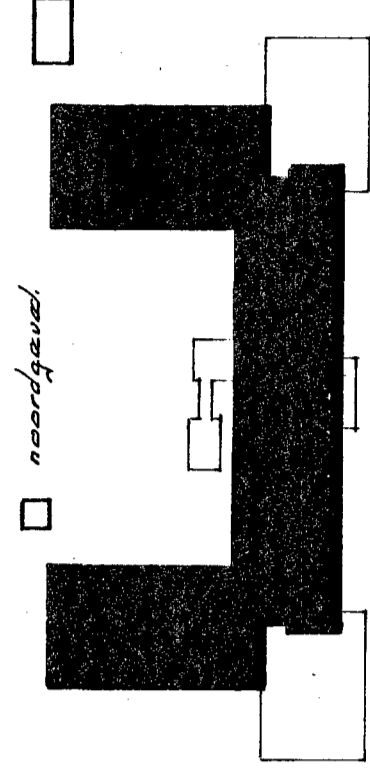

PLAATSE GRONDPLANHOUD

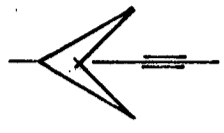

RAADHUIS VOOR DE GEMEENTE RENKUM
 ONDERWERP: NOORDGEVELS
 (GEN. JURGHARTLAAN)
 ARCHITECTEN GRAMPEE MOLLRE EN A.M. VAN COSSIERBERG

DATE GAVT/ST	SCHAAL:
1911	1:1000
1912	1:1000
