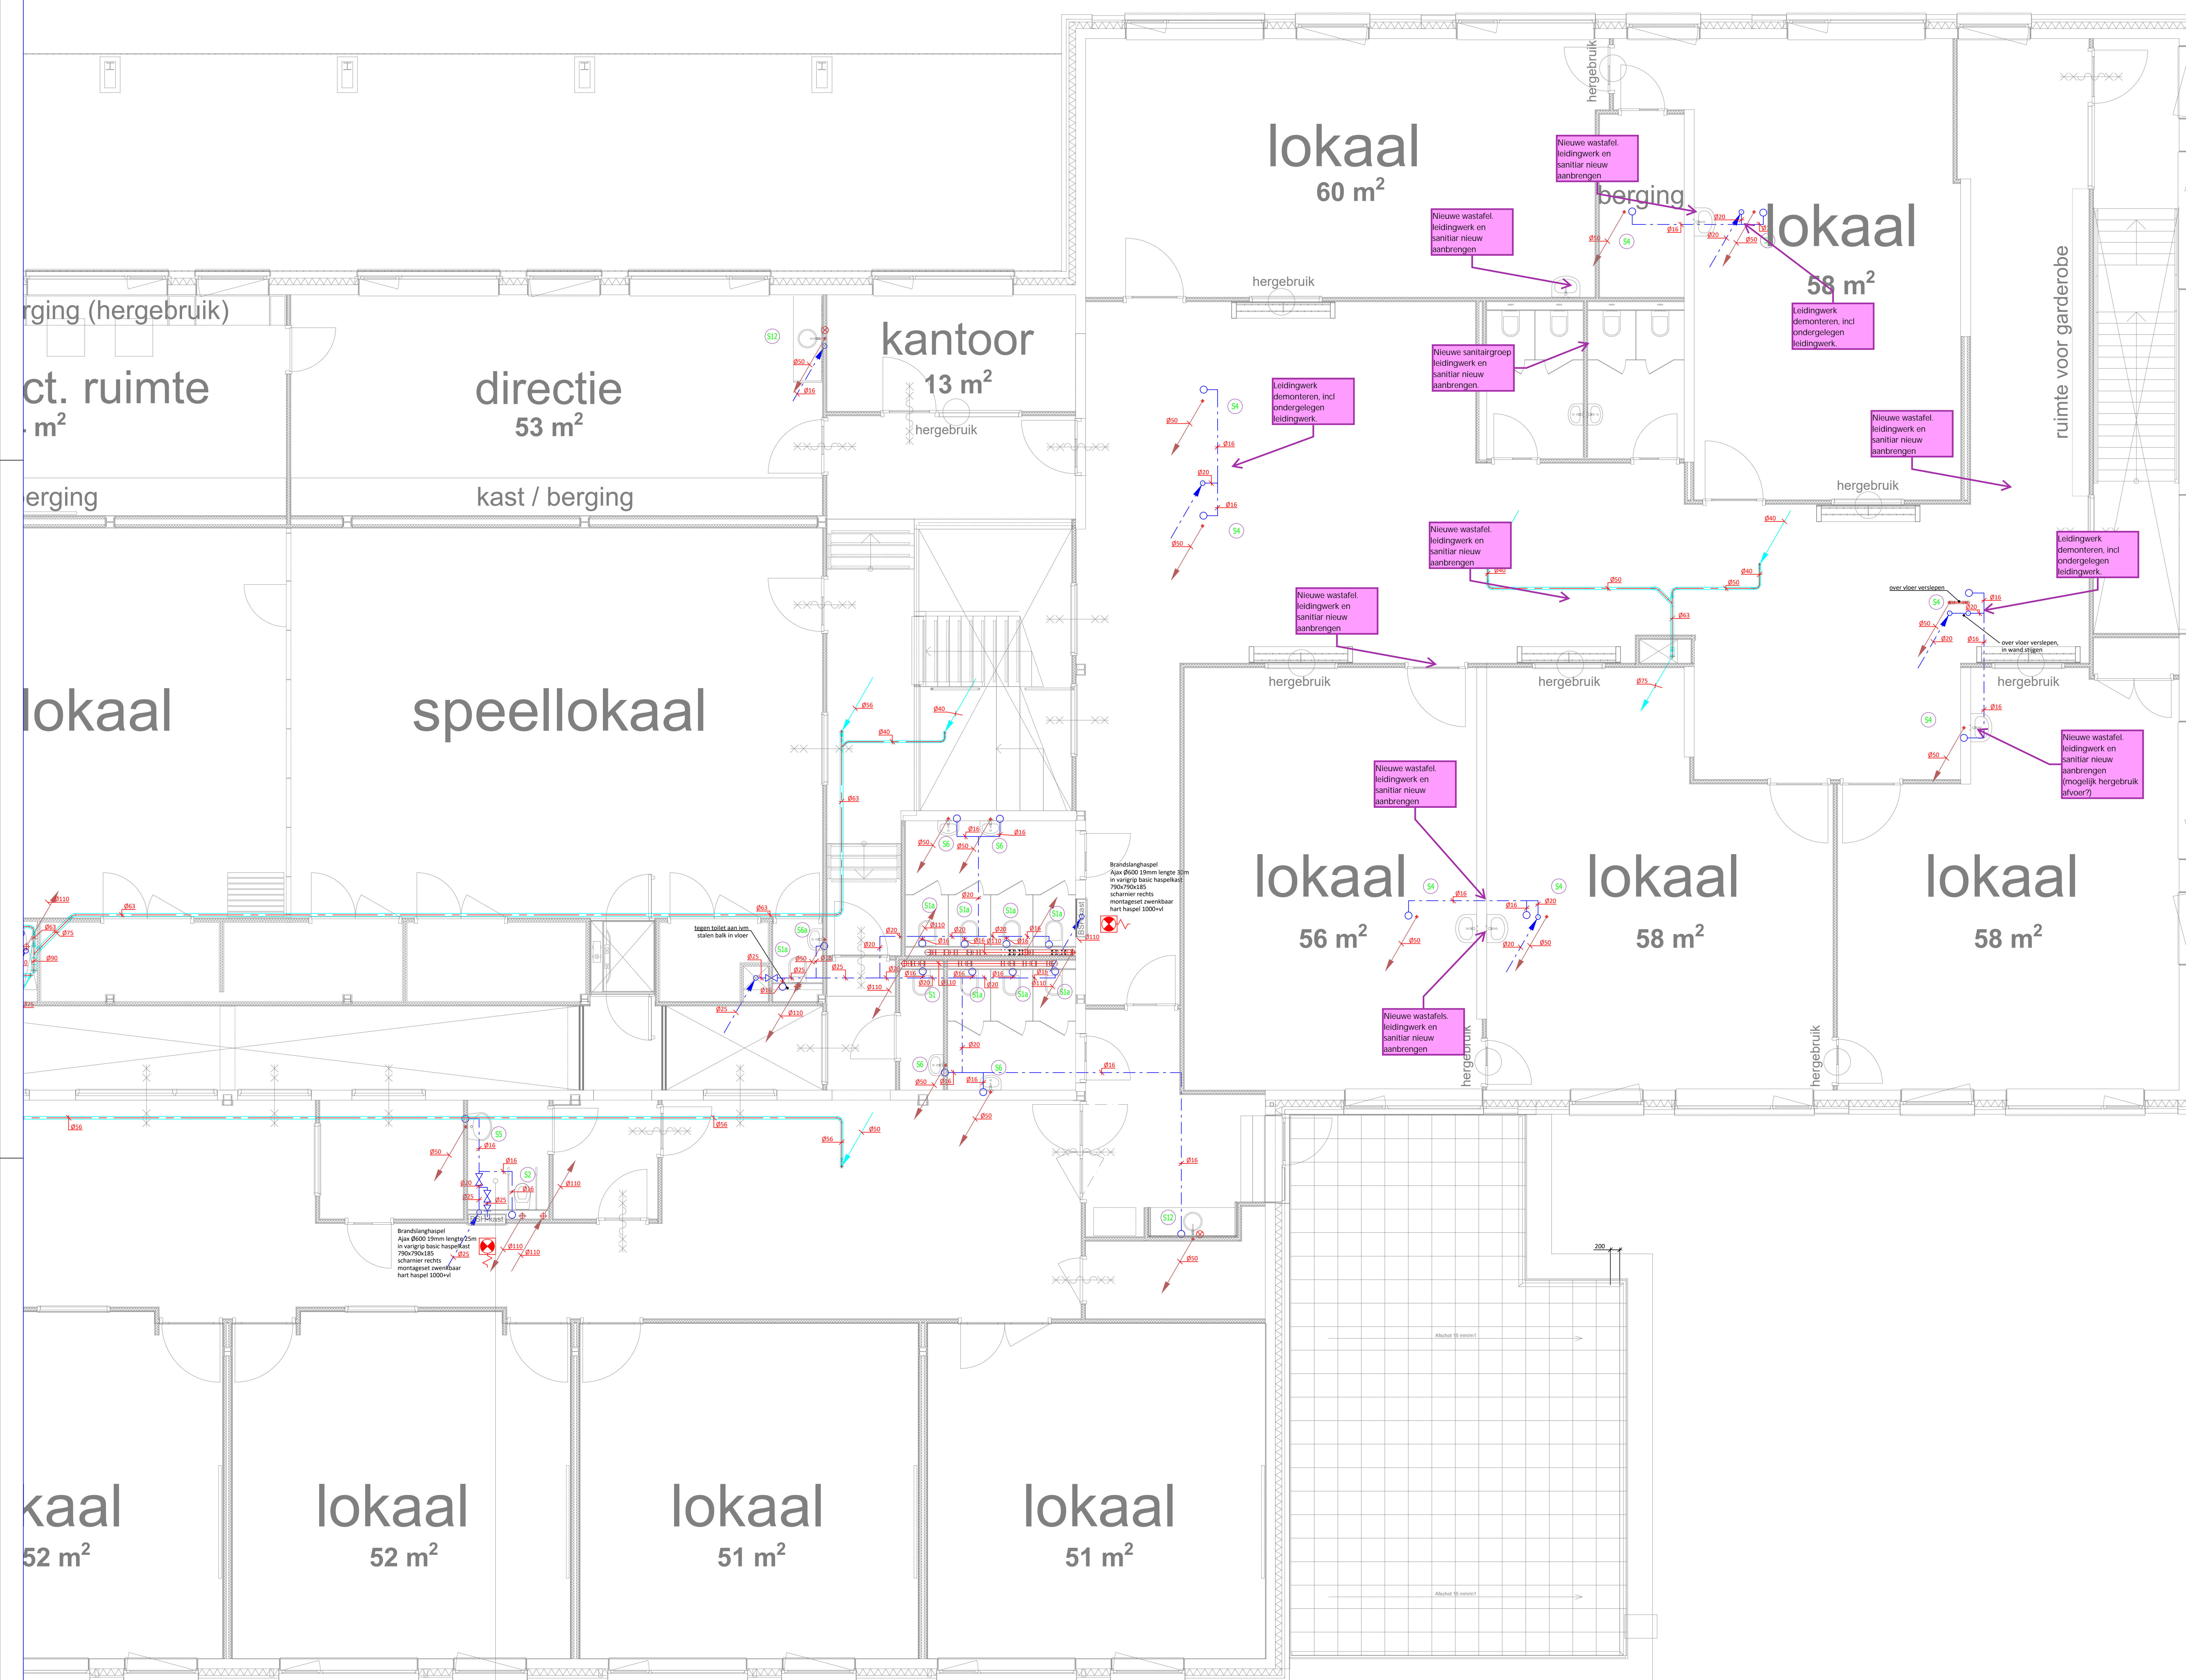


Nieuw

[illegible]