



↑ Hoofte verd. 1.

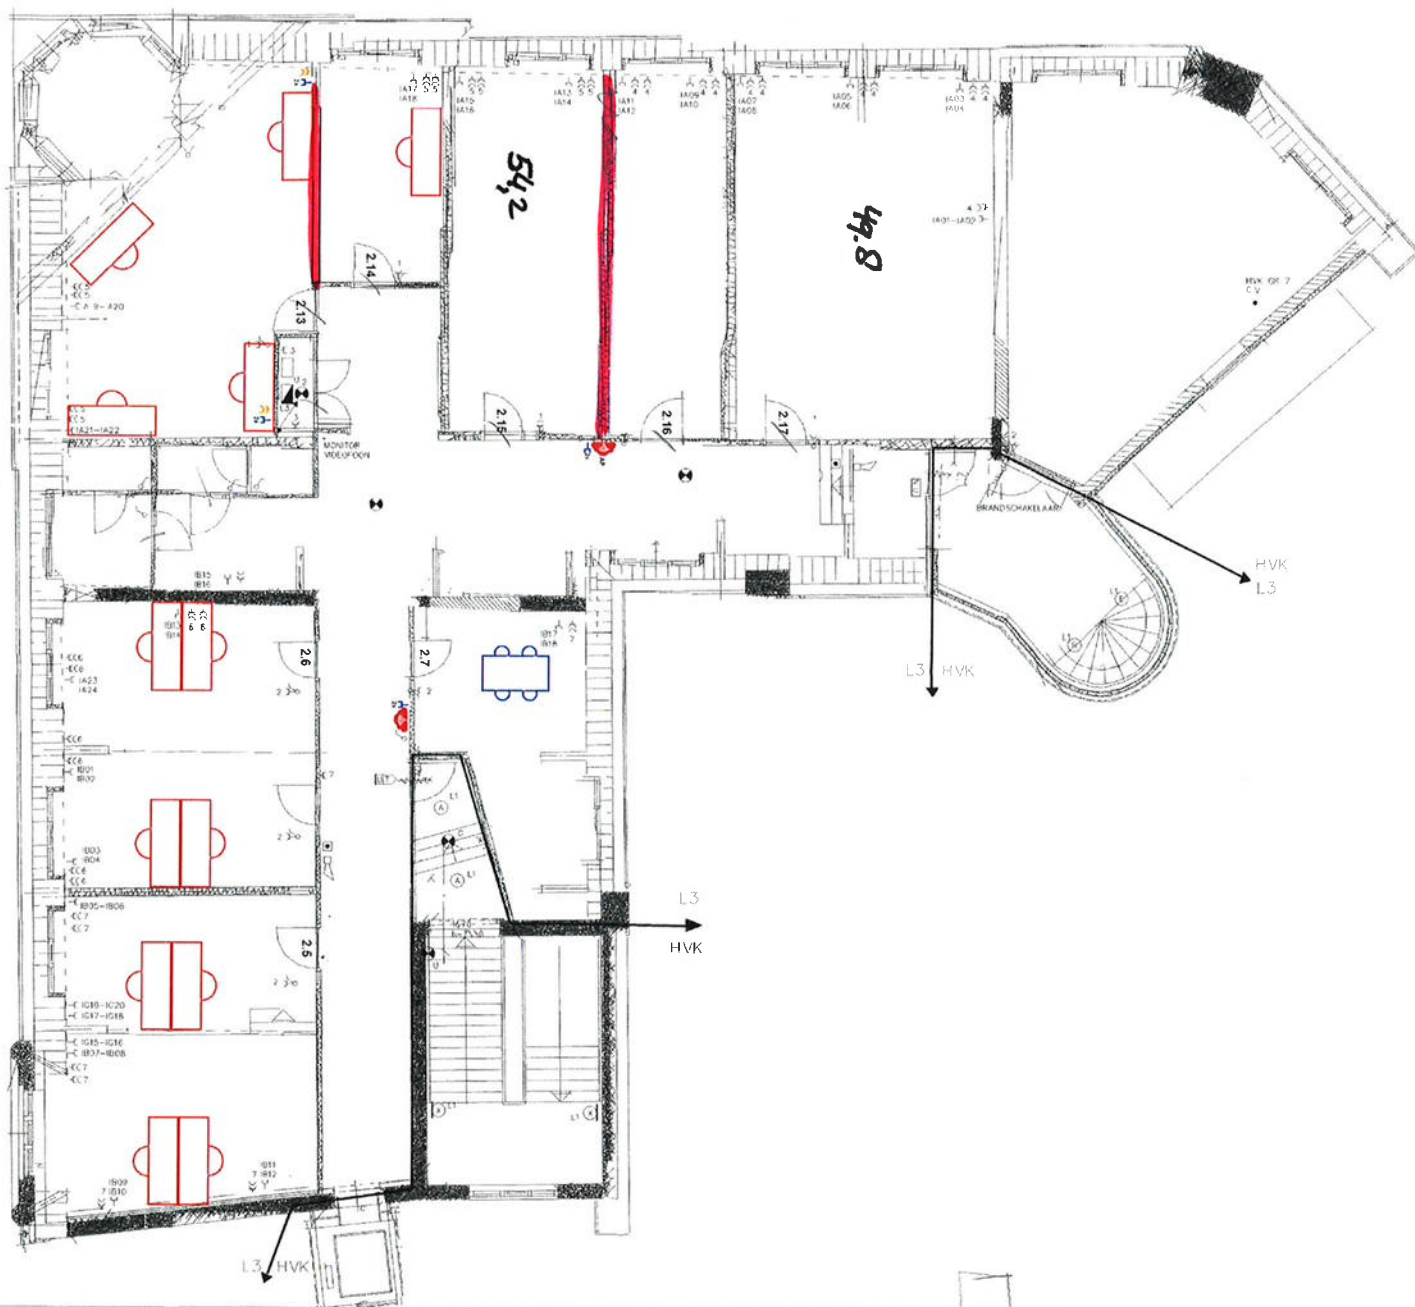

 

100

CHT SCHOOL

...