


KS RVS-DEKSELS
1400 x 800 mm

31810

Detail C

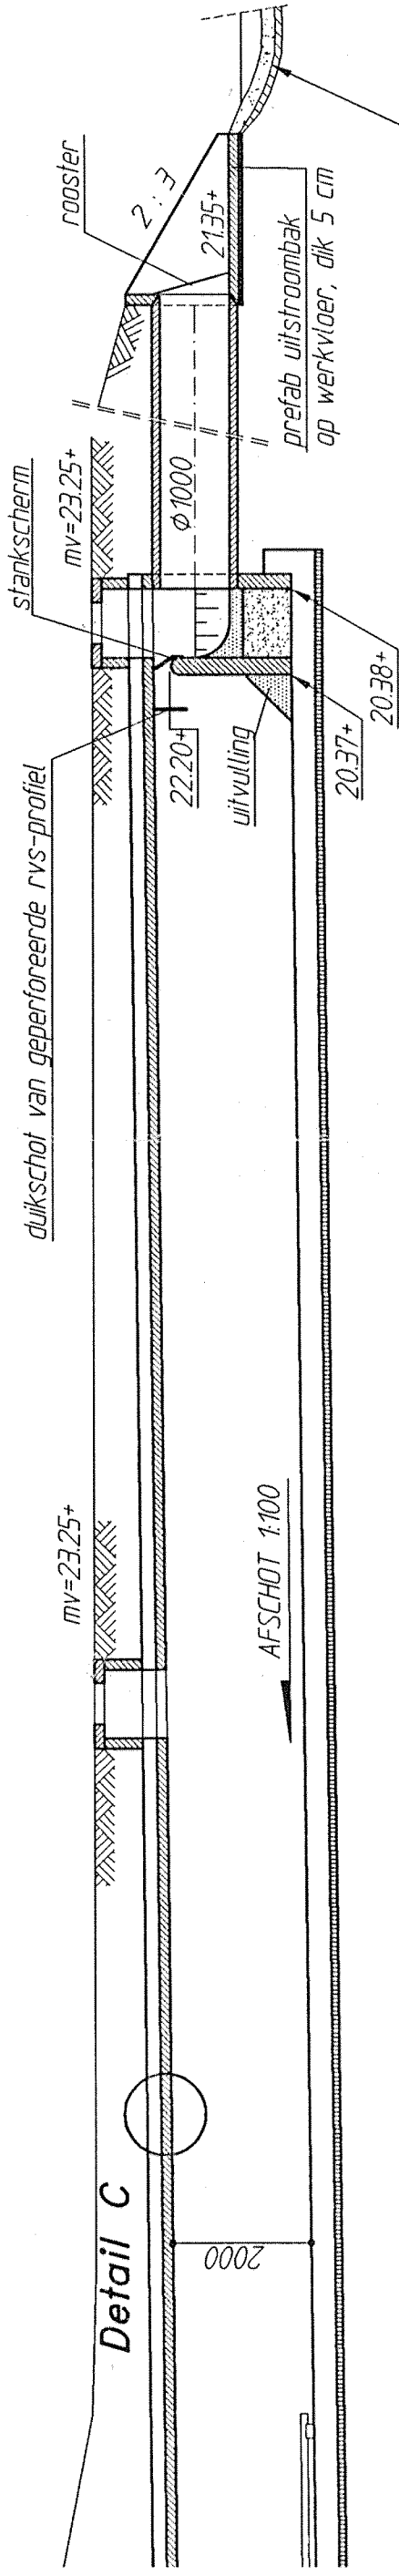

31710

38070

Langsdoorsnede A-A

schaal 1:100

Bodembescherming van 200 mm stortsteen
in 100 mm stampbeton, stortsteen
inwassen met specie

38070

37370

30000

3

4


250
mmen ϕ 250 mm hoh 500 mm

+ NAP

pomp

leemmm

250

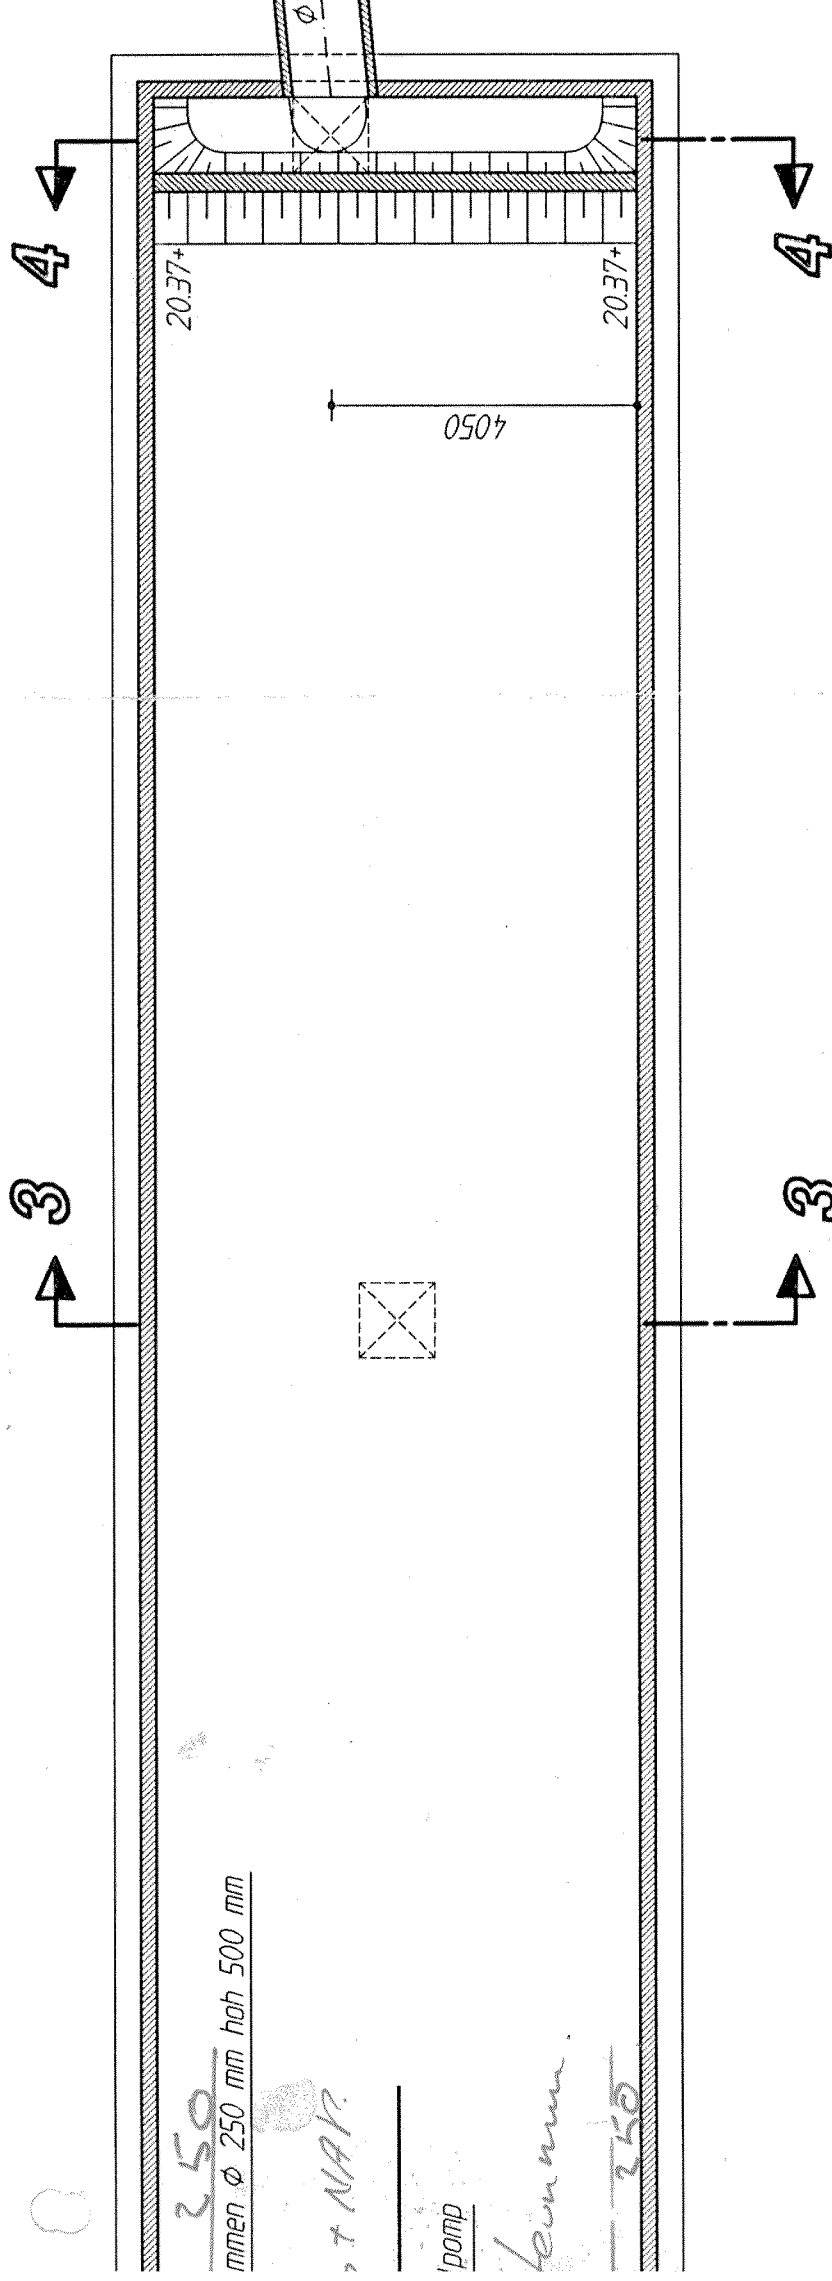

0504

3

4