


Detailtekening

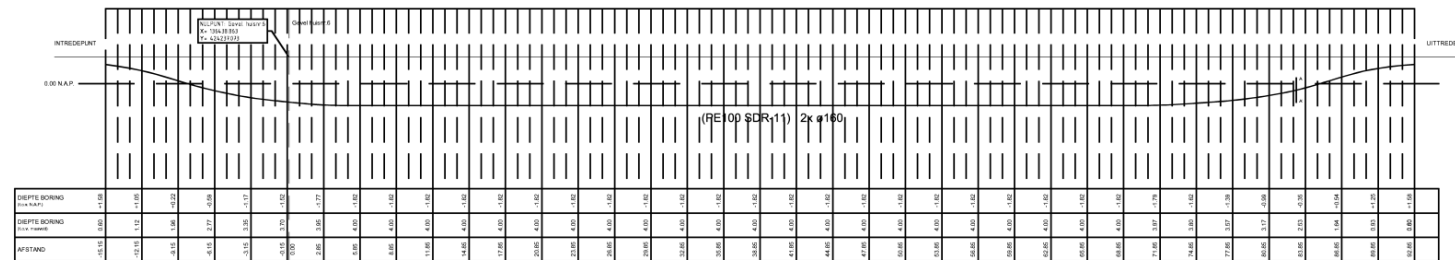



Thema: middenspanning
Tekeningnummer: 950114219