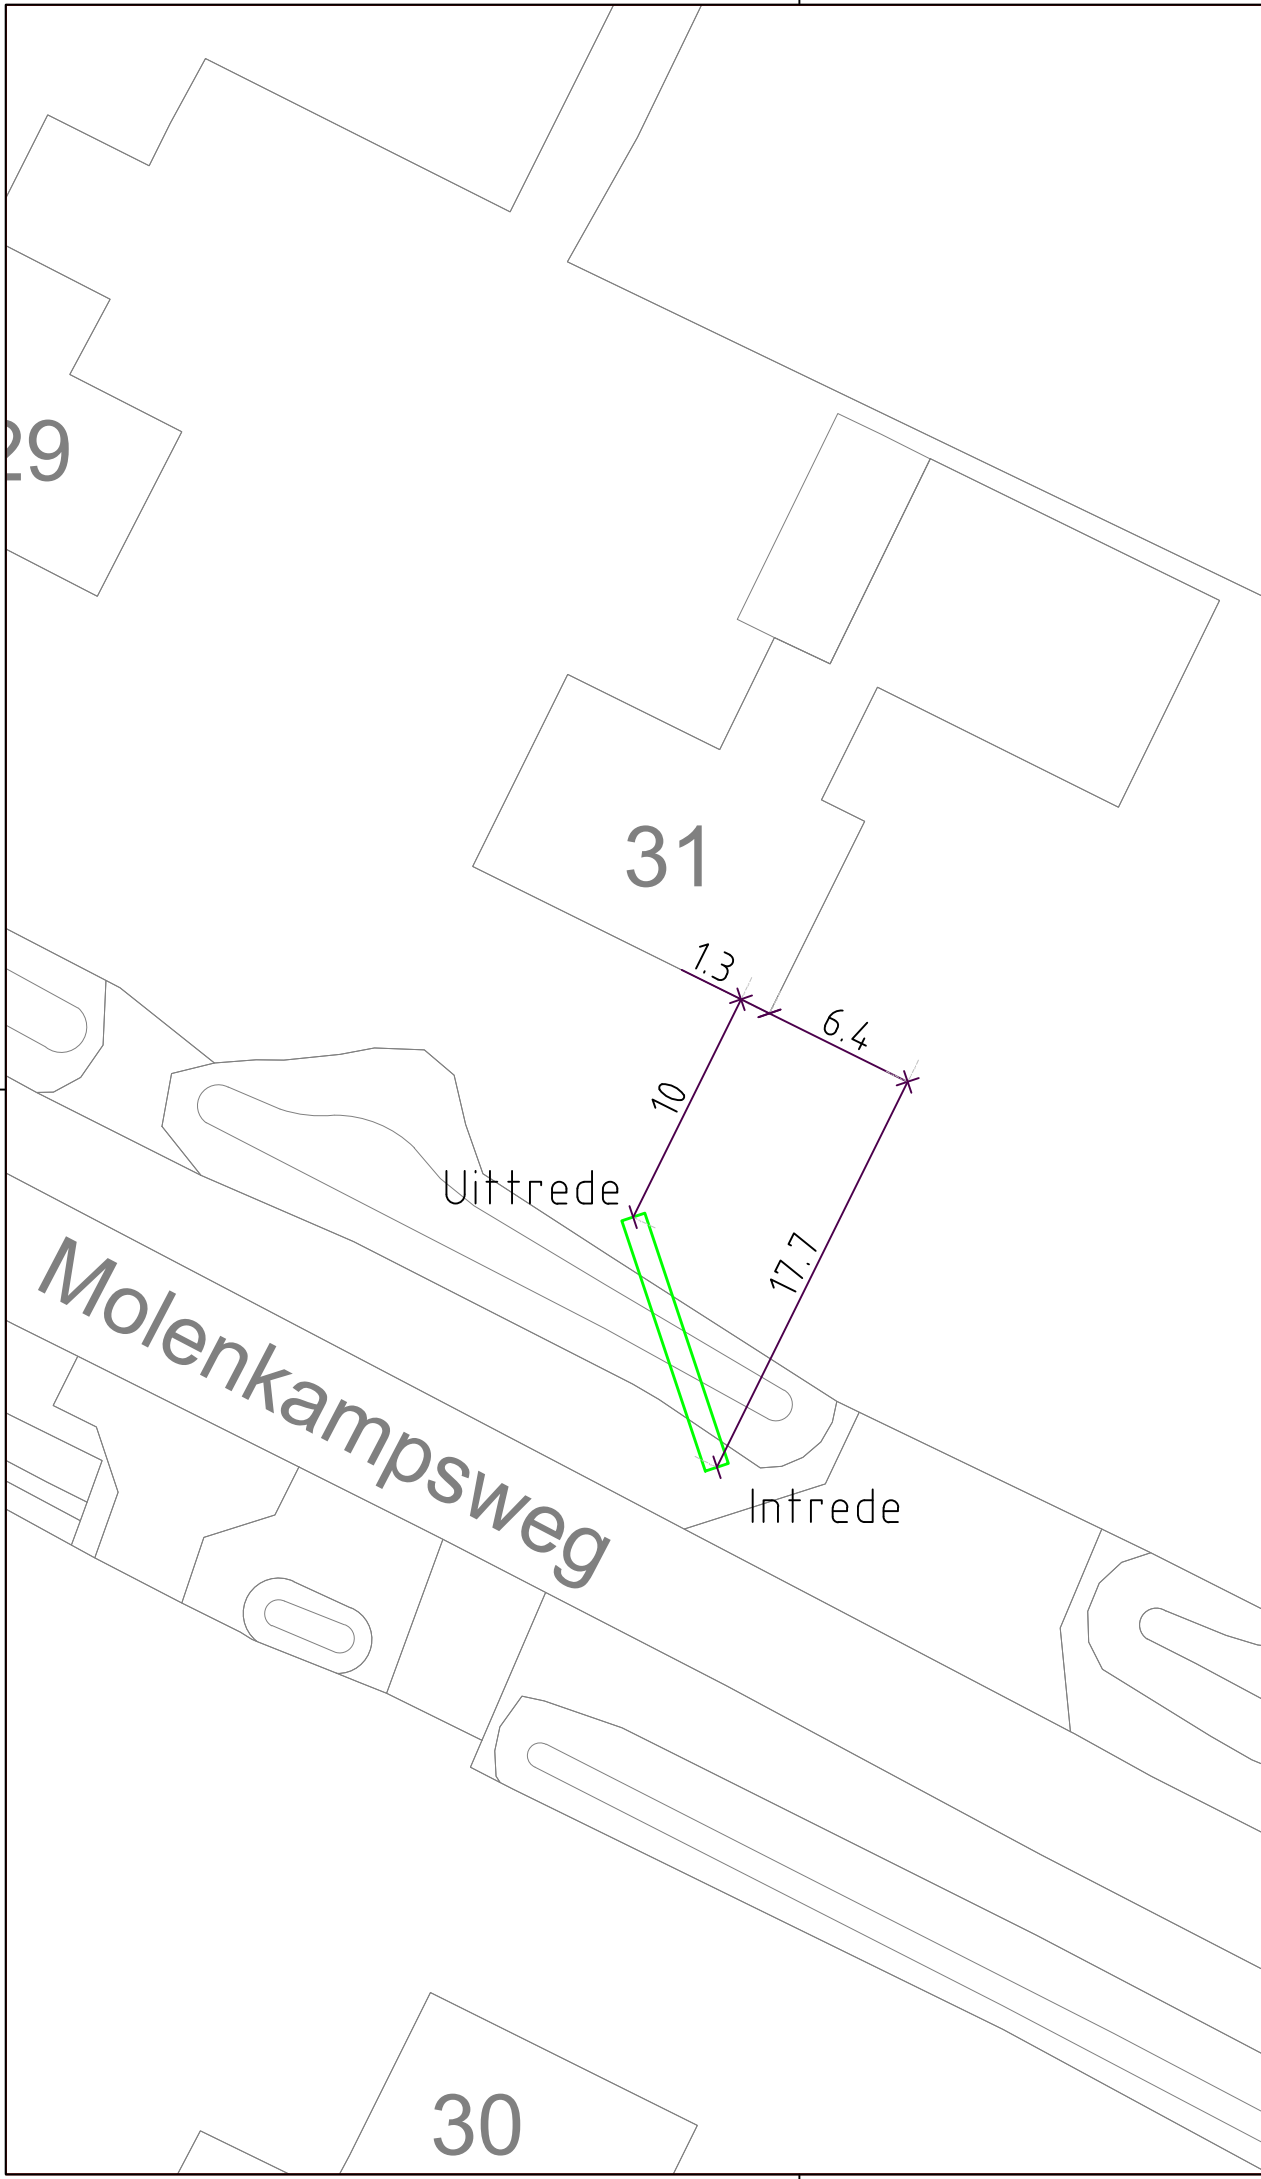


+ NAP

Intrede

Uittrede

1 2 3 4 5 6 7 8

Hor. afstand t.o.v. Intredepunt (m)	0.00	1.80	3.60	5.40	7.20	9.00	10.80	12.60
Hartlijn Boring t.o.v. Maaiveld	0.00	-3.41						0.00

1 2 3 4 5 6 7

BOOGZINKER

R5-P3

LENGTE BORING:

10.88 M

Intrede X= 136355.4773 Y= 424336.9285
Uittrede X= 136352.0257 Y= 424347.2459



Kader	A3
DATE	27-10-2023
GETEKEND	Y.A
SCHAAL	1:500
UITGAVE	A

DELTA-RIJSSEN
MOLENKAMPSWEG
GESTUURDE-BORING
ZALTBOMMEL

AS-BUILD
BRA-1B-BOOGZINKER030