


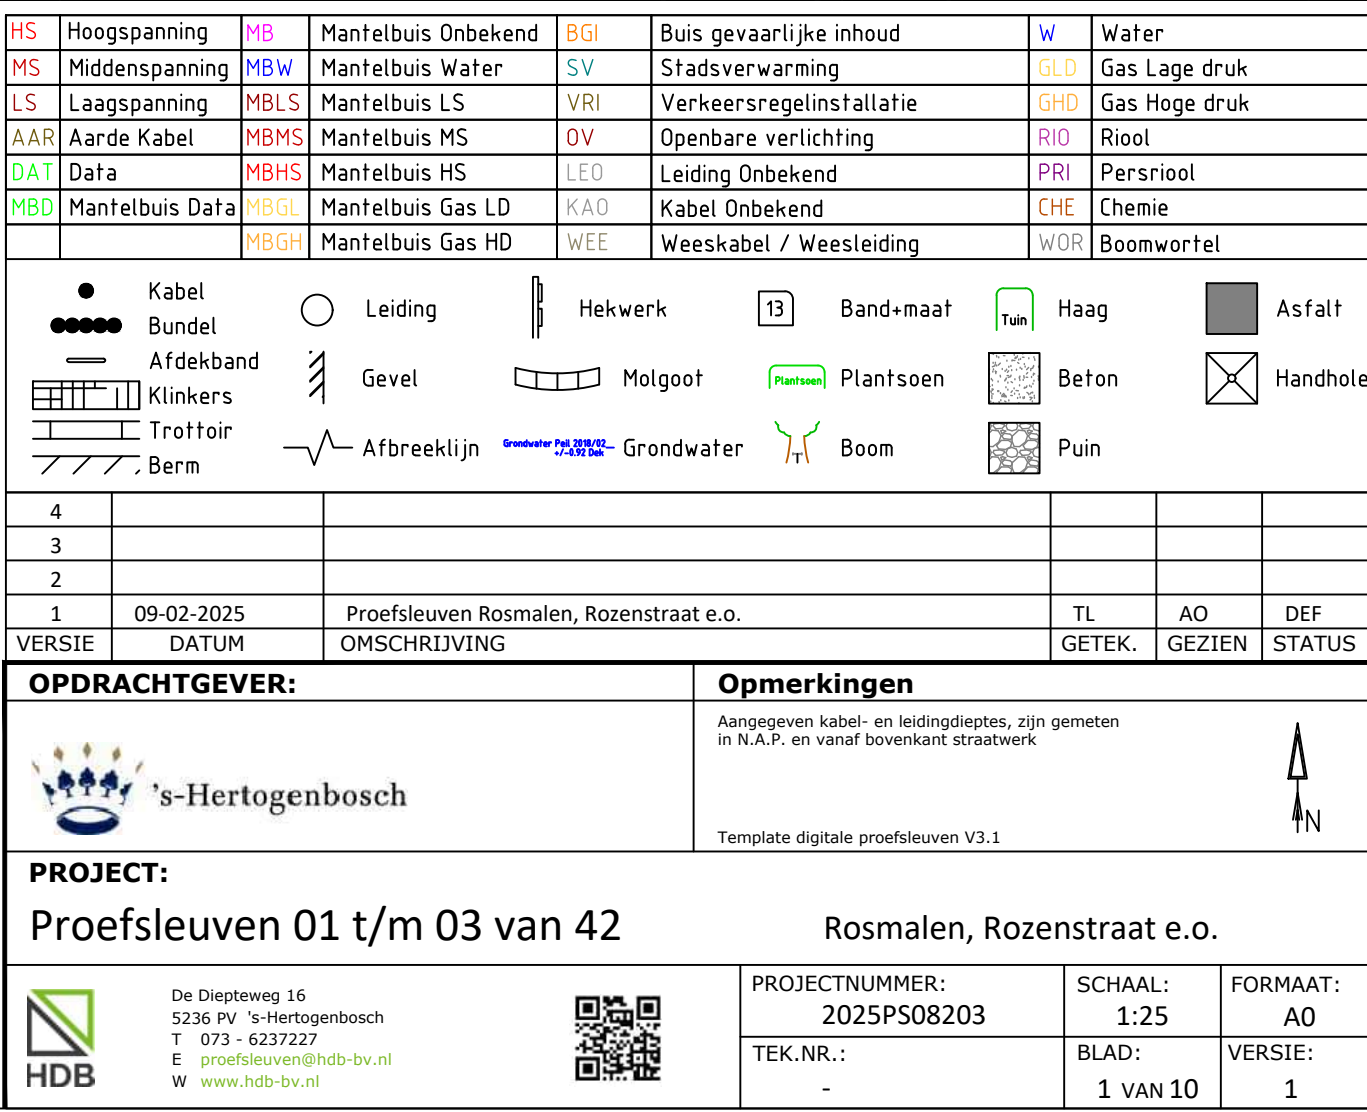
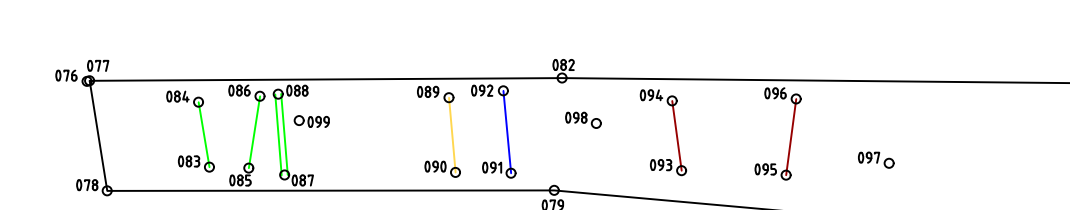
 
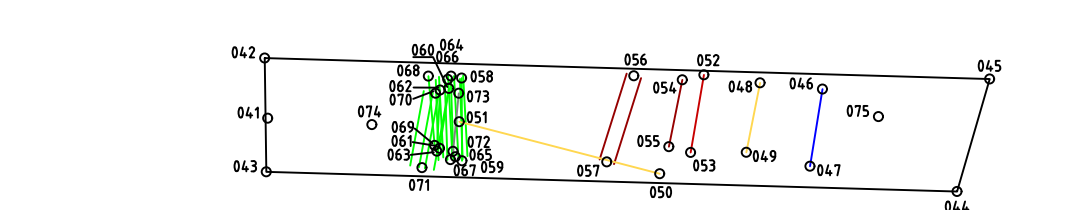
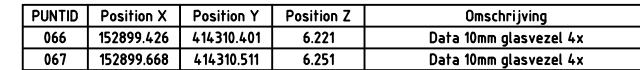
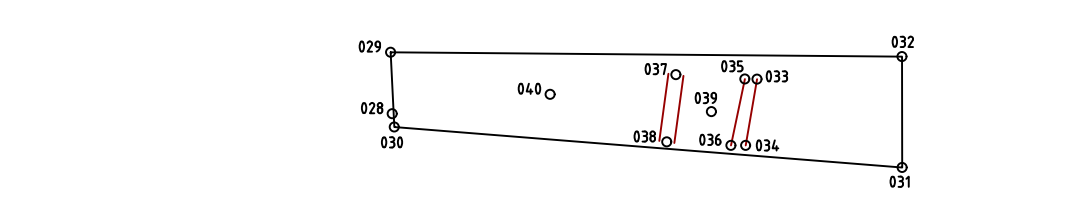
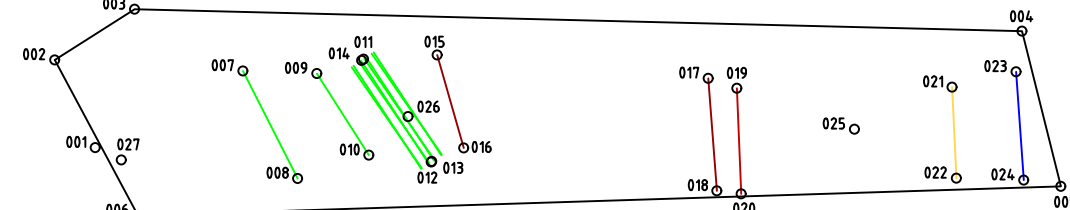



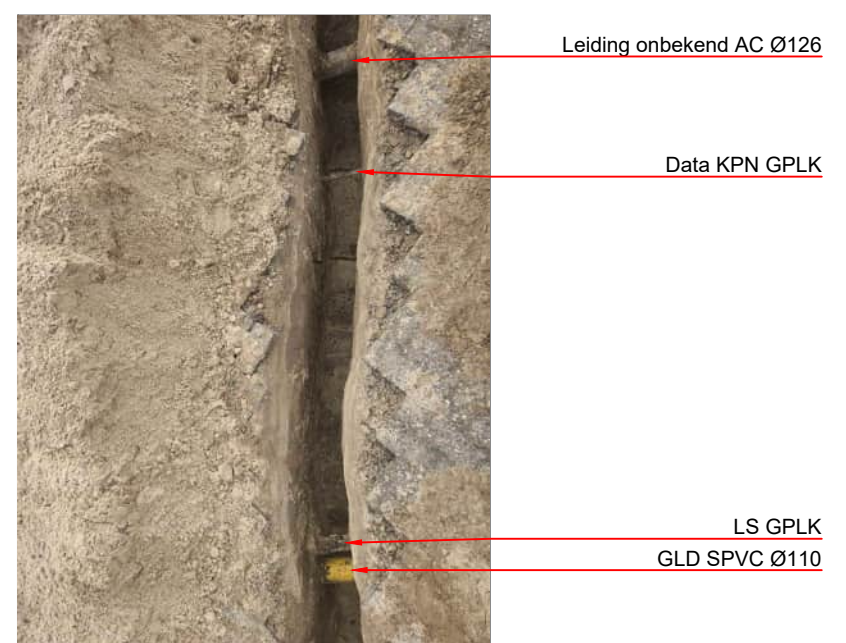


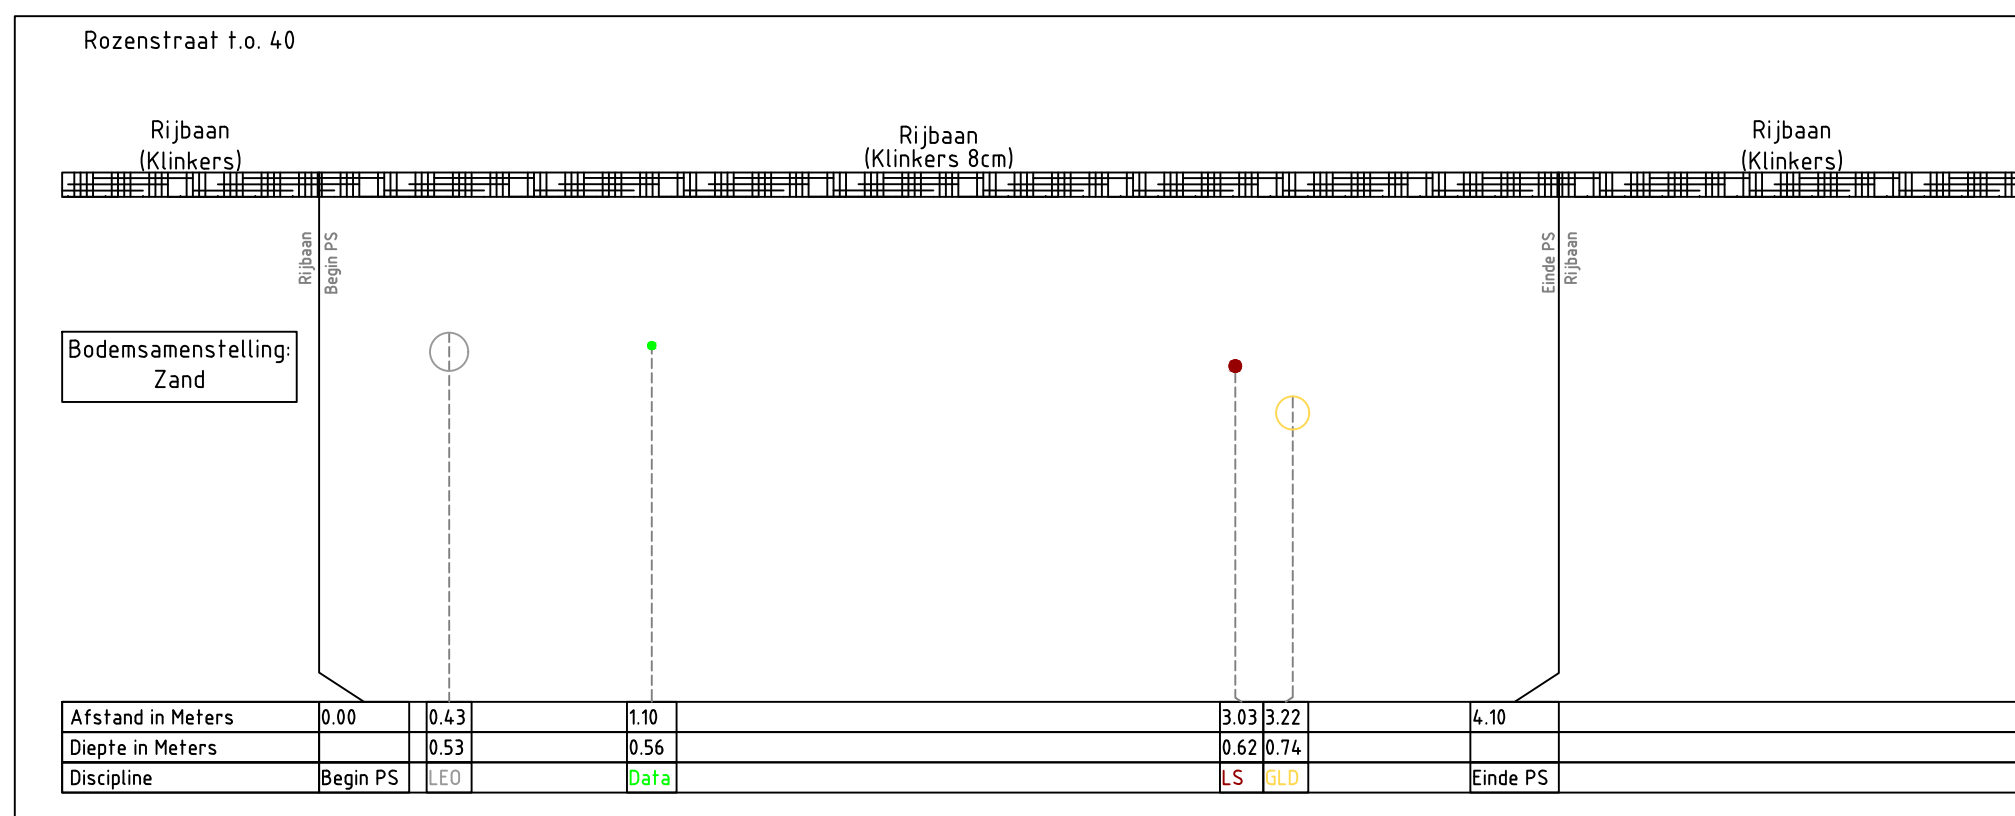

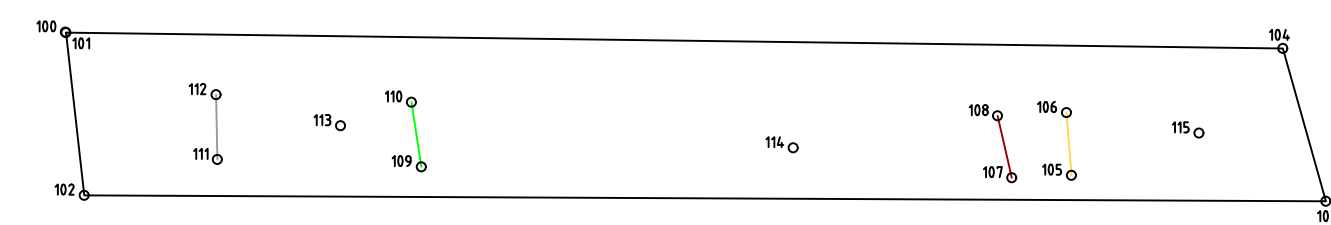


Proefsleuf 4

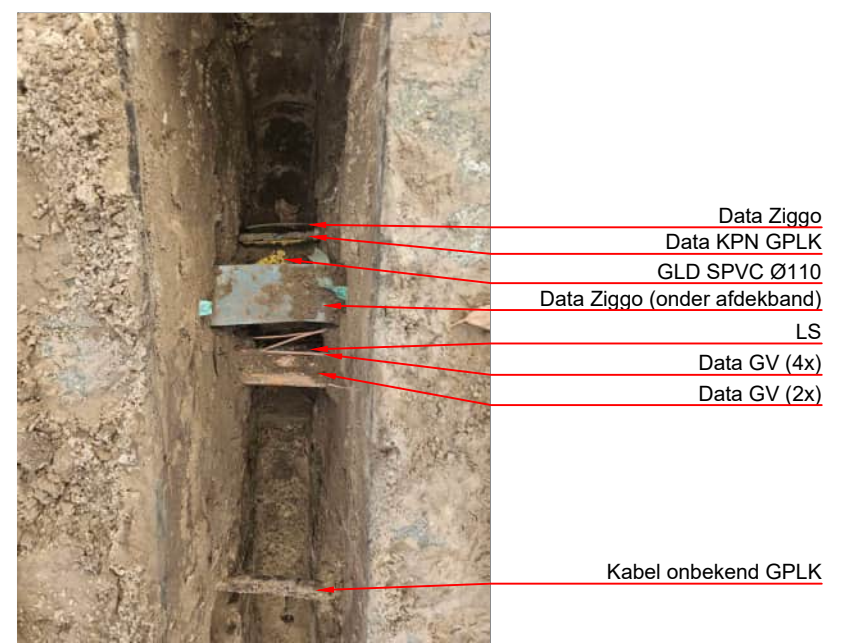
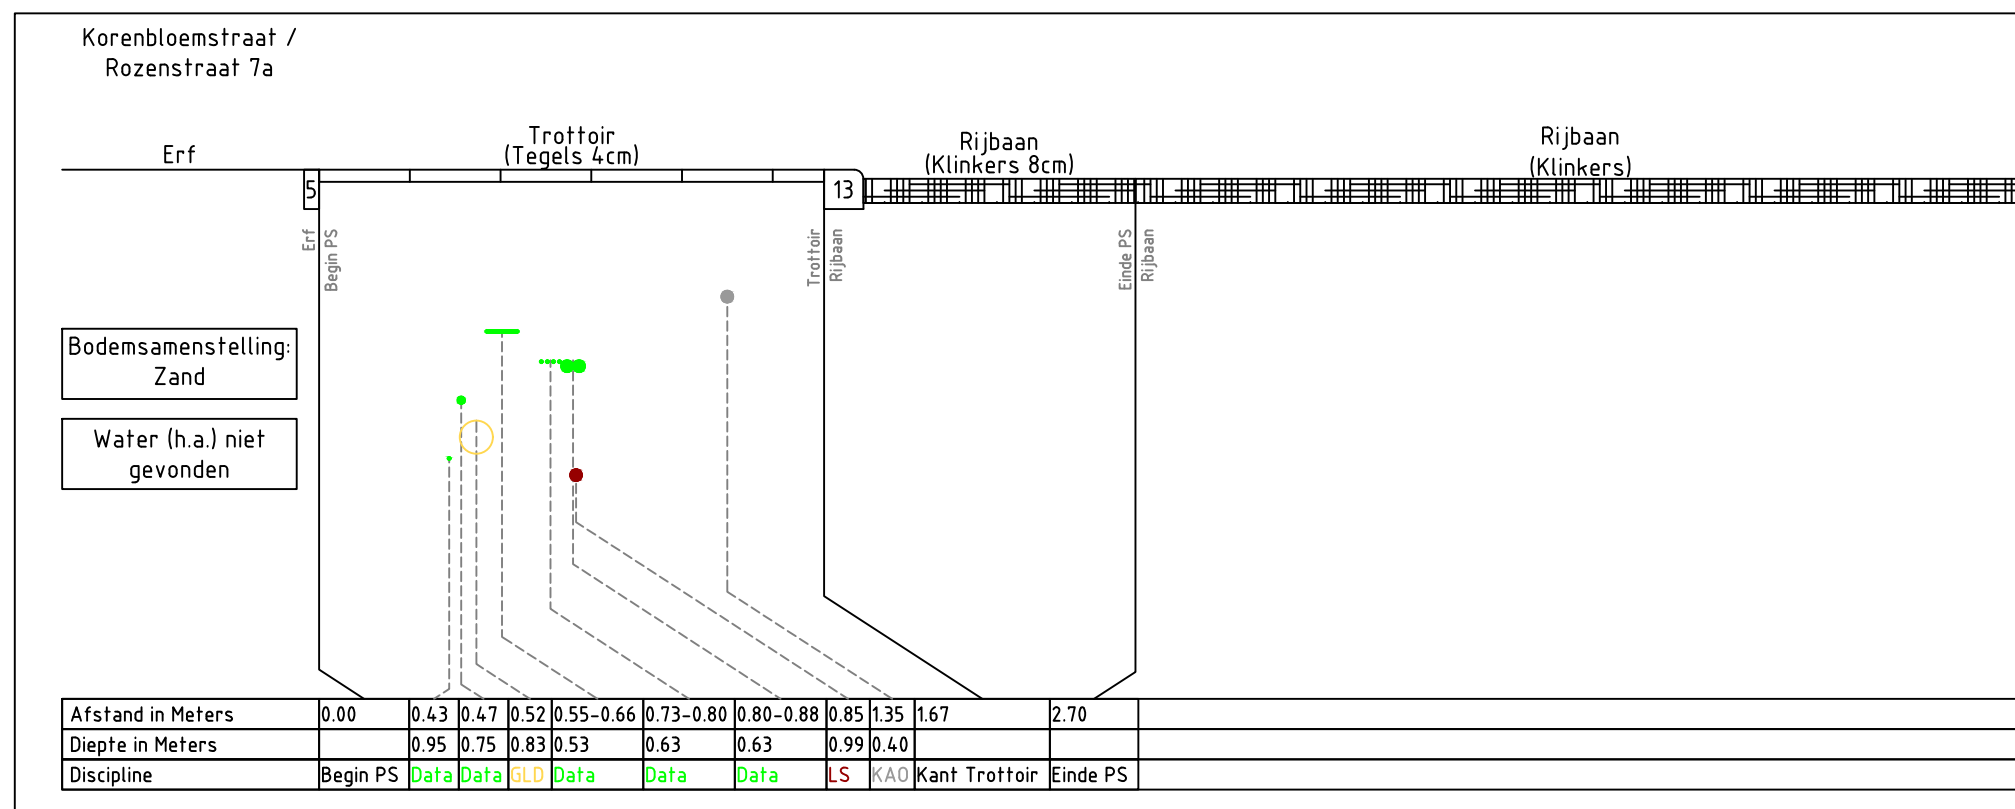



PUNCH	Position X	Position Y	Position Z	Description
14.1	152935.821	414245.799	4.548	Gravingsdie
14.2	152935.377	414246.382	4.487	Gravingsdie
14.3	152935.167	414247.019	4.513	Gravingsdie

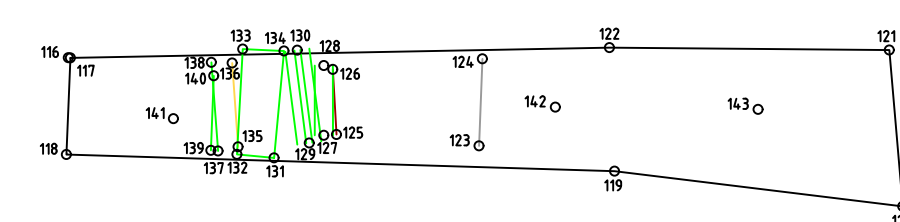


Proefsleuf 5

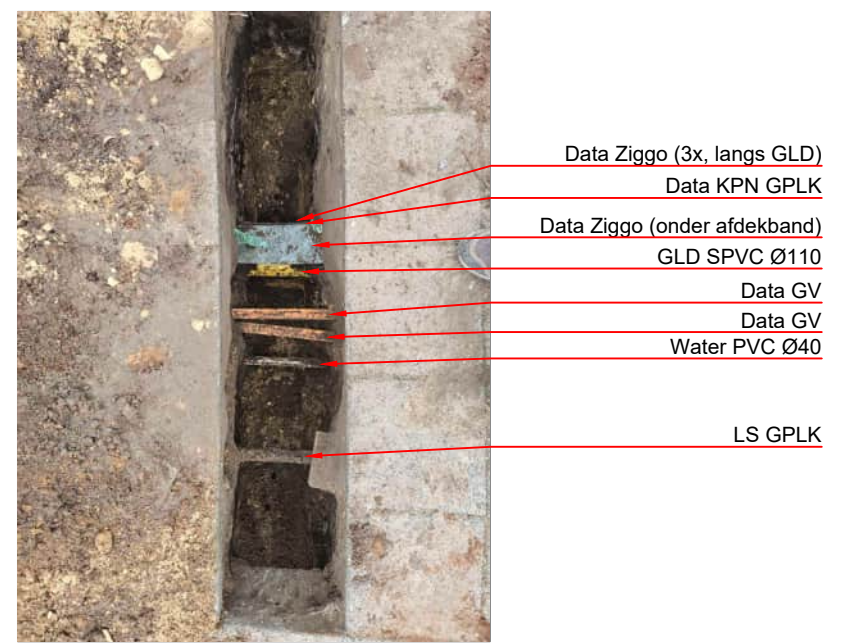
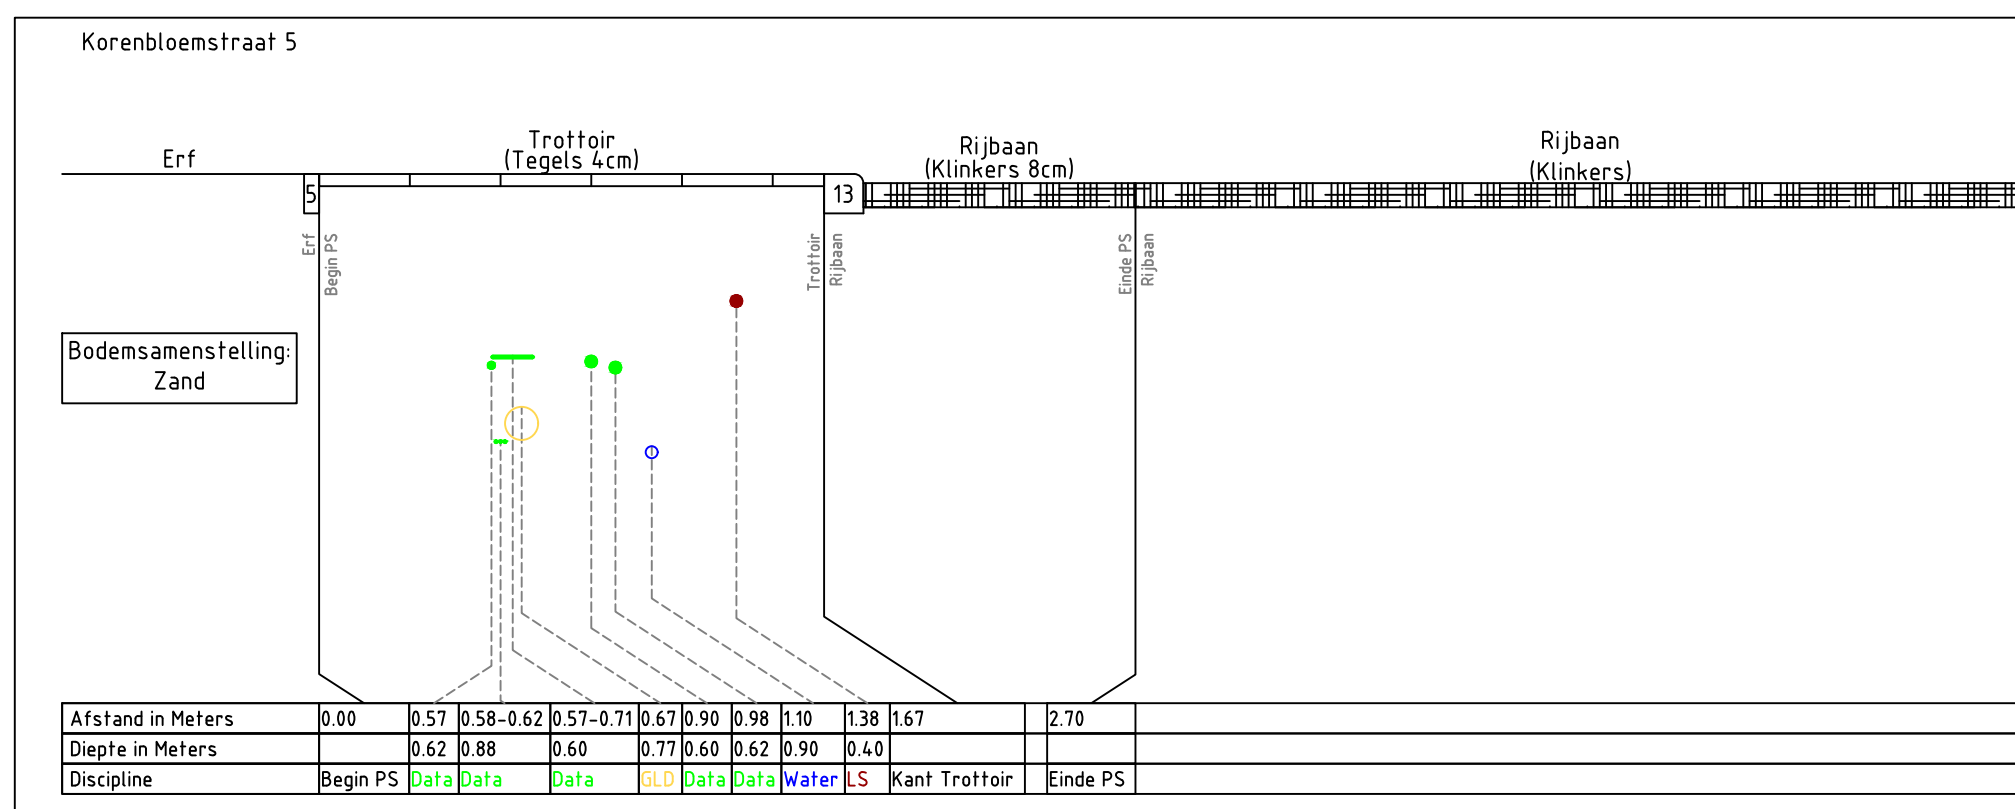


PUNTD	Position X	Position Y	Position Z	Omschrijving
109	15294.9730	416250.852	4.524	Ontgravingdiepte
110	15294.9337	416251.312	4.589	Ontgravingdiepte
111	15294.9082	416252.809	4.482	Ontgravingdiepte

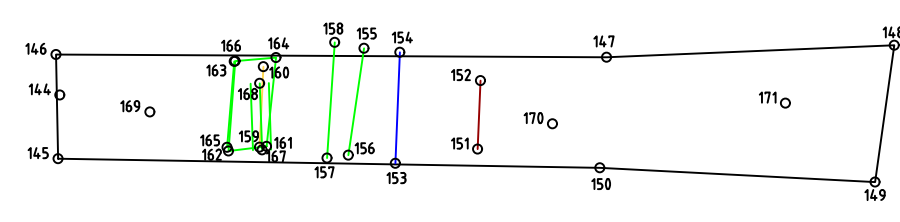



Proefsleuf 6

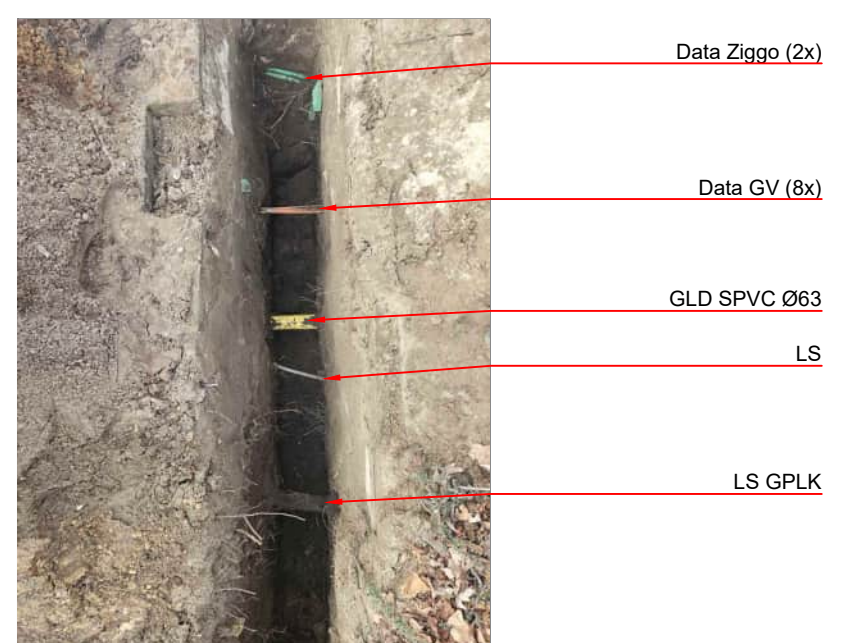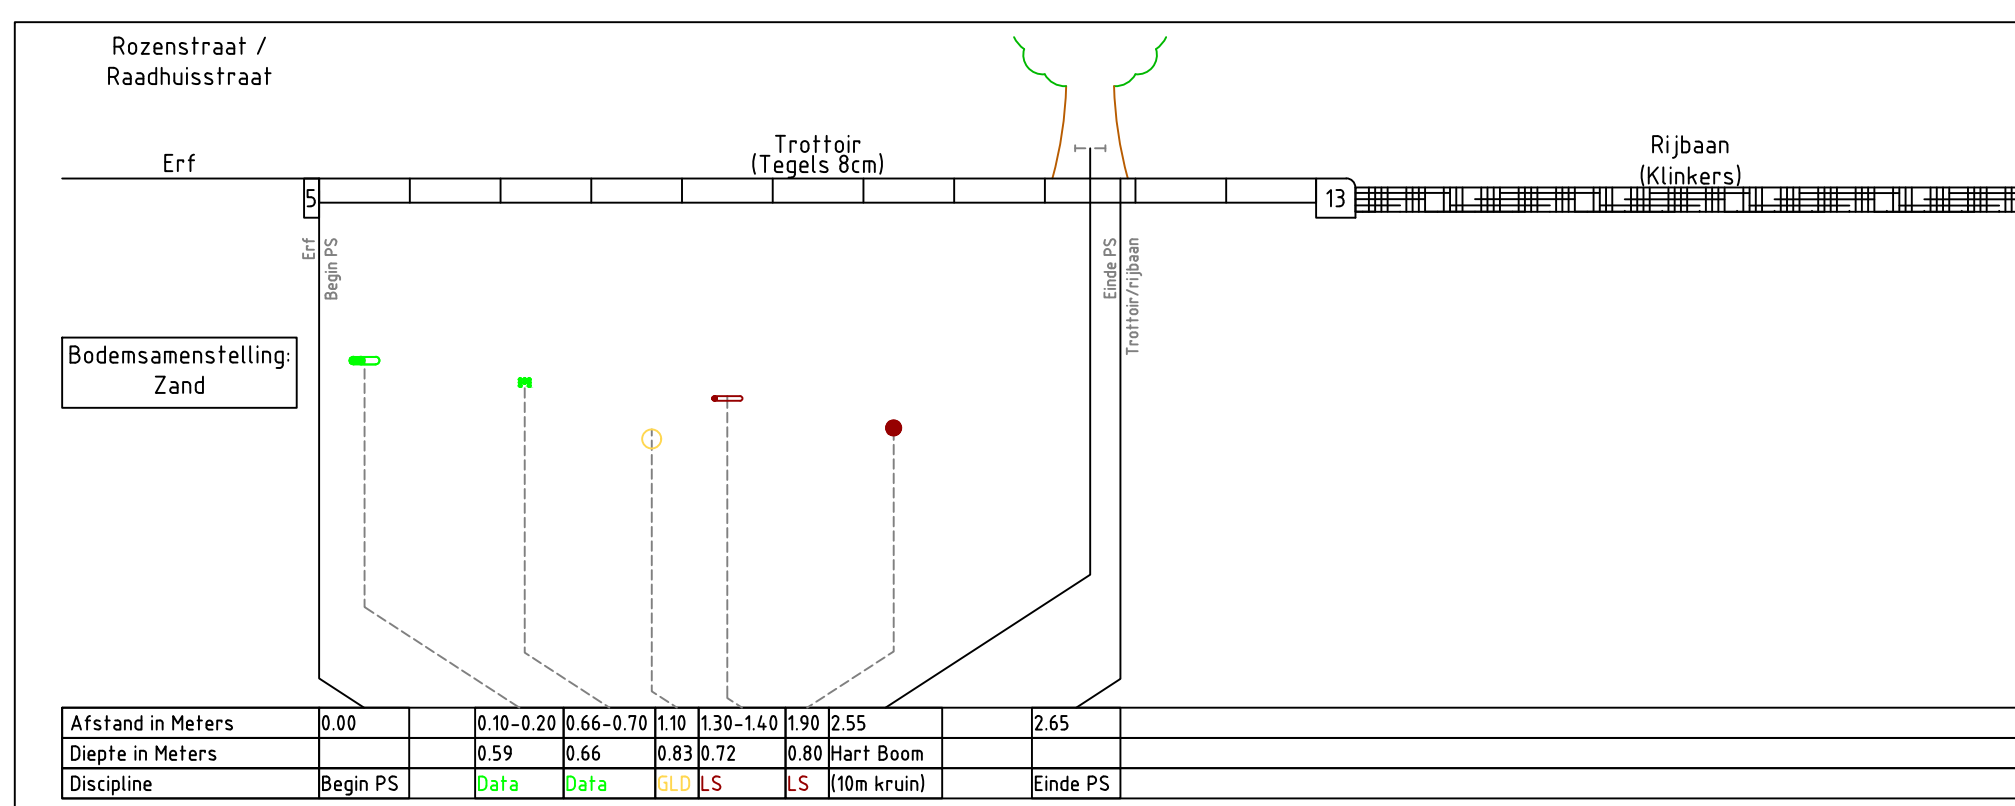


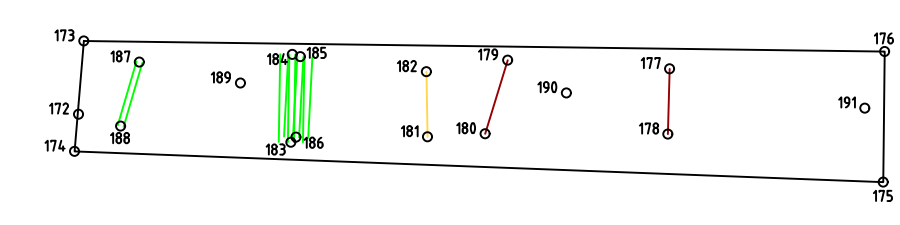



Proefsleuf 7





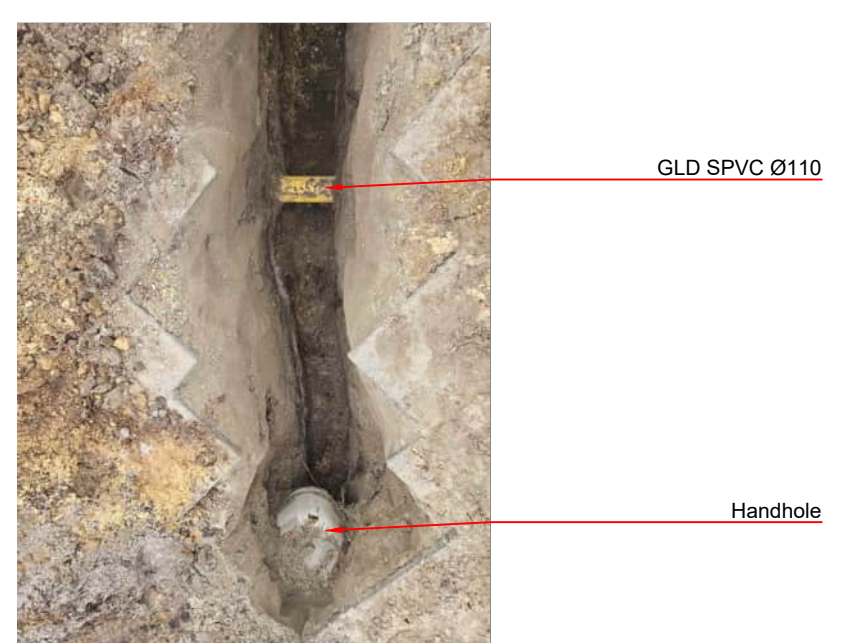
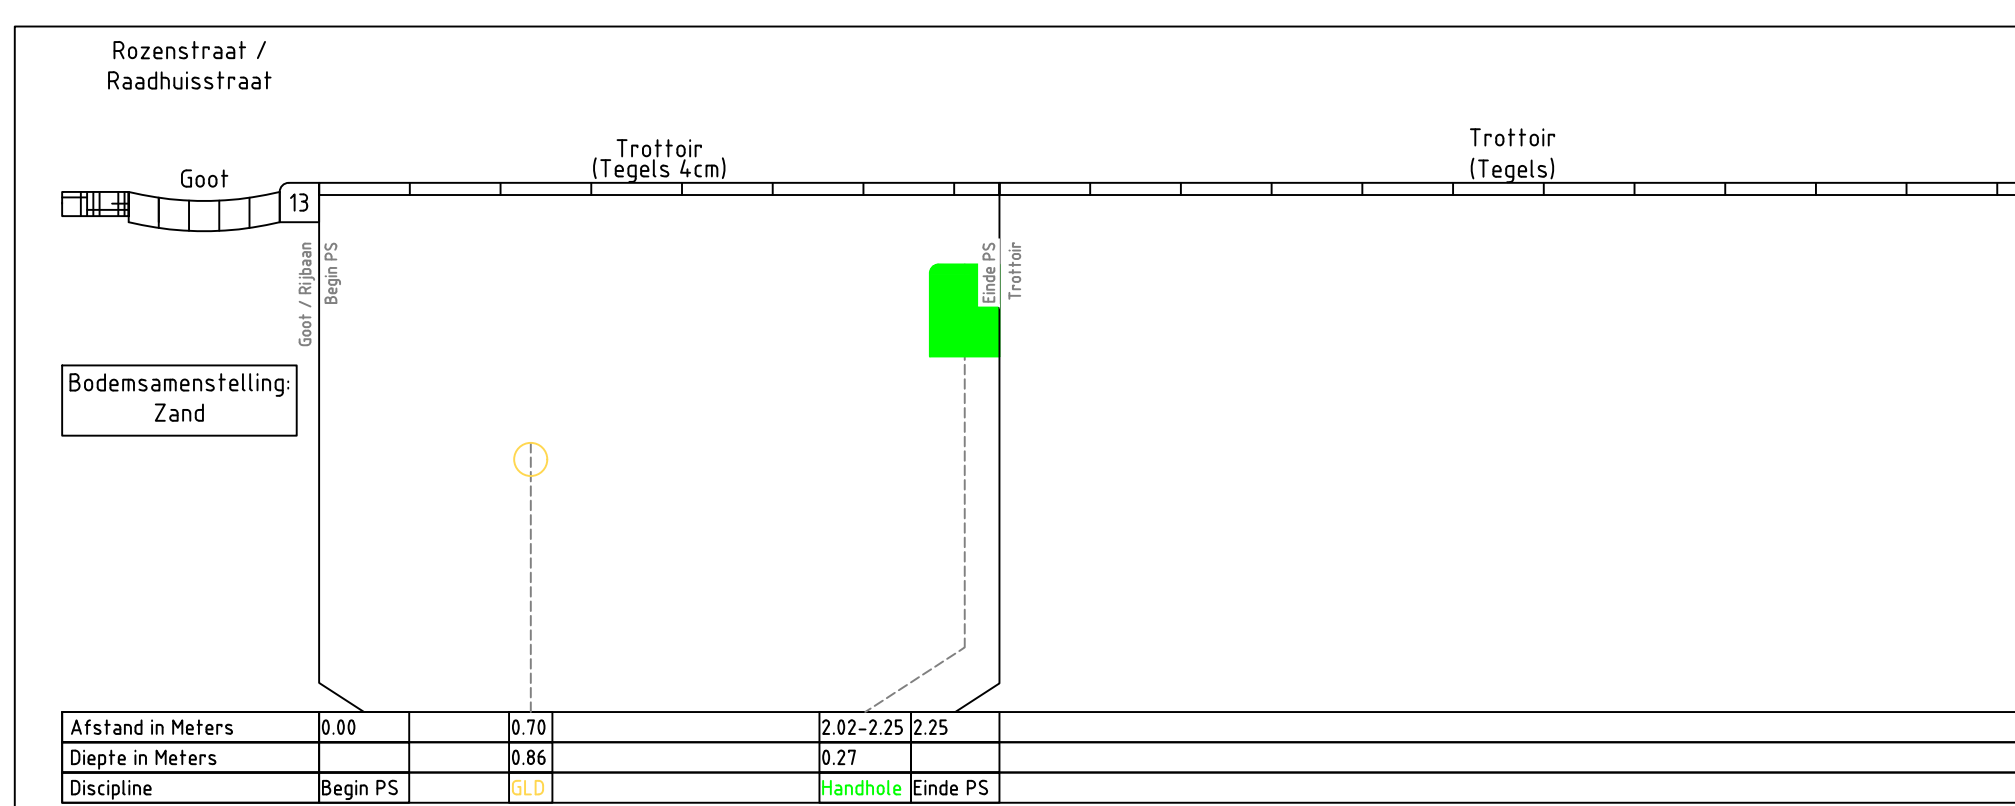




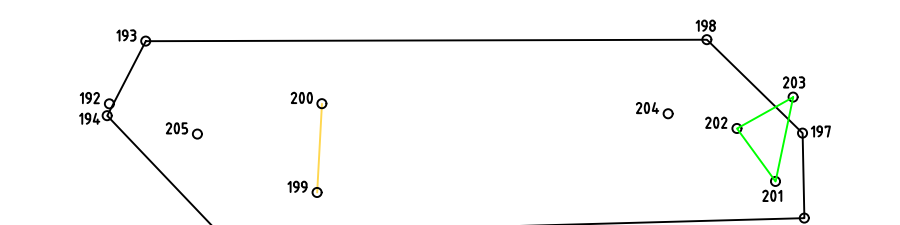



Proefsleuf 8

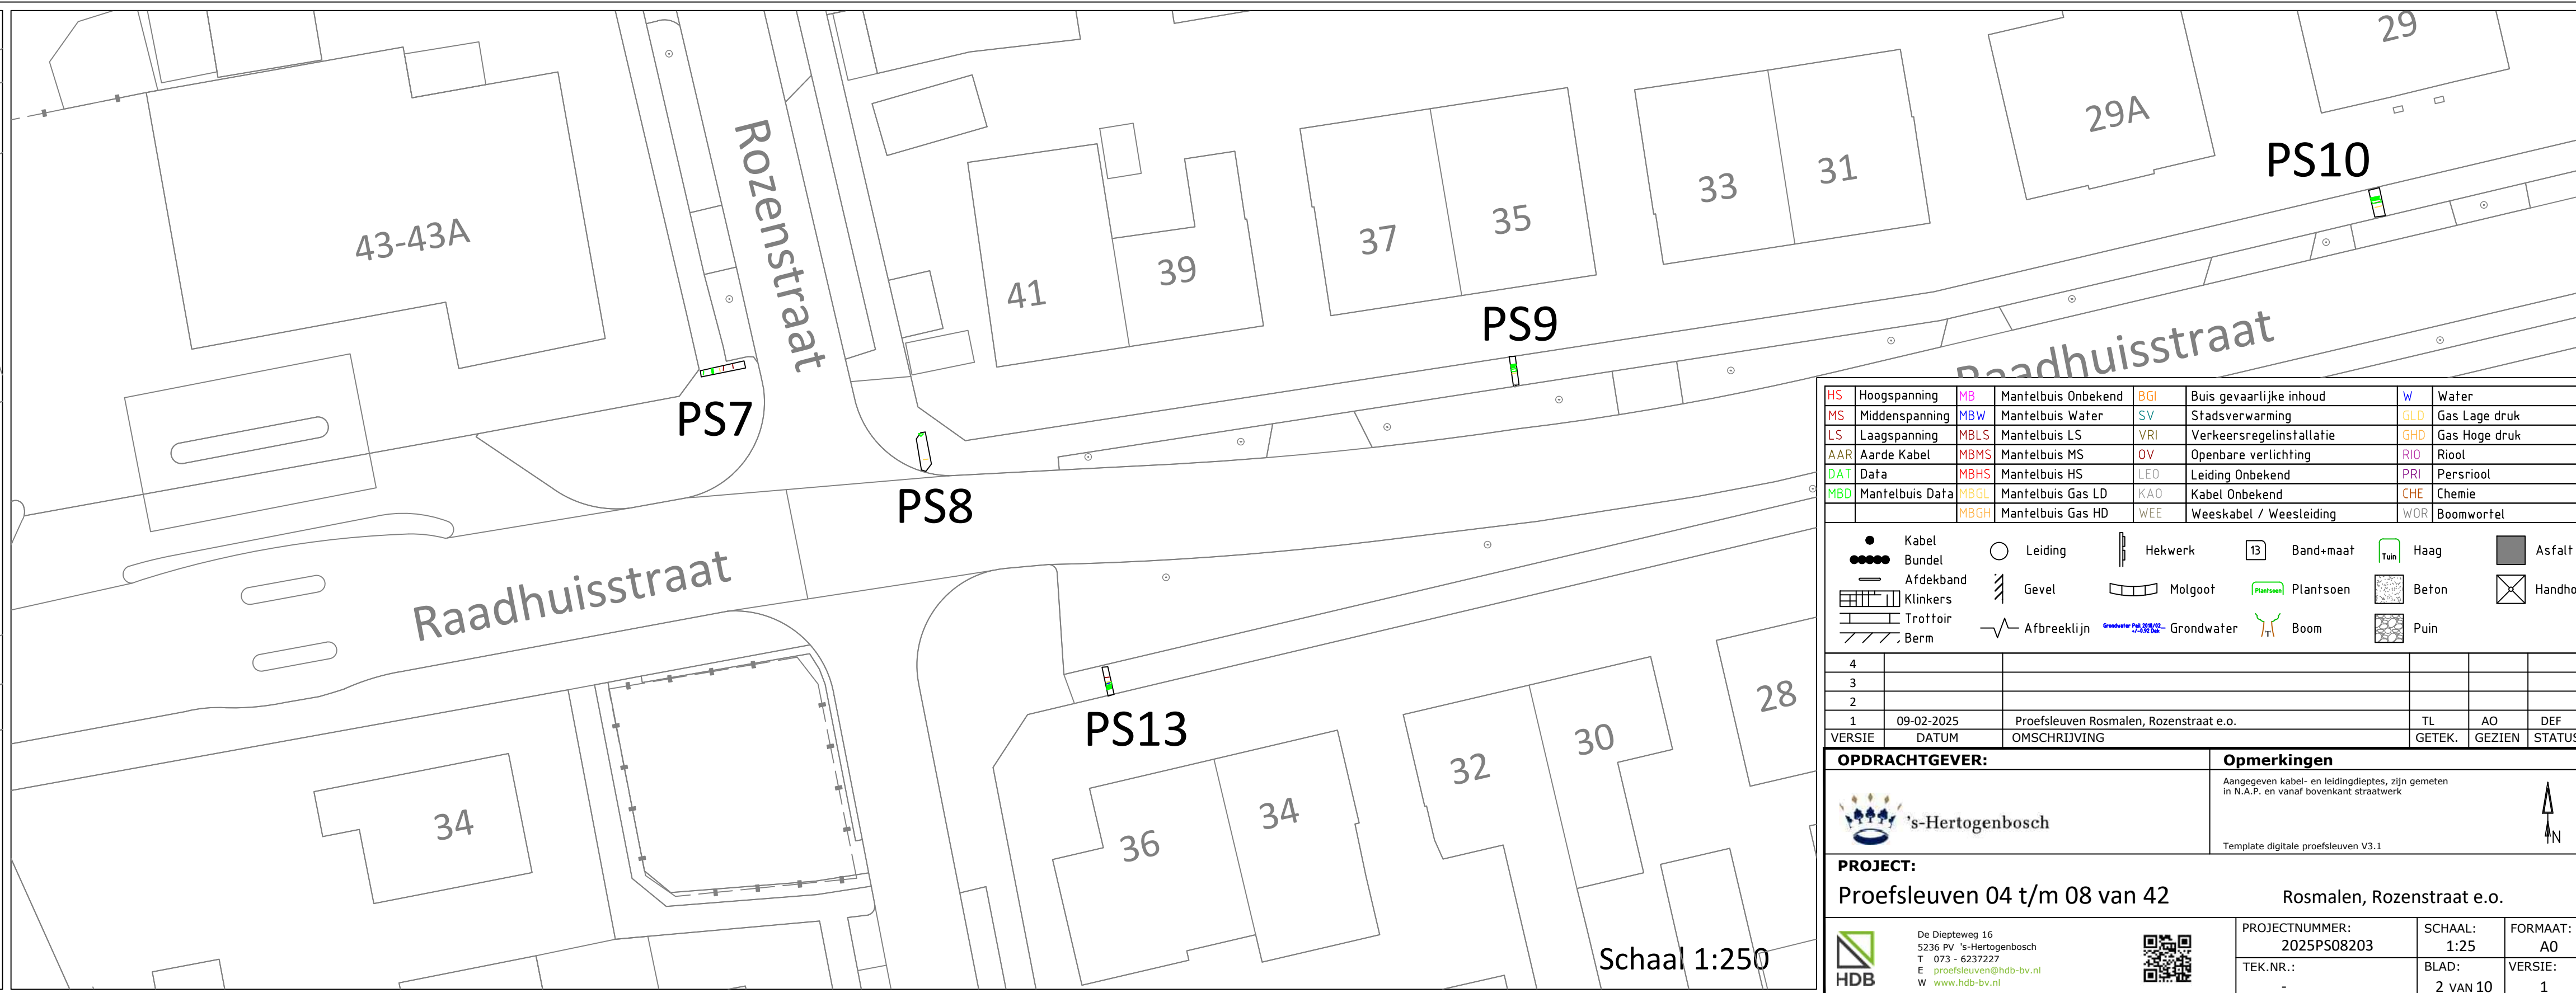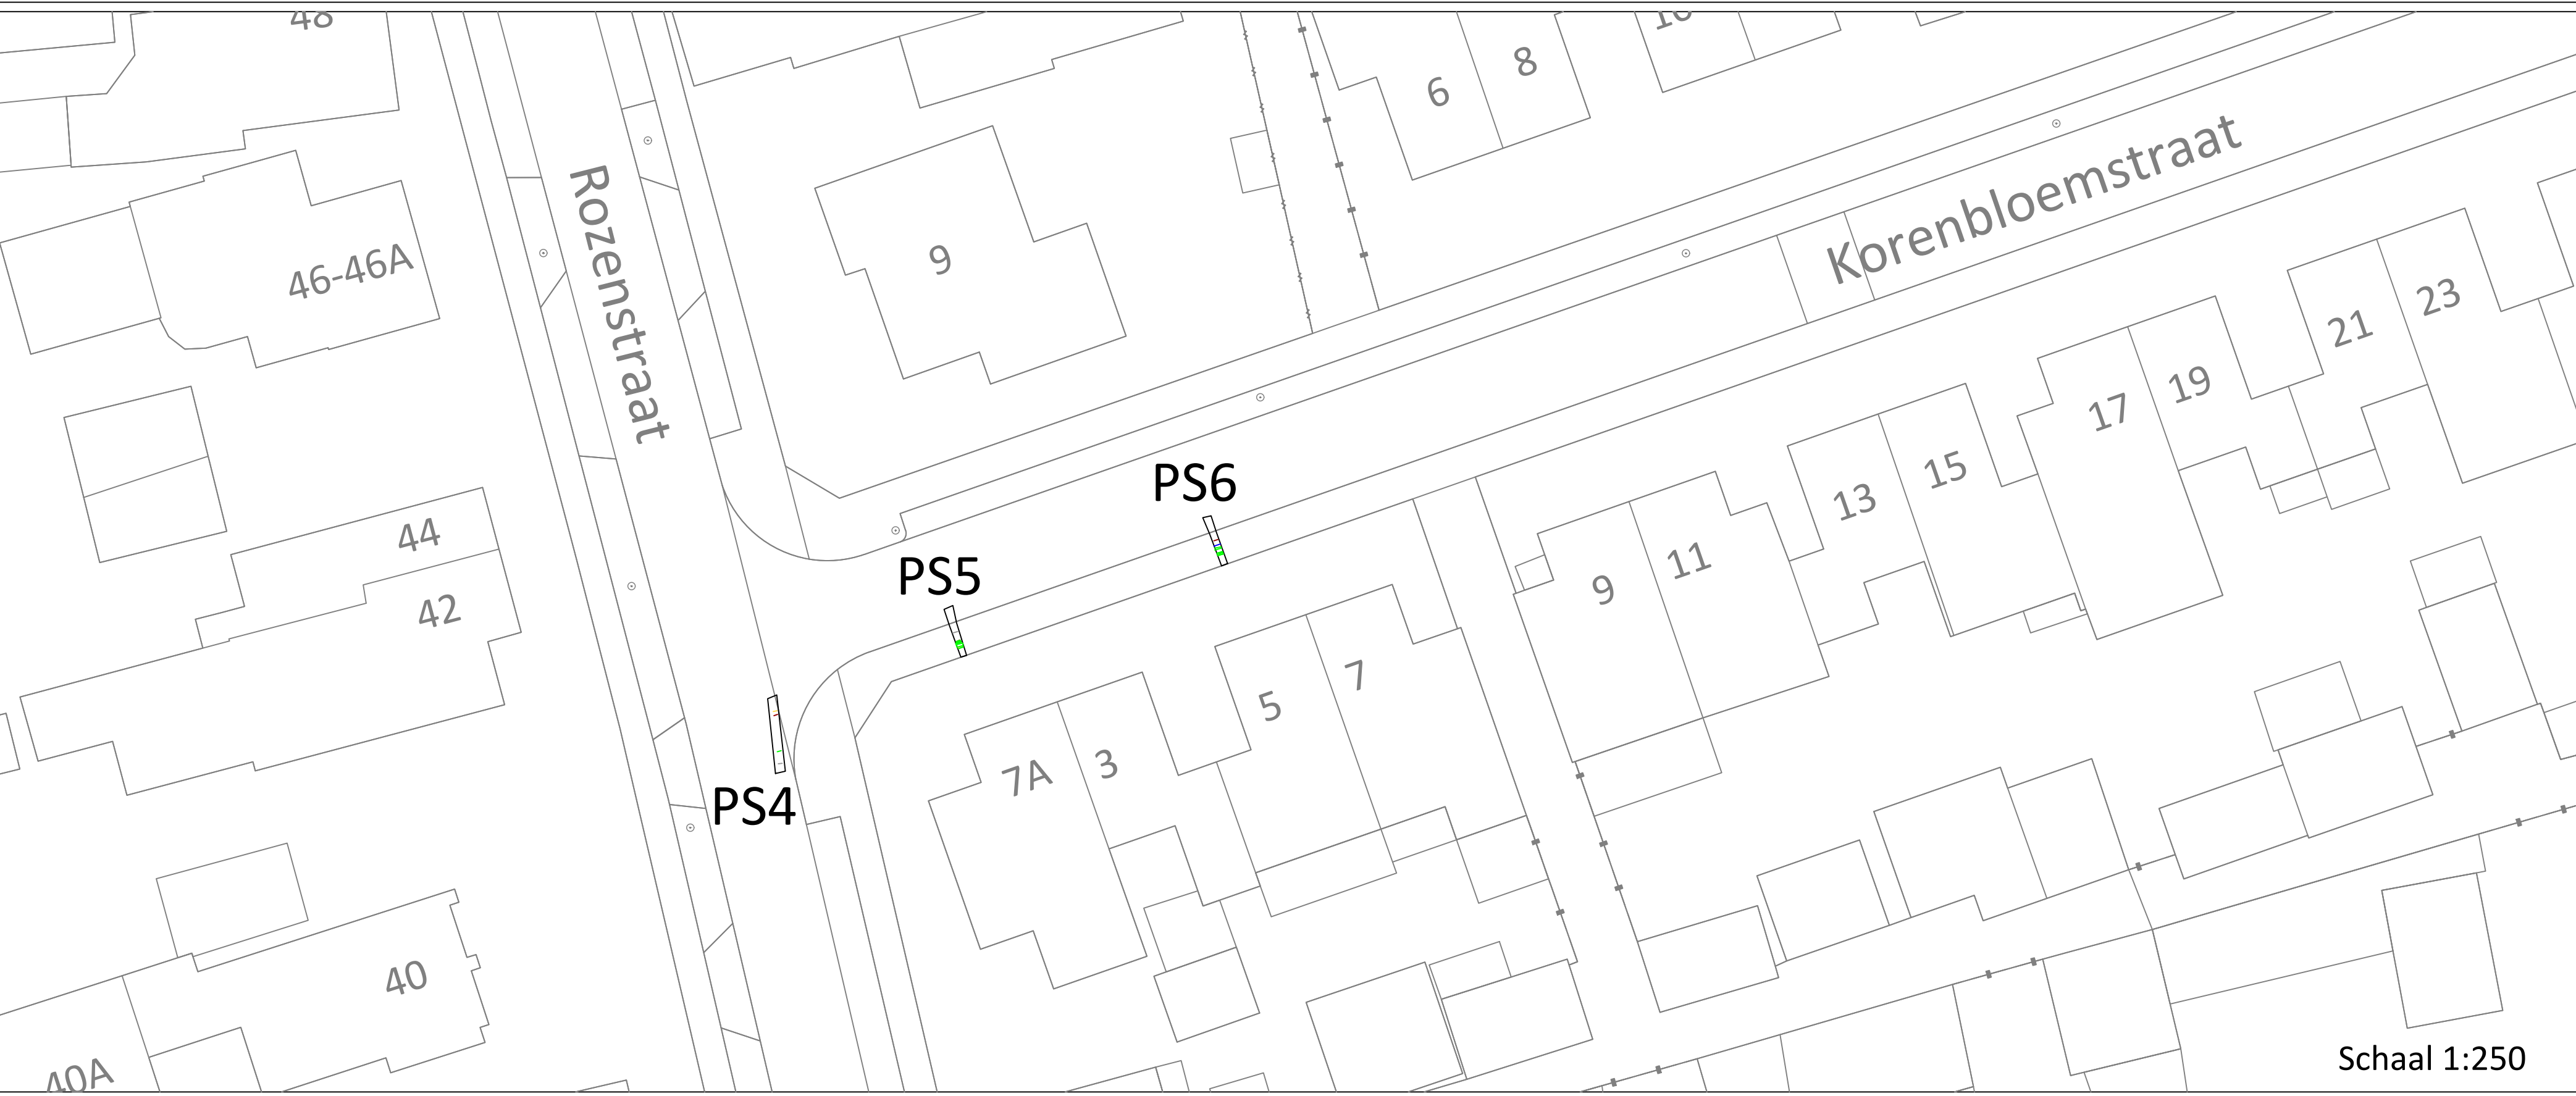

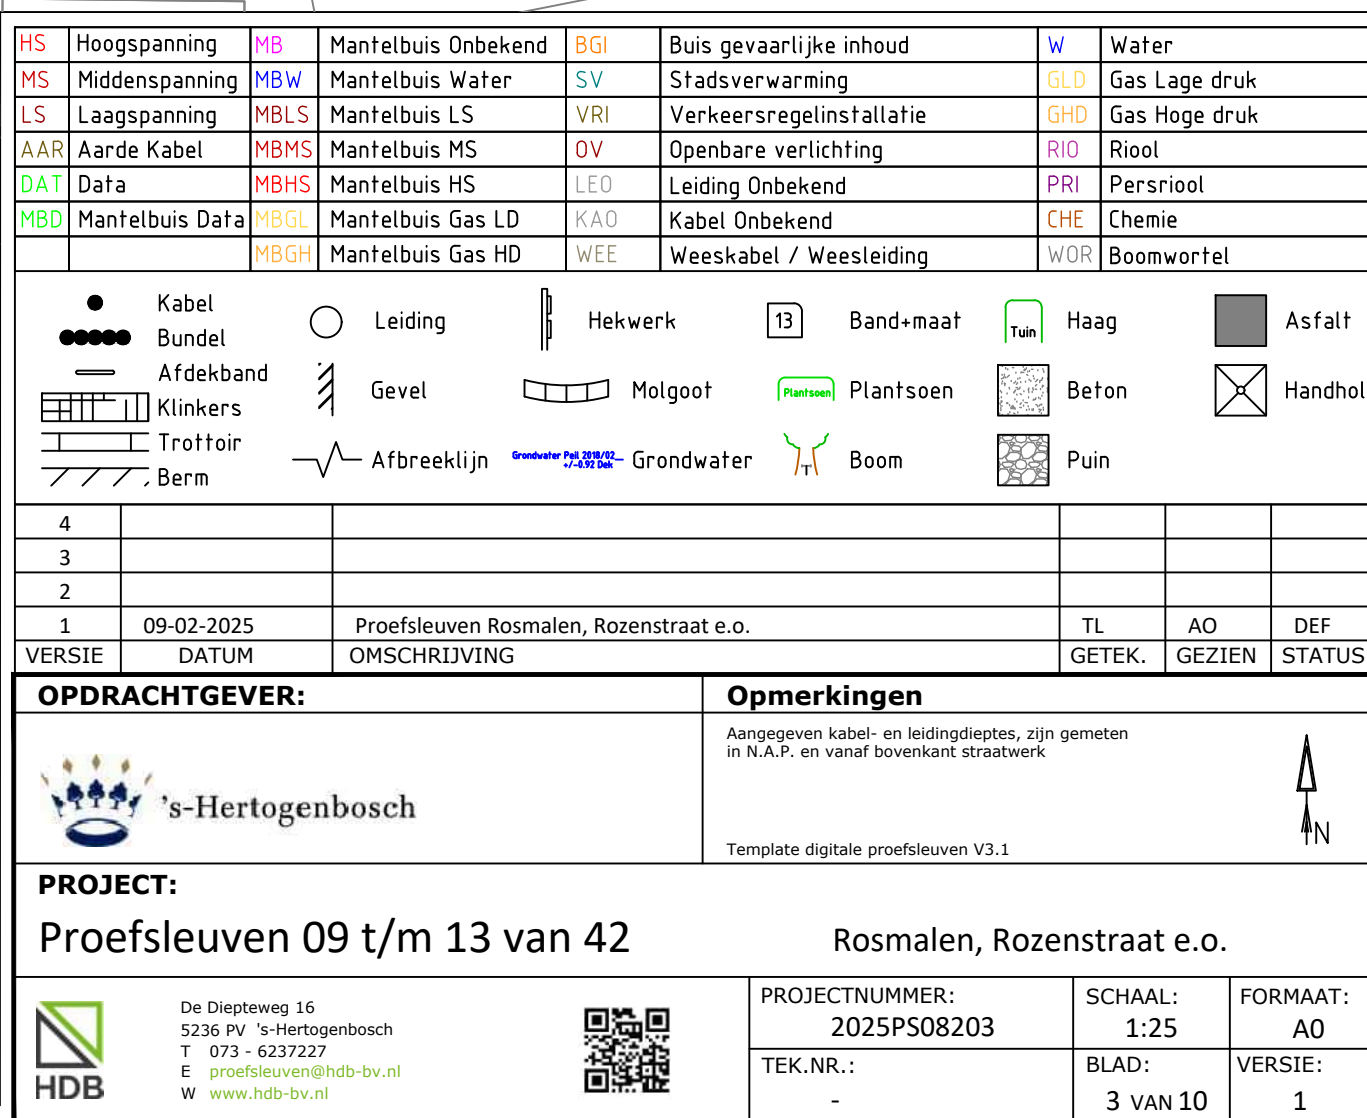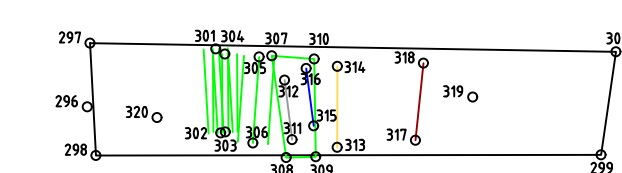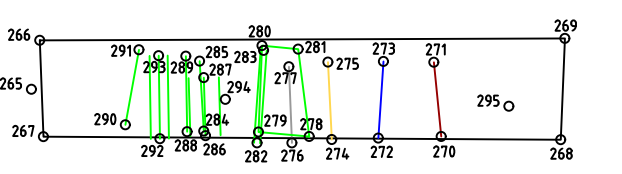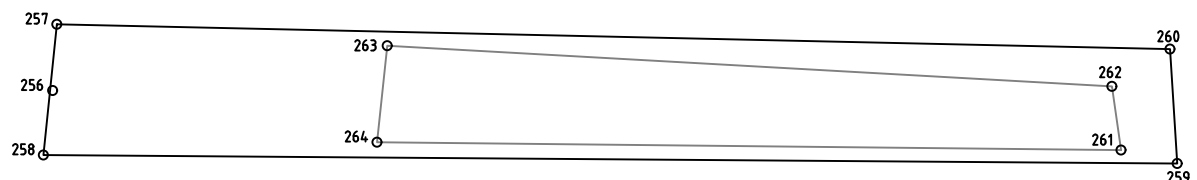
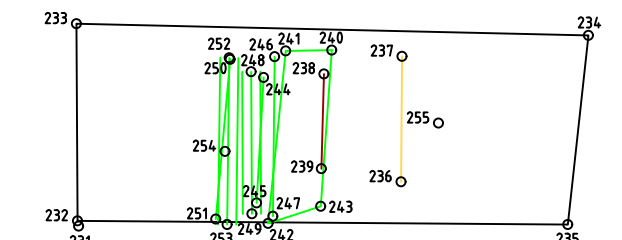
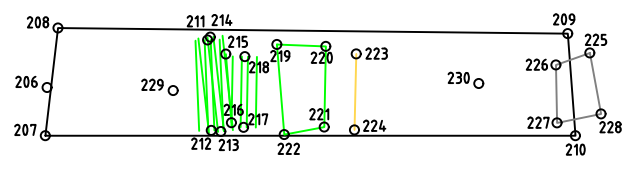


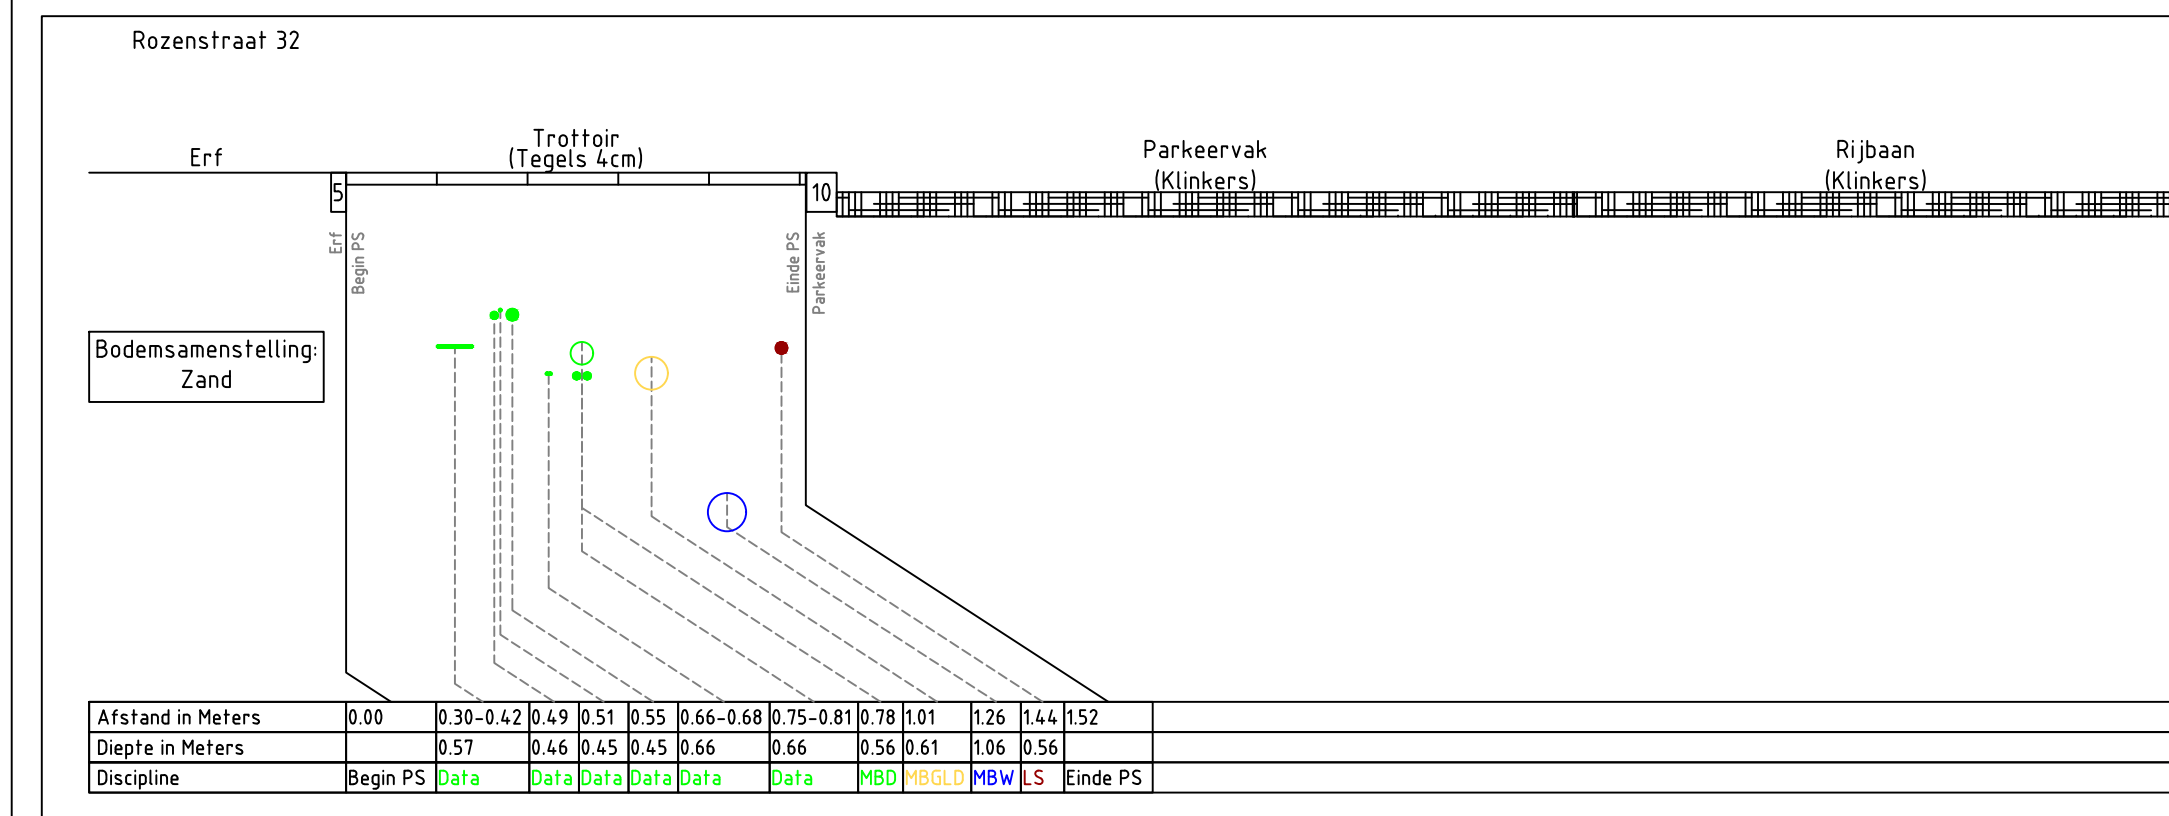[illegible]


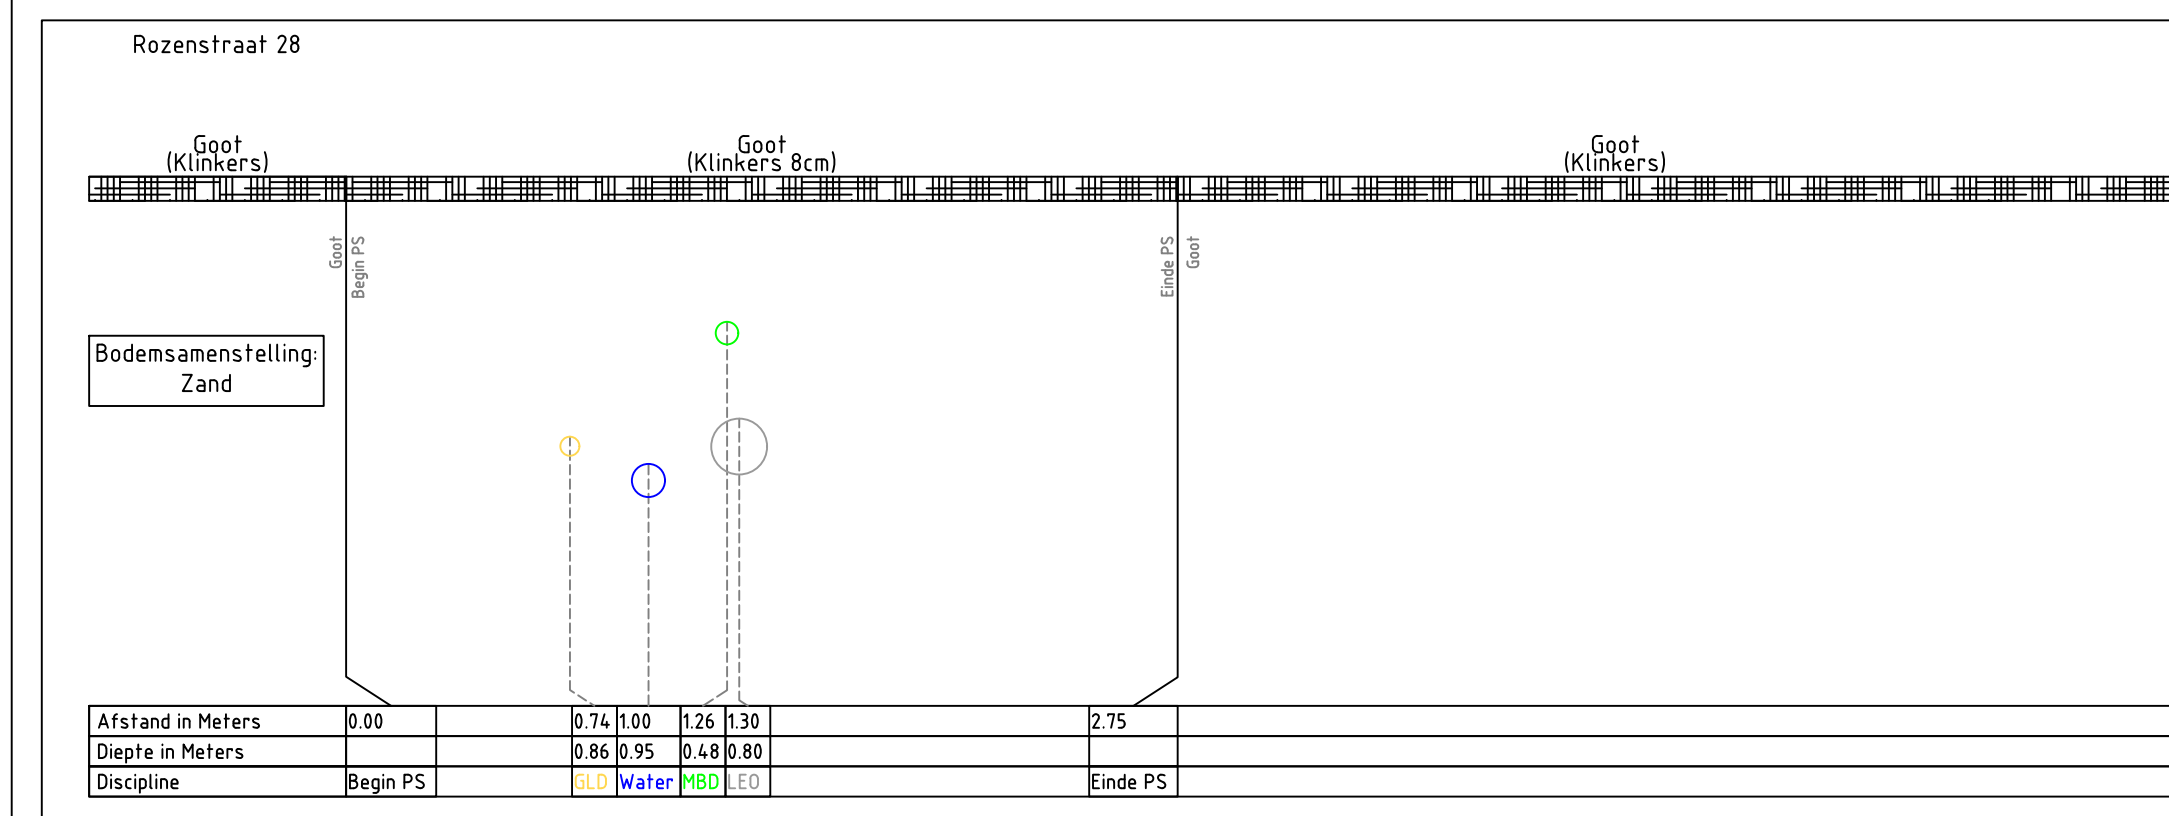
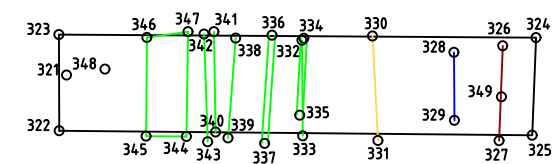



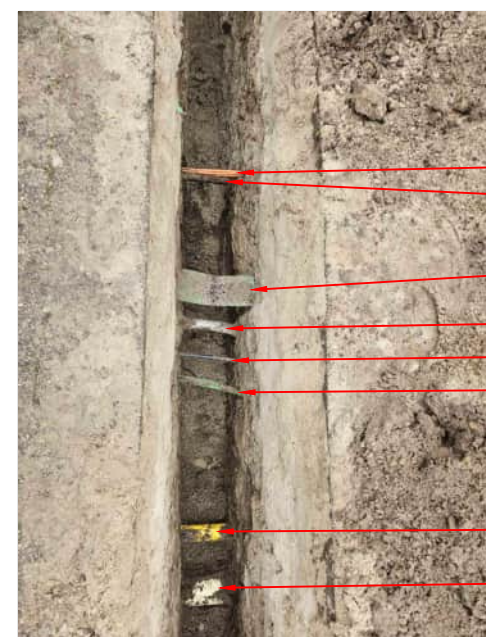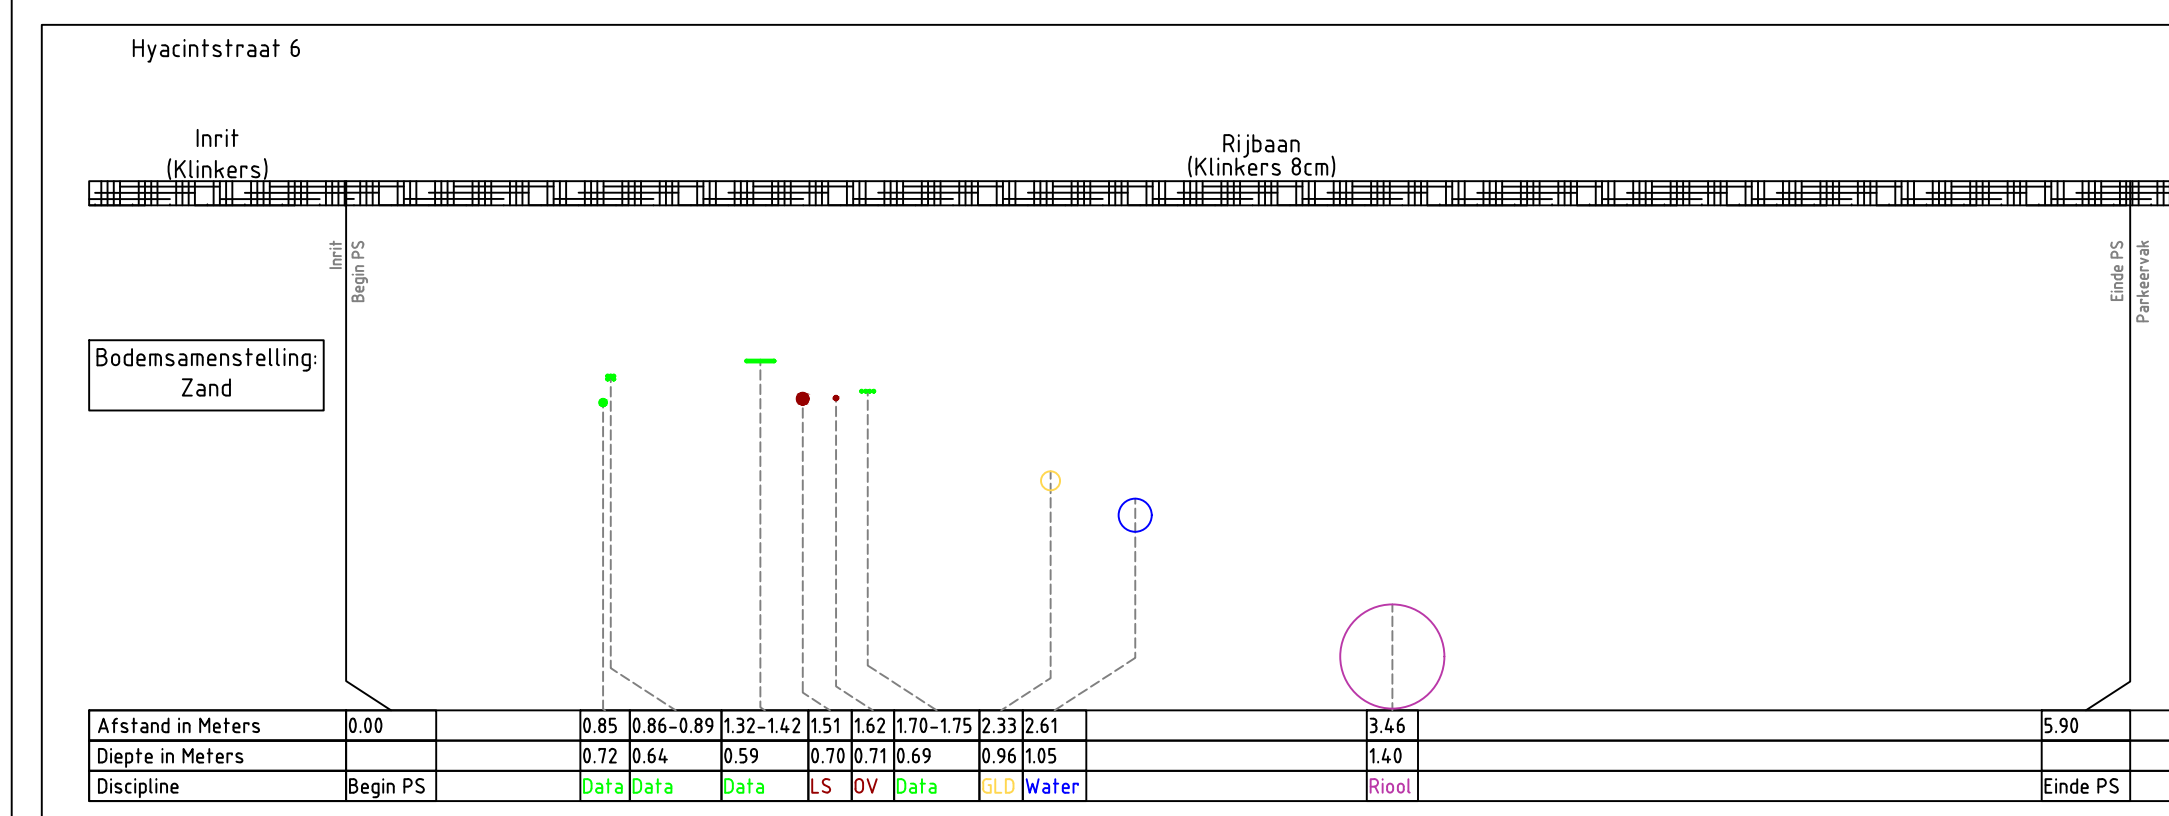
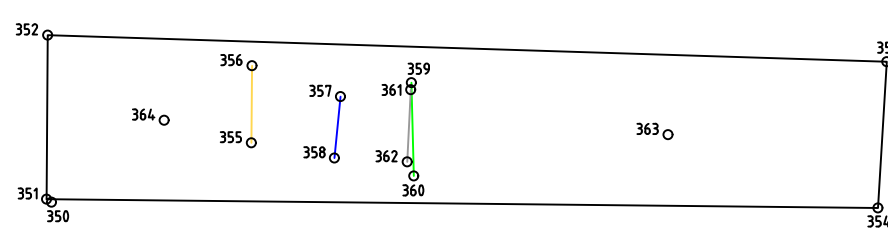










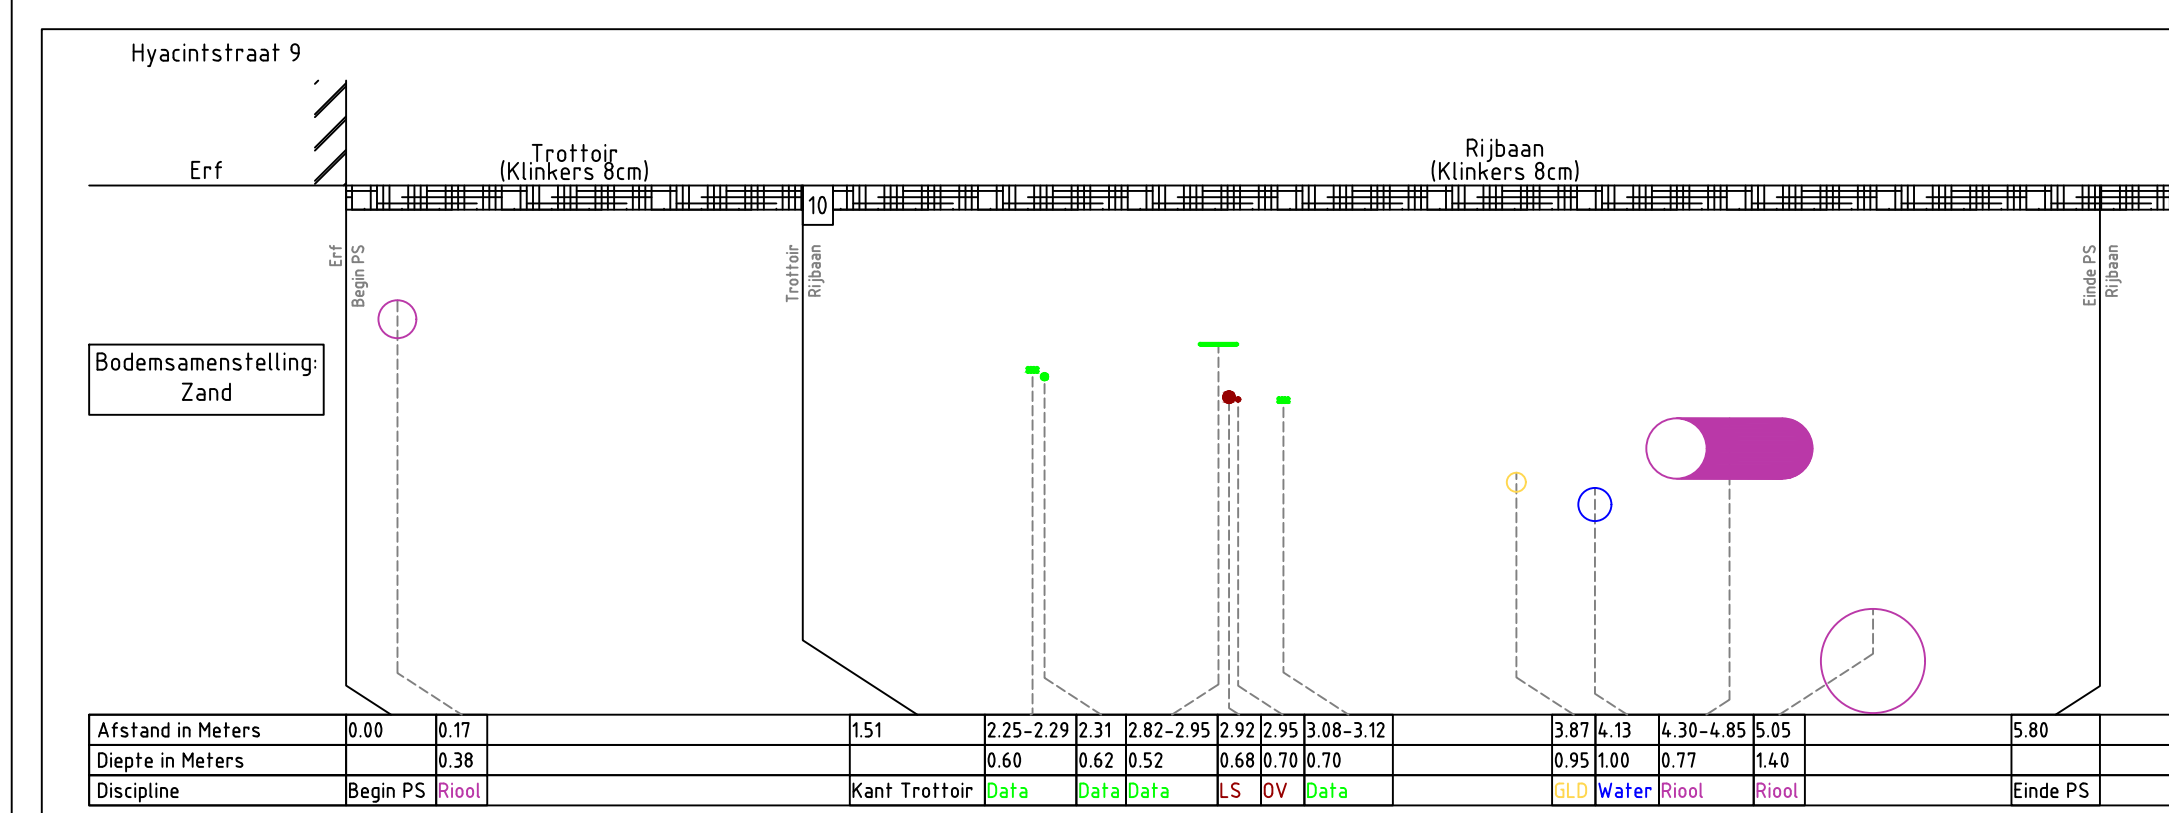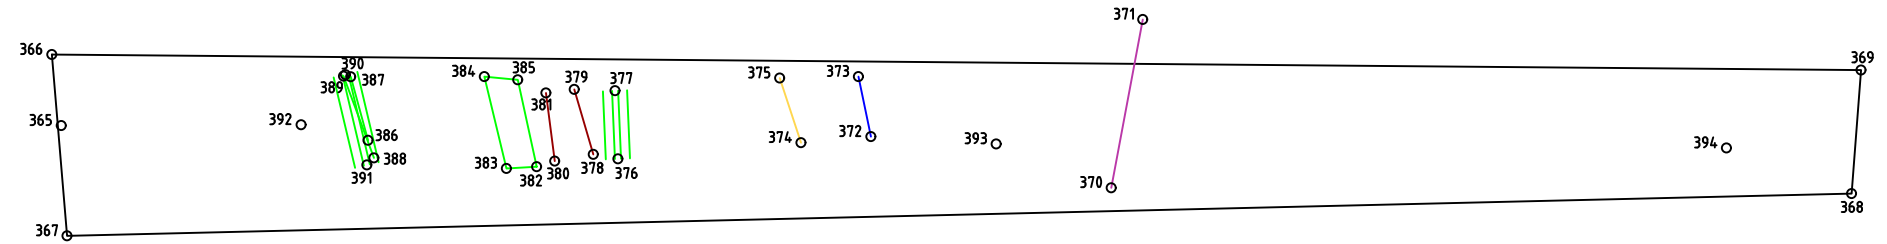[illegible]





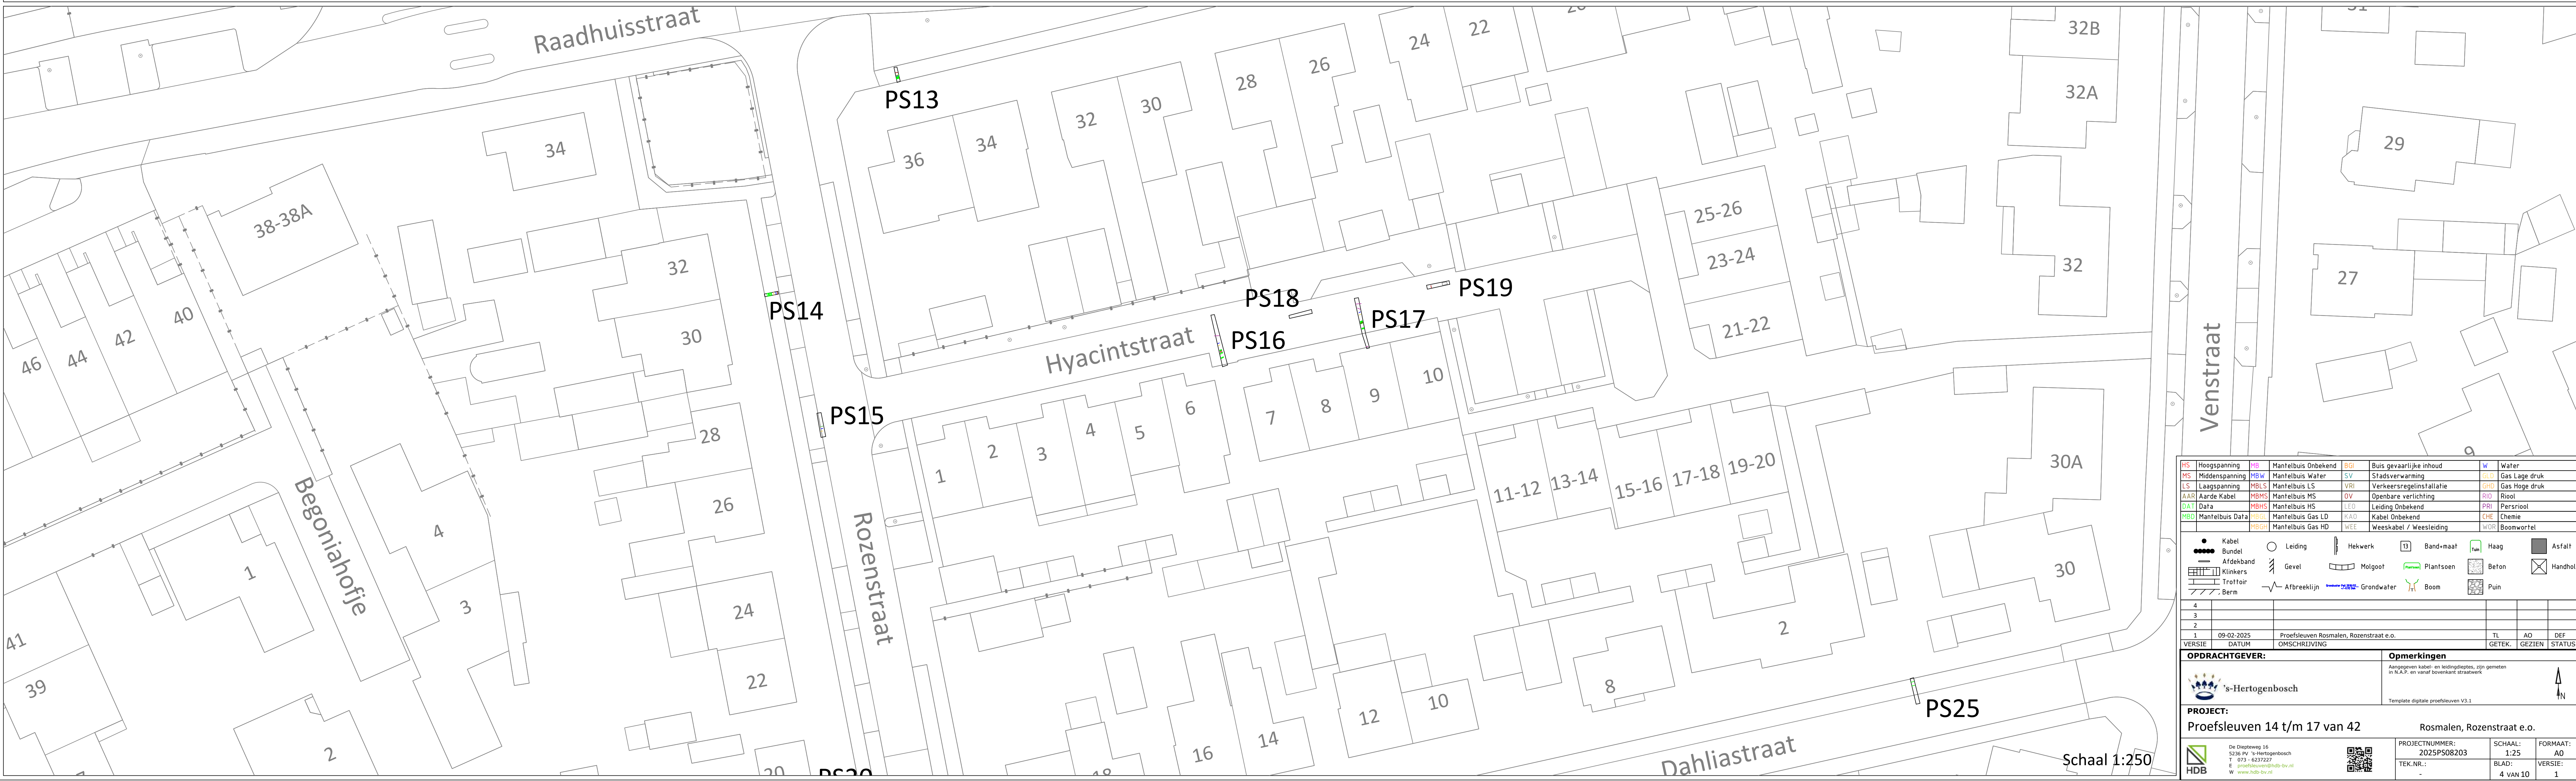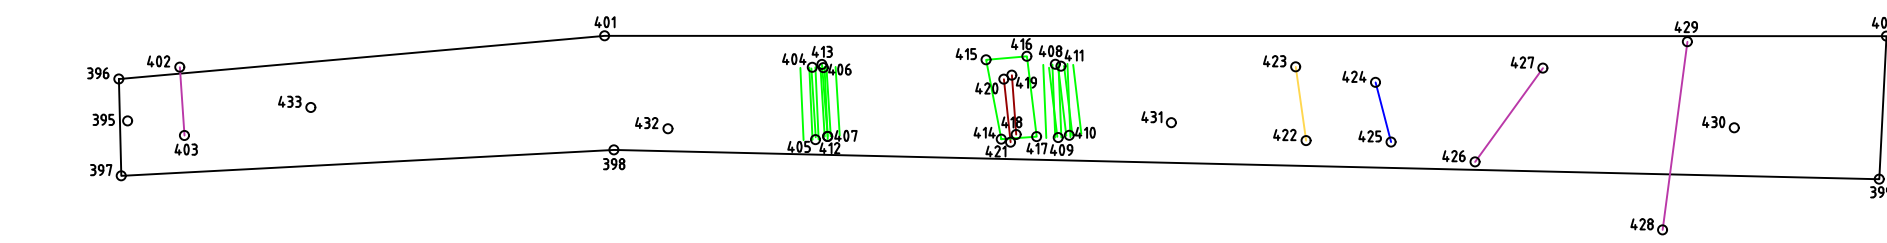

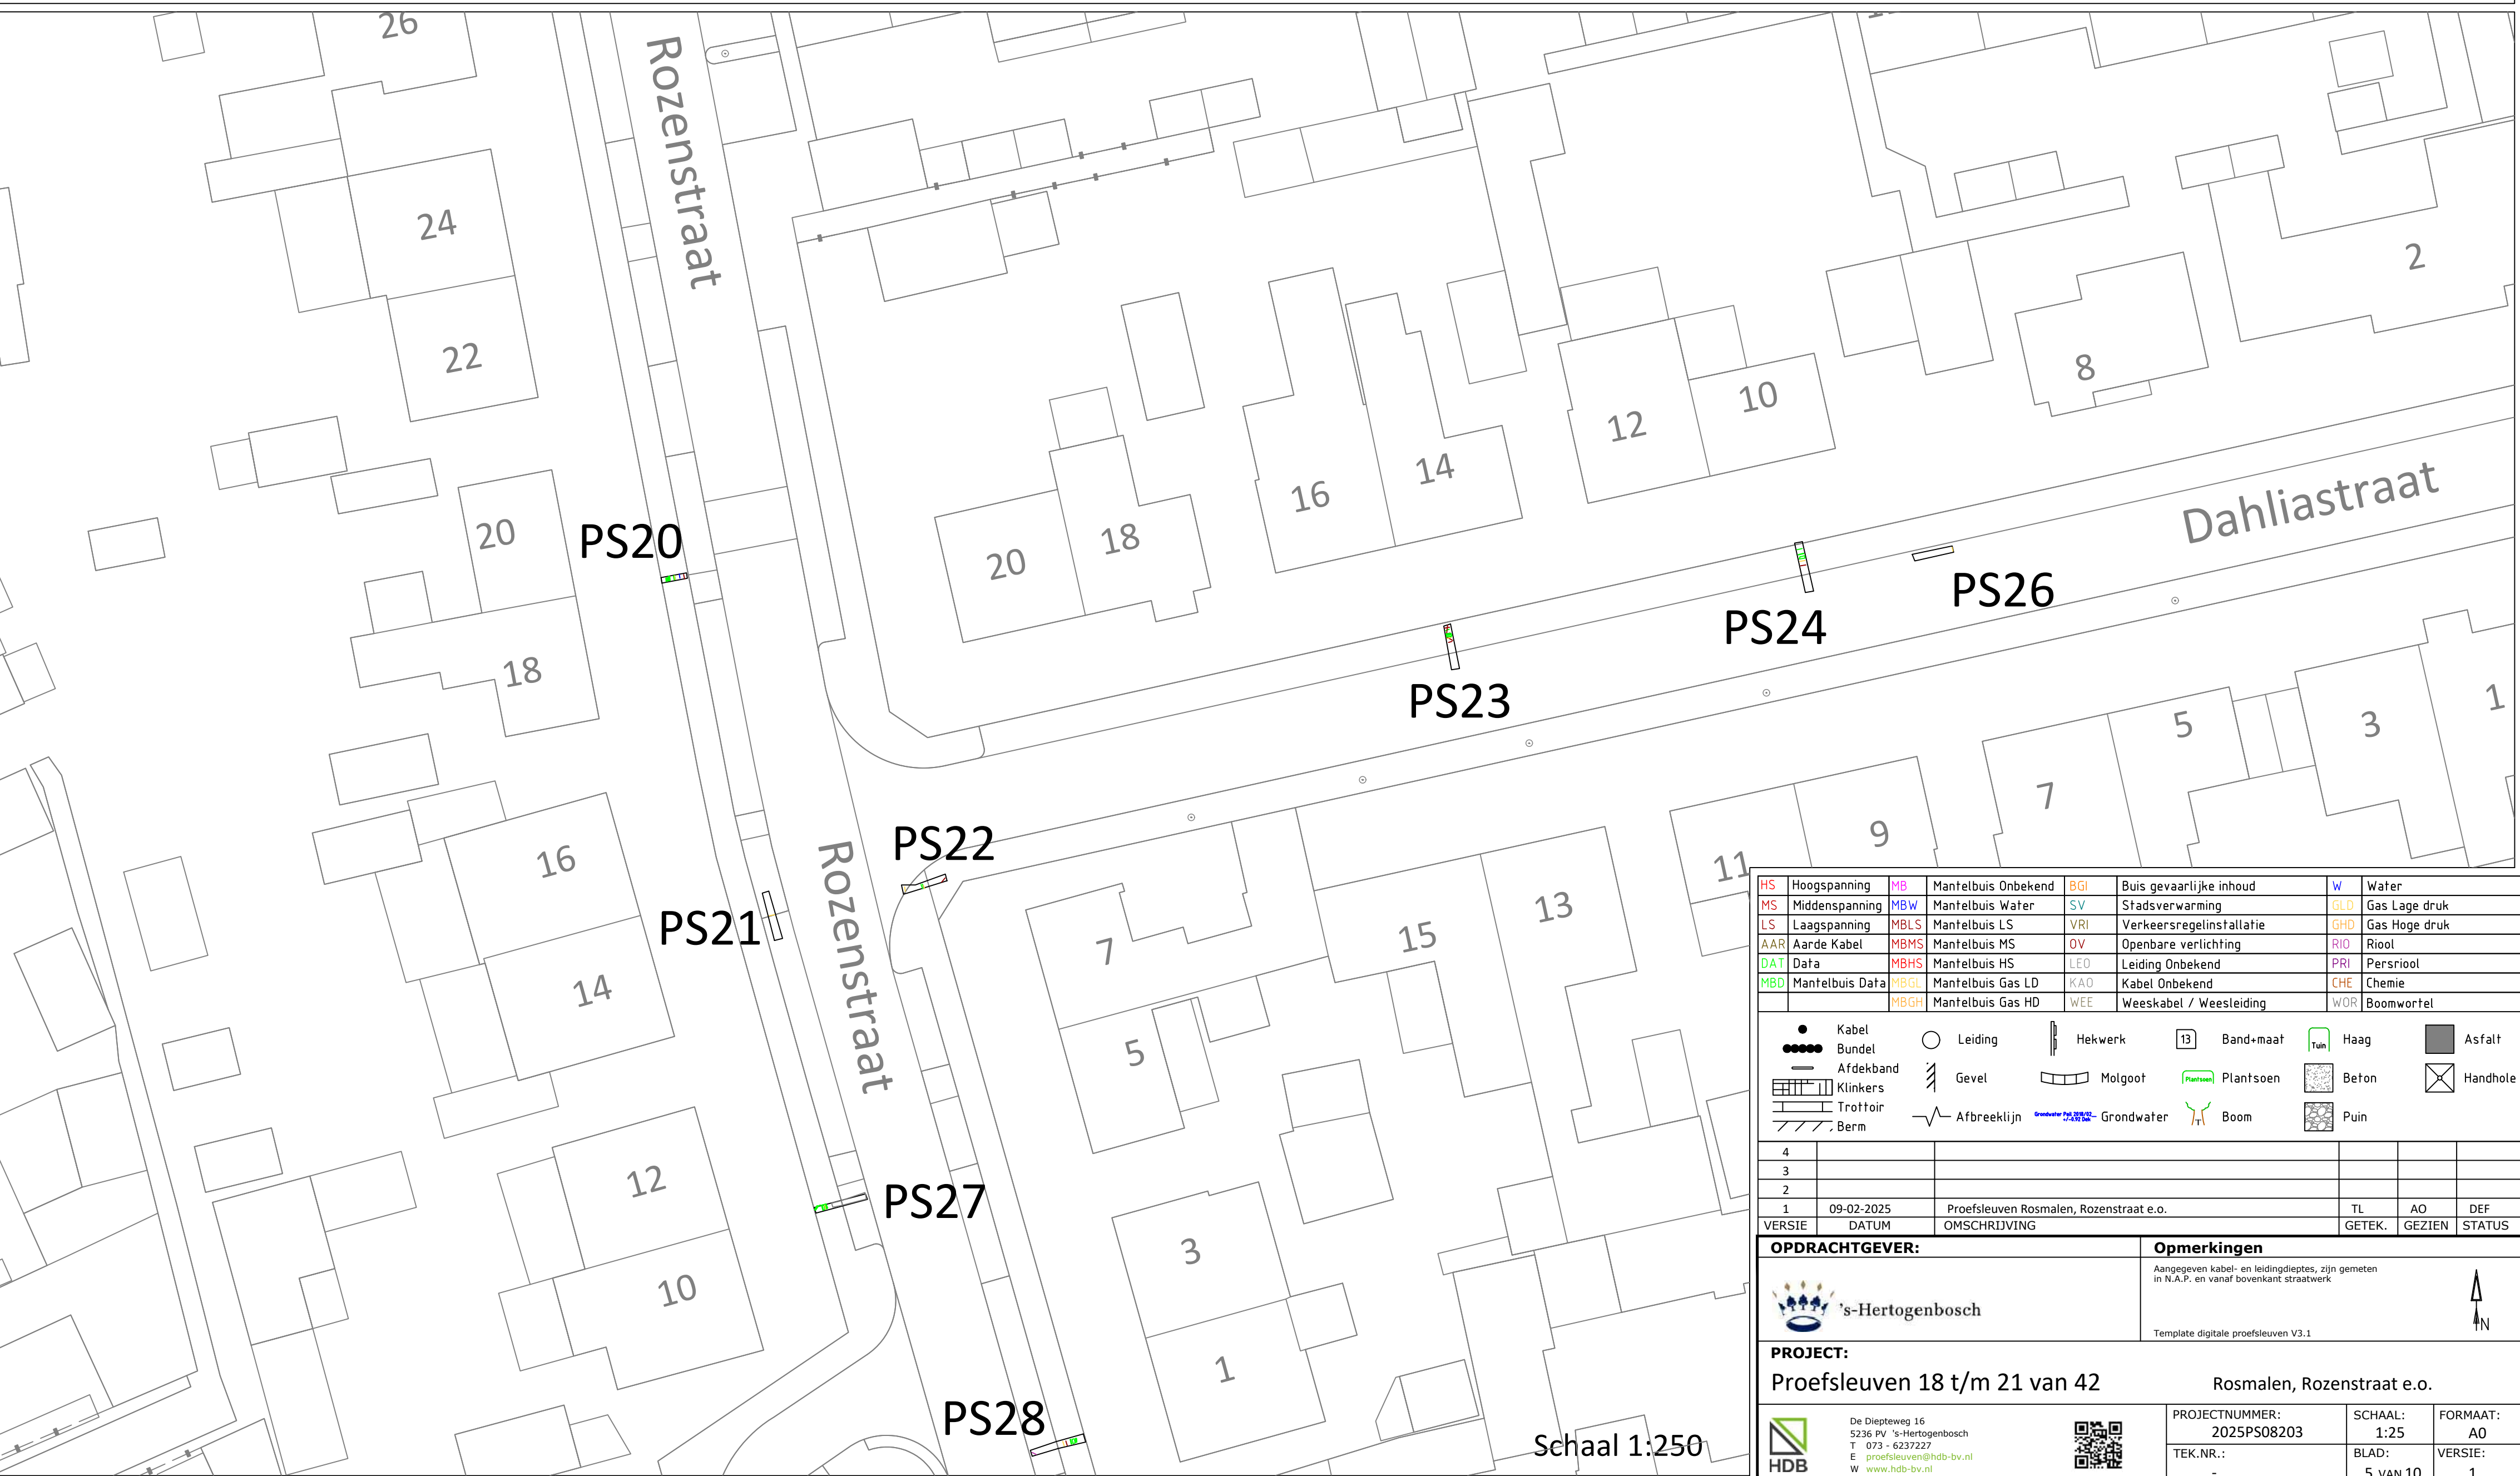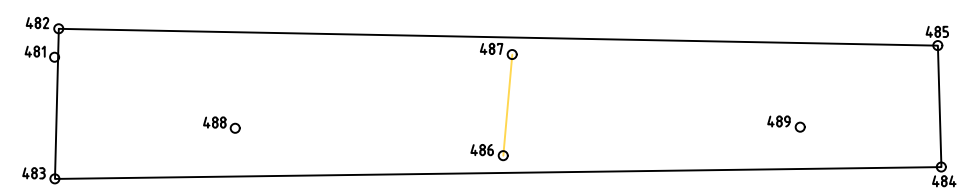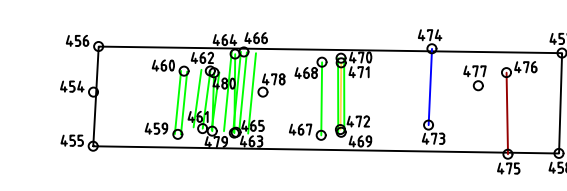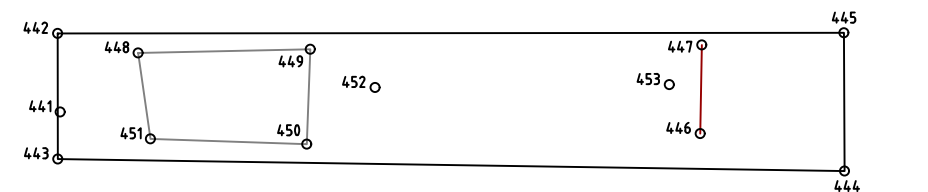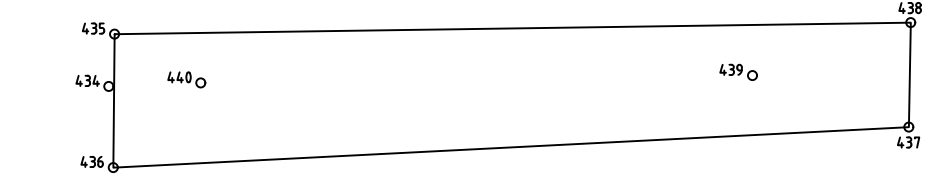


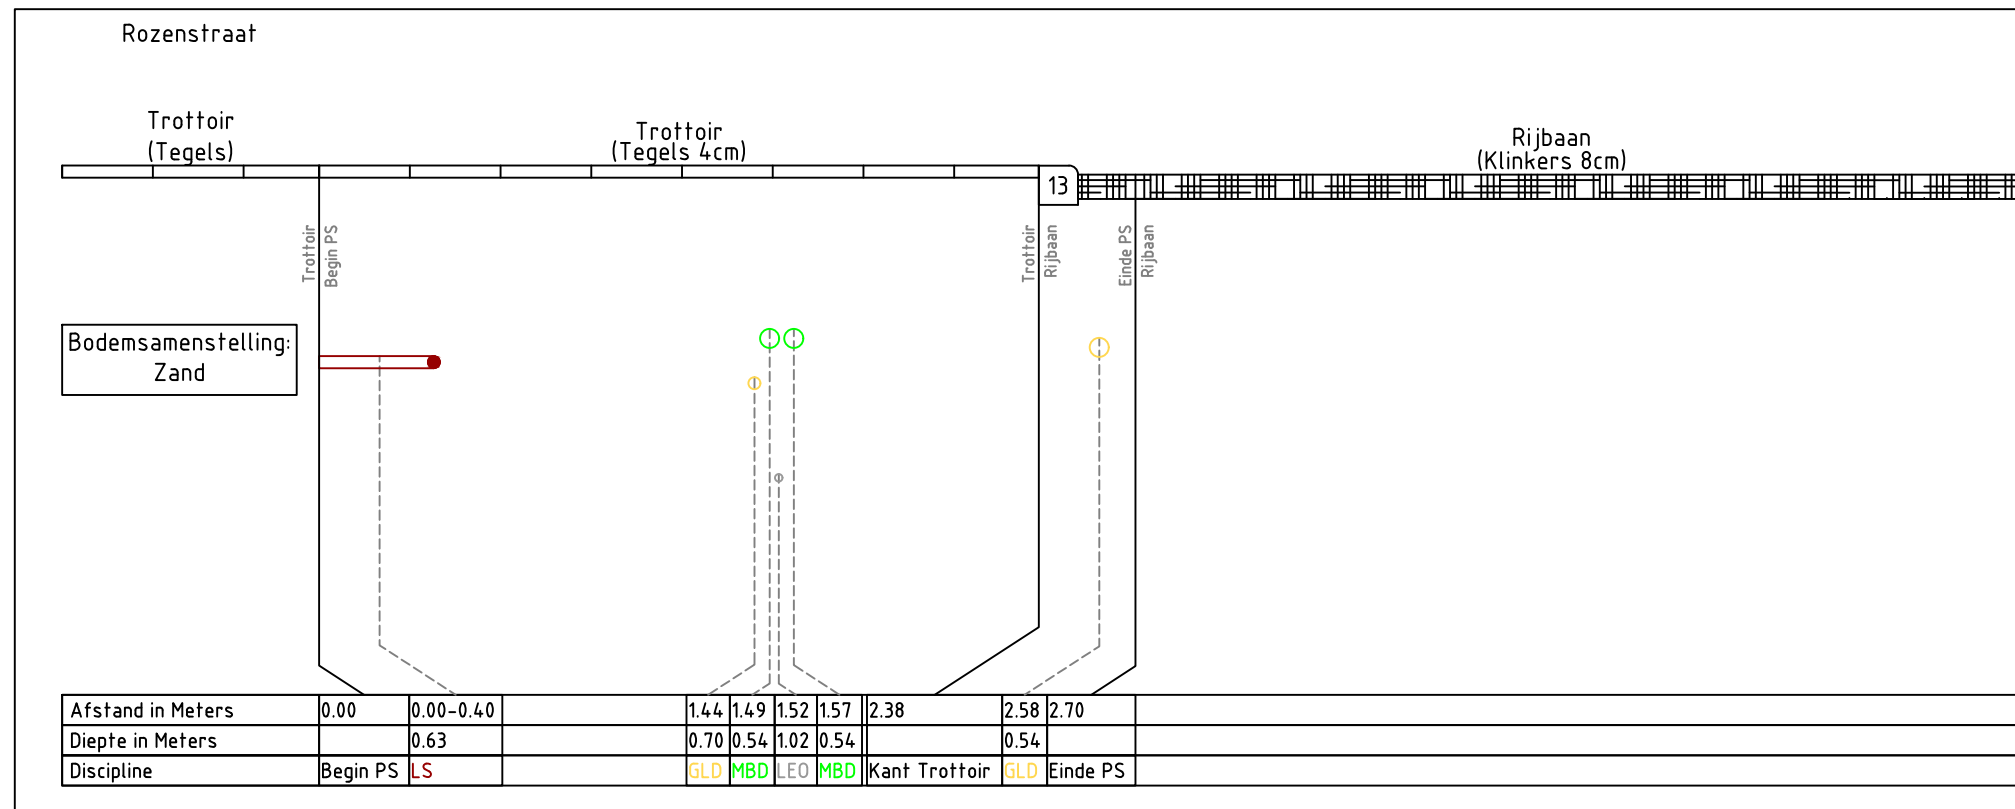



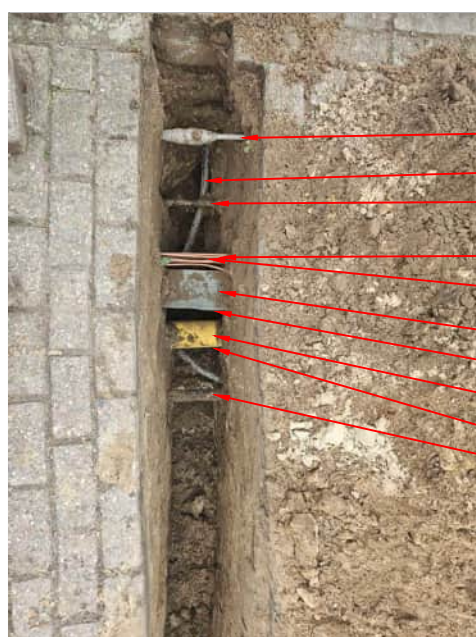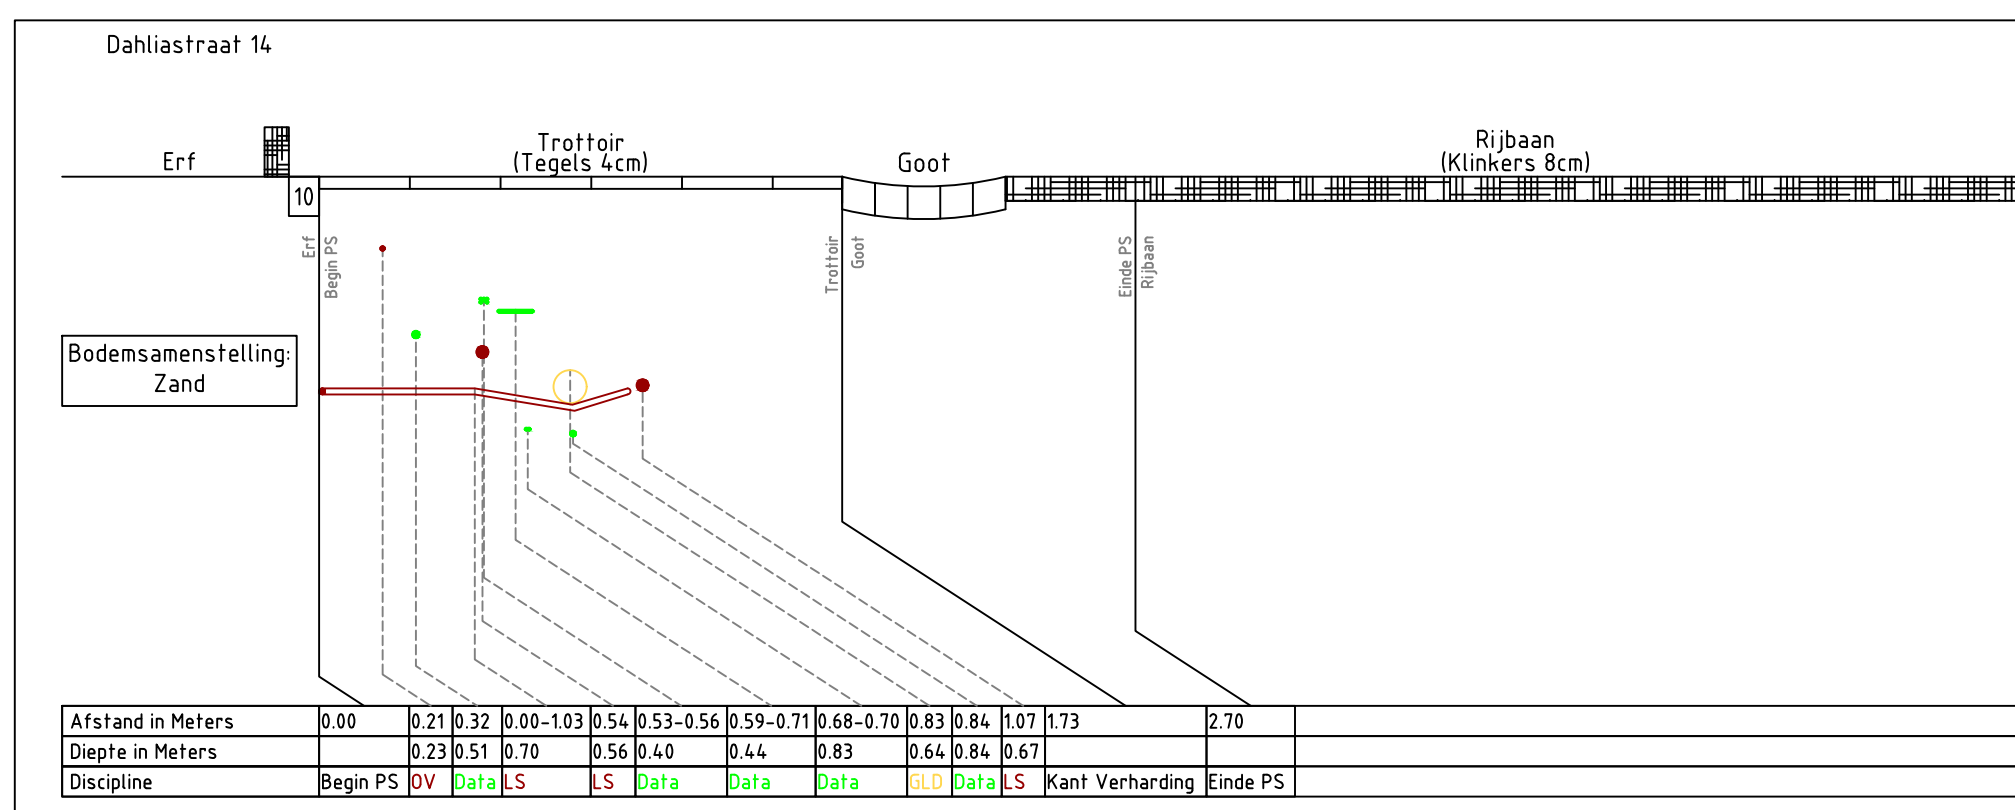
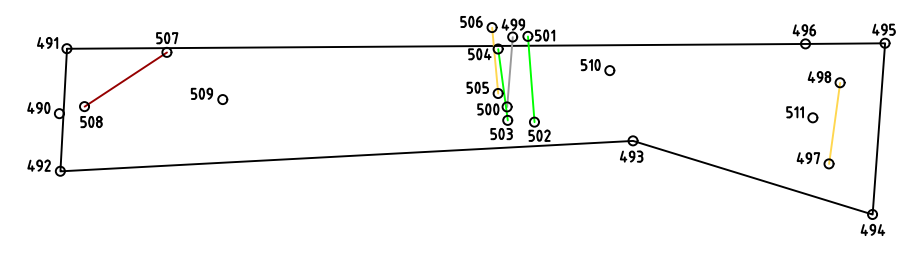


PUNTD	Position X	Position Y	Position Z	Beschrijving
537	152996.94	141087.905	4.629	Data -25mm XGS 2x
538	152996.869	141087.748	4.576	Lagedruk gas - SPVC - Ø10mm
539	152996.900	141087.673	4.576	Lagedruk gas - SPVC - Ø10mm
543	152996.351	141088.111	4.798	Ontgravingdiepte
541	152995.928	141088.878	4.701	Ontgravingdiepte
542	152996.866	141087.305	4.671	Data -25mm XGS
543	152995.956	141087.796	4.663	Data -25mm XGS

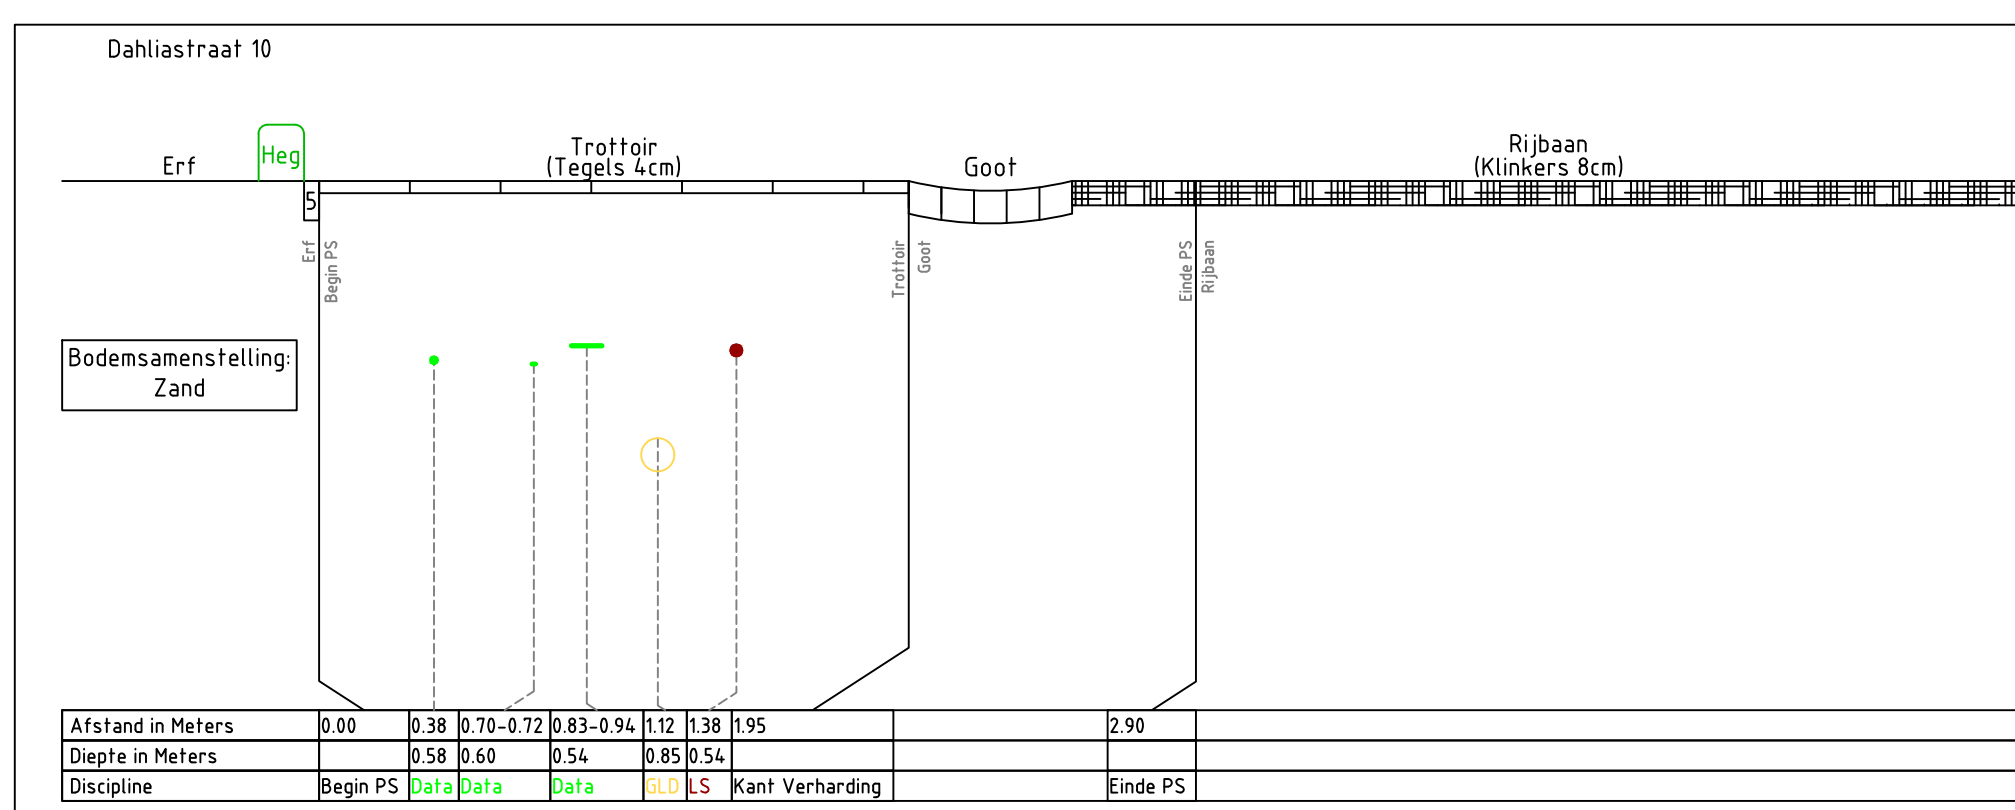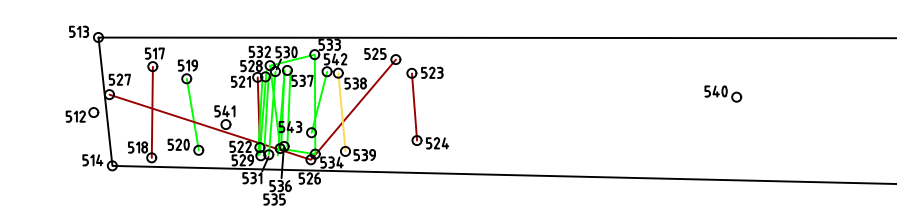




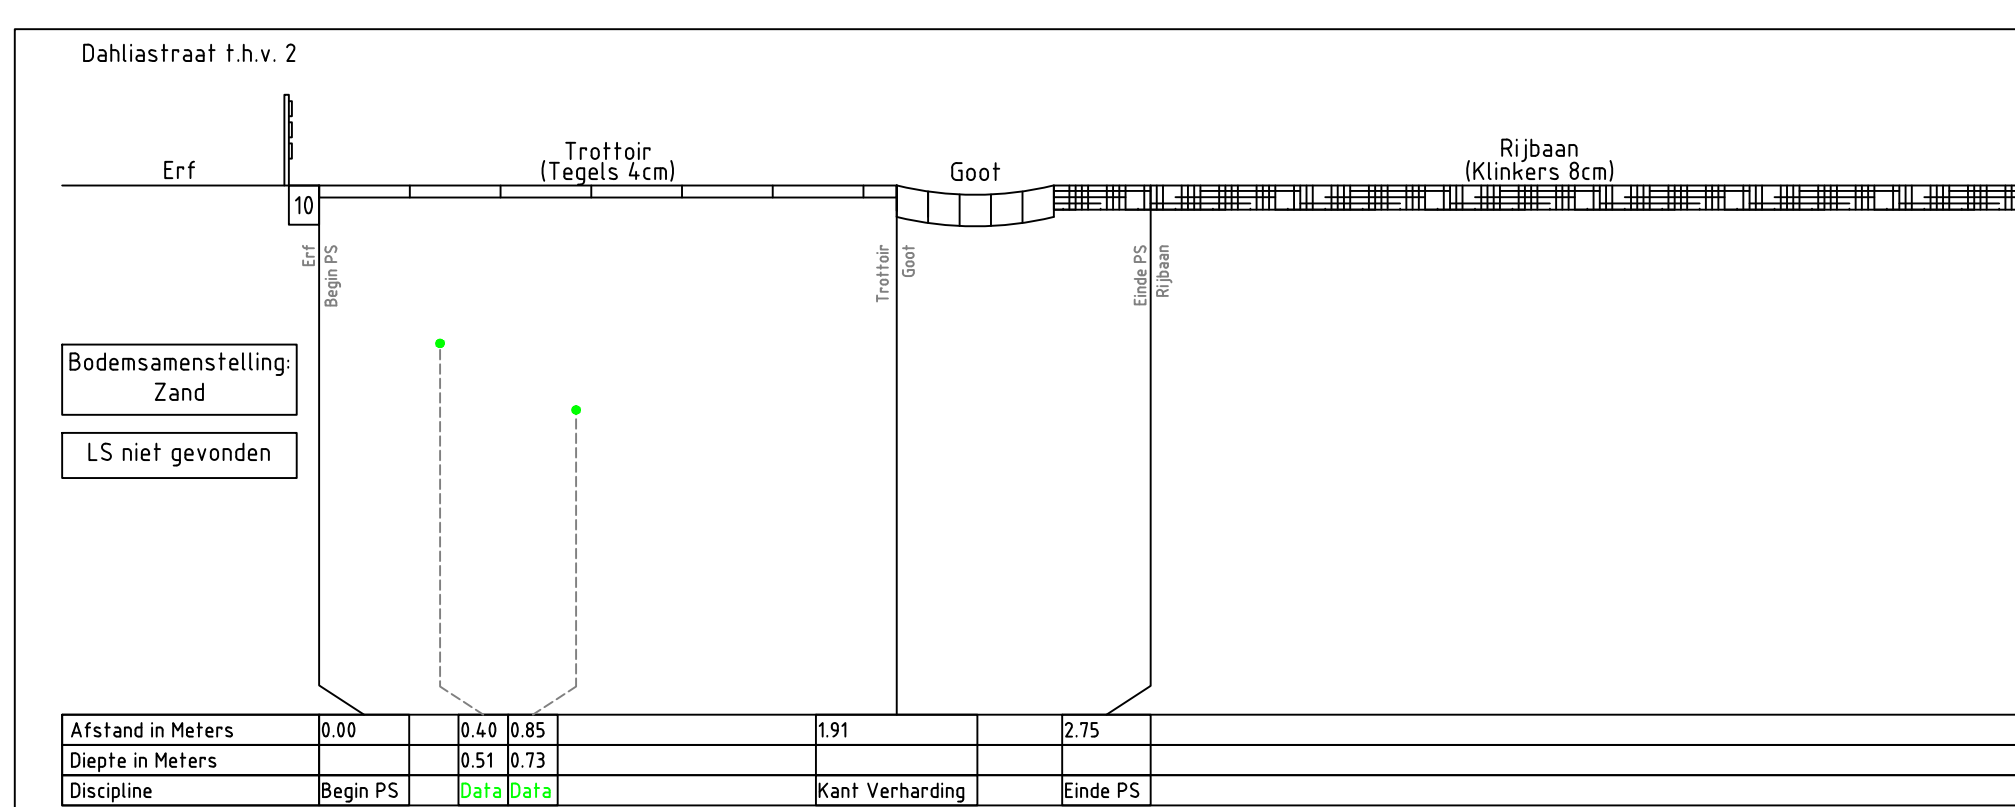
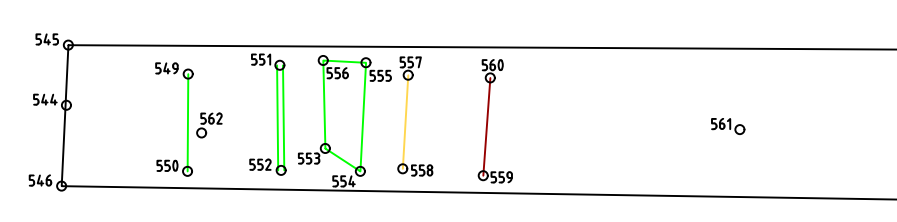



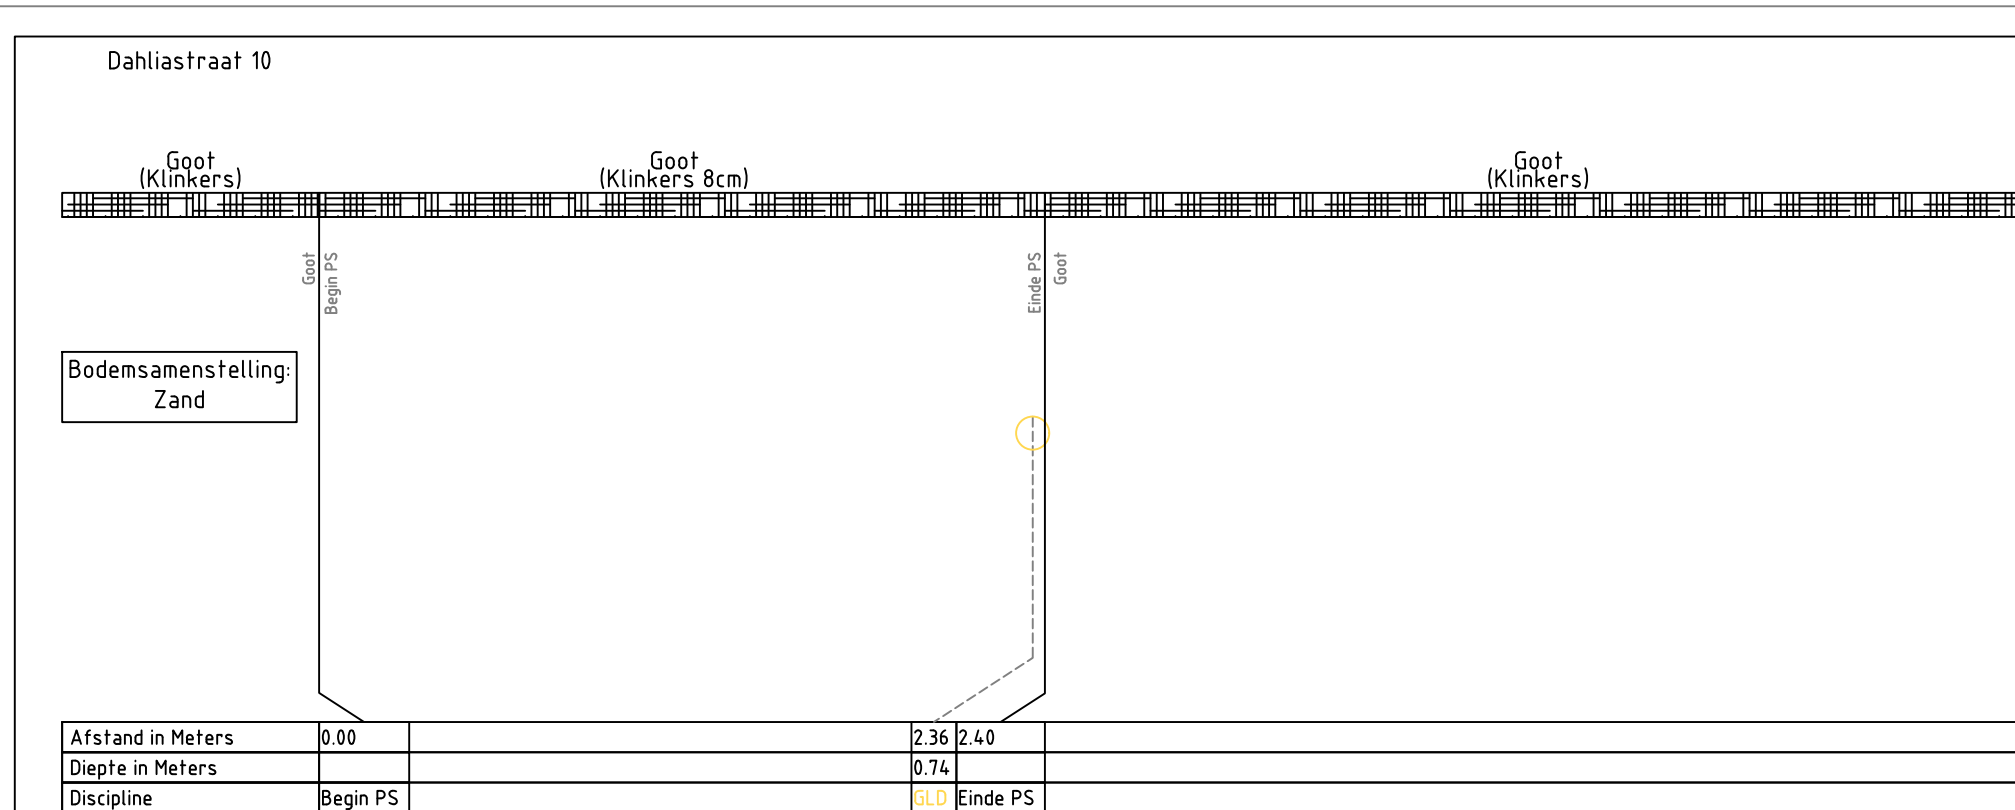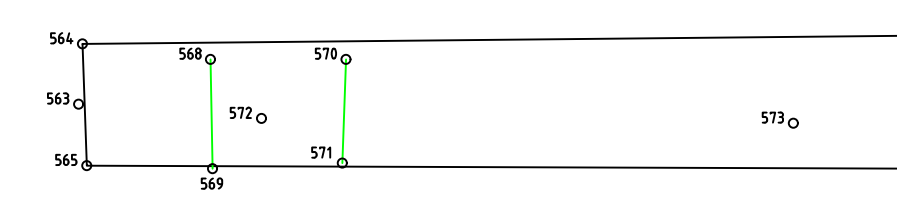





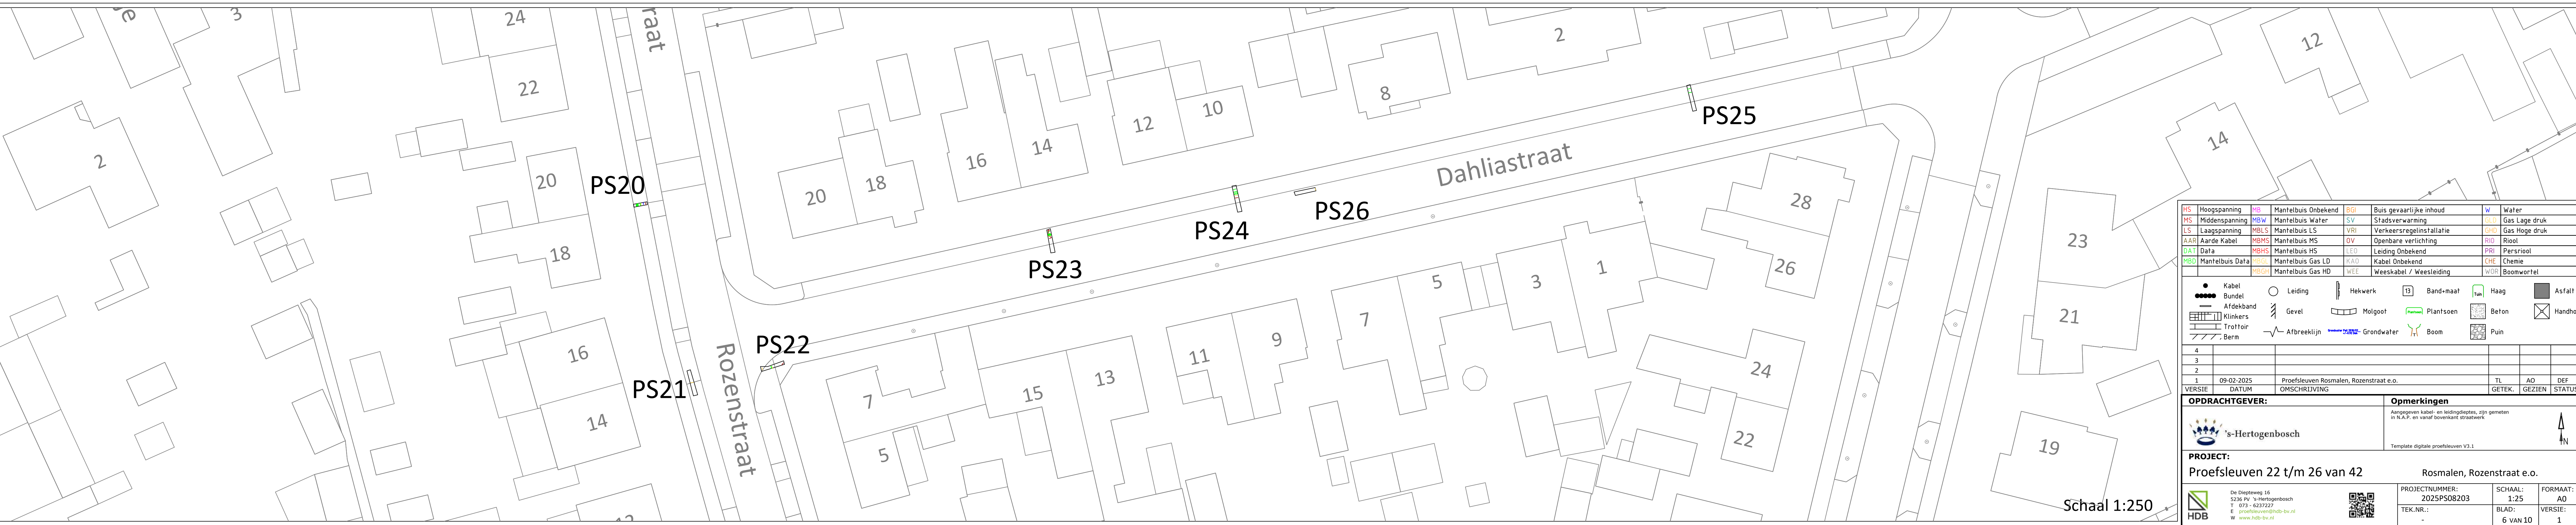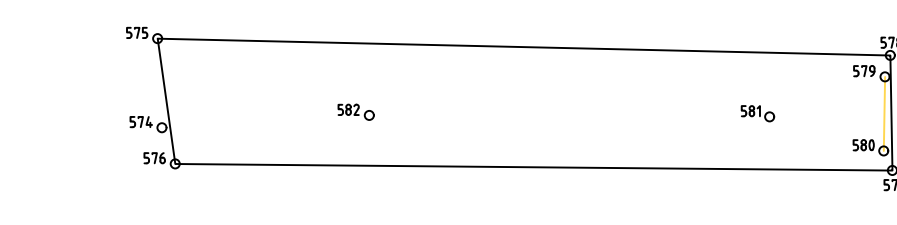





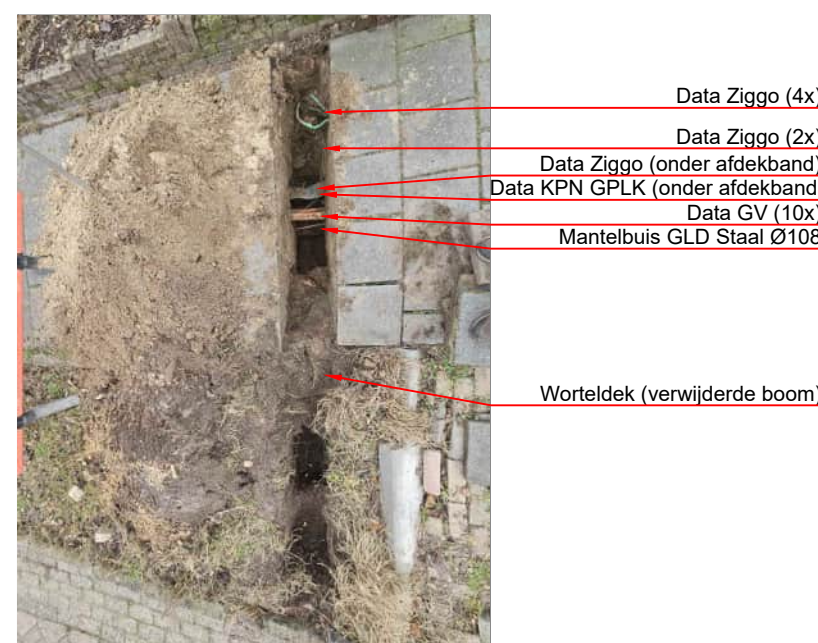
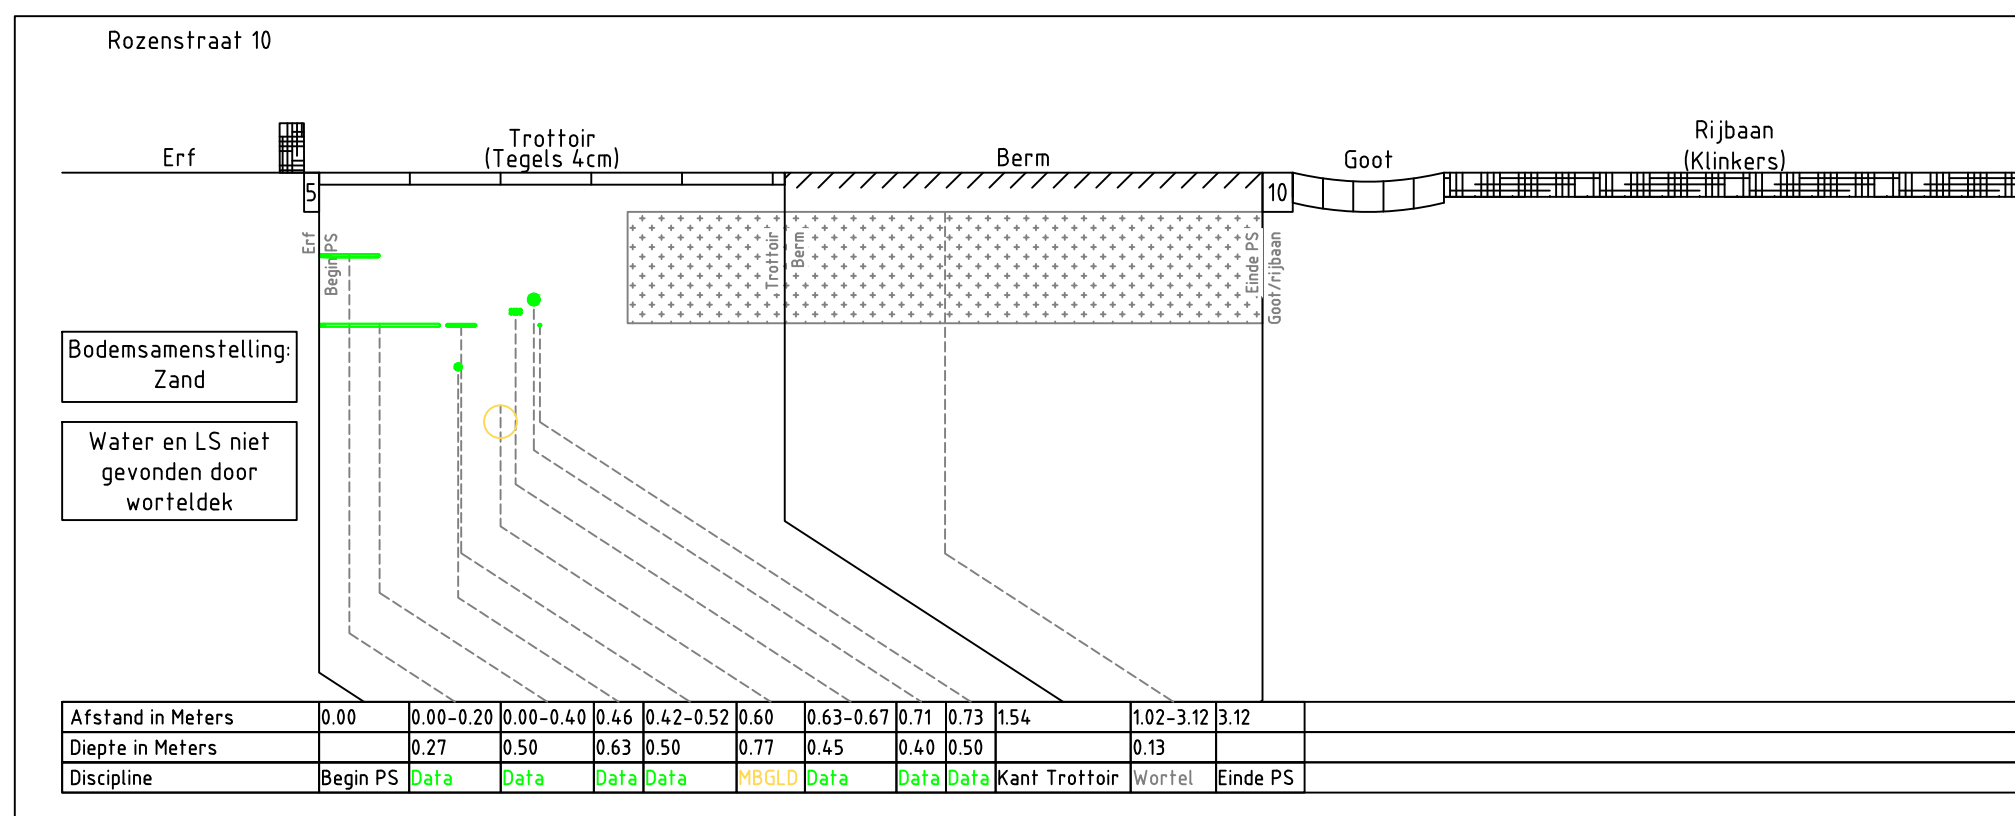



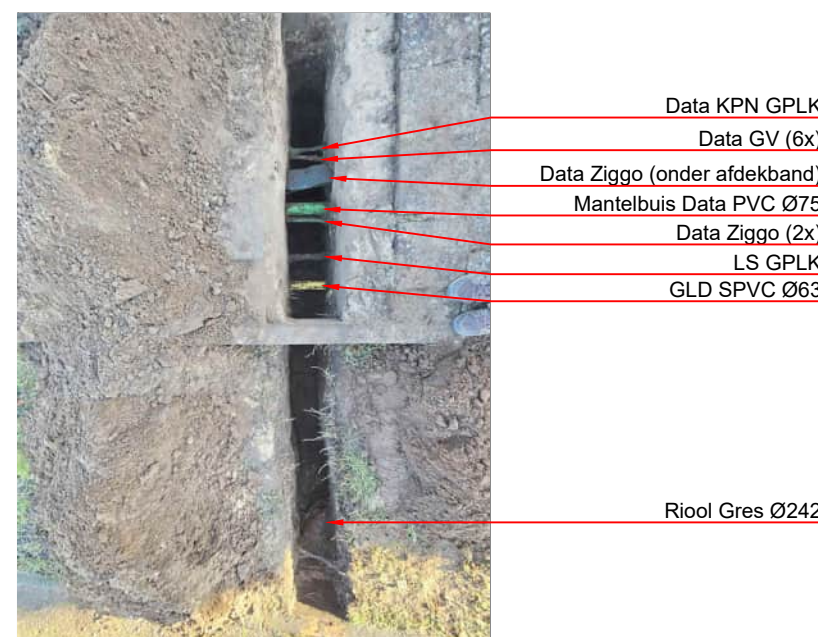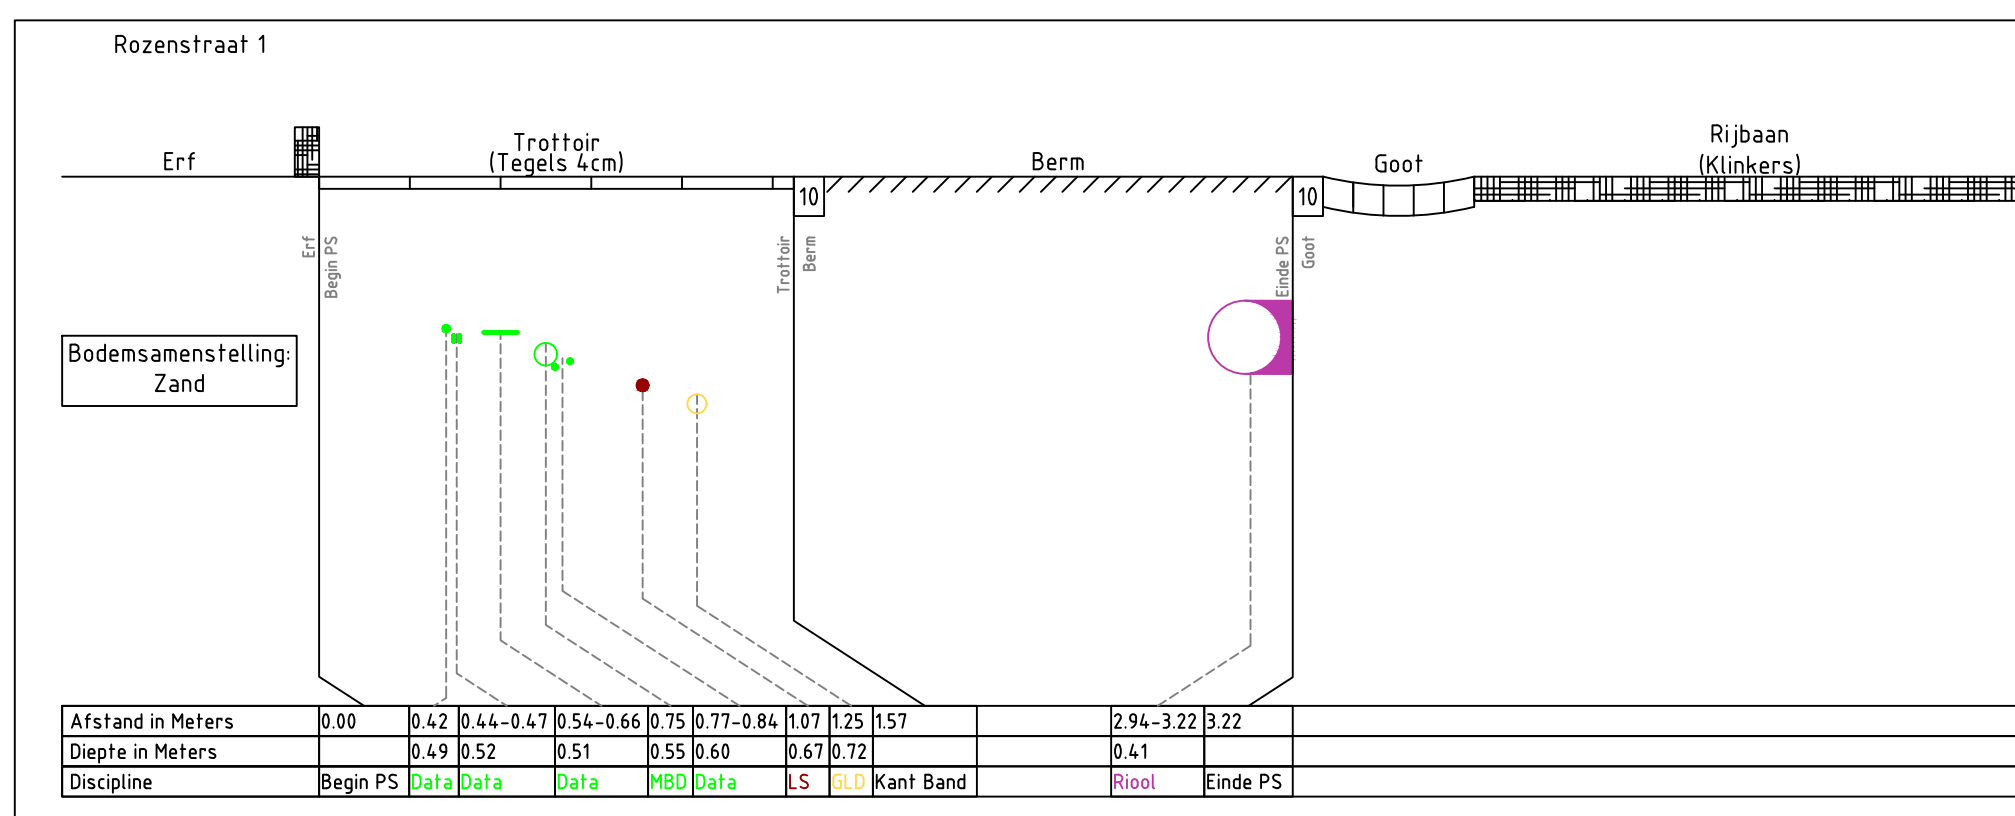
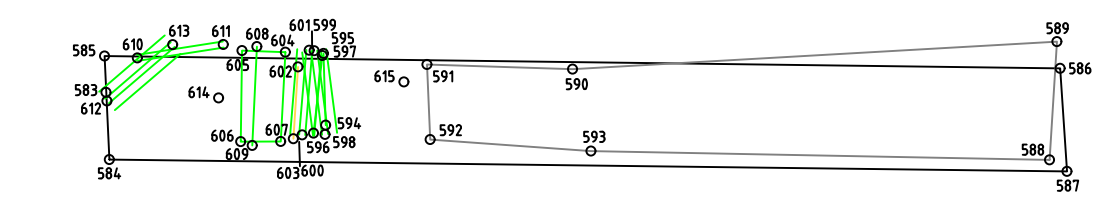
[illegible]


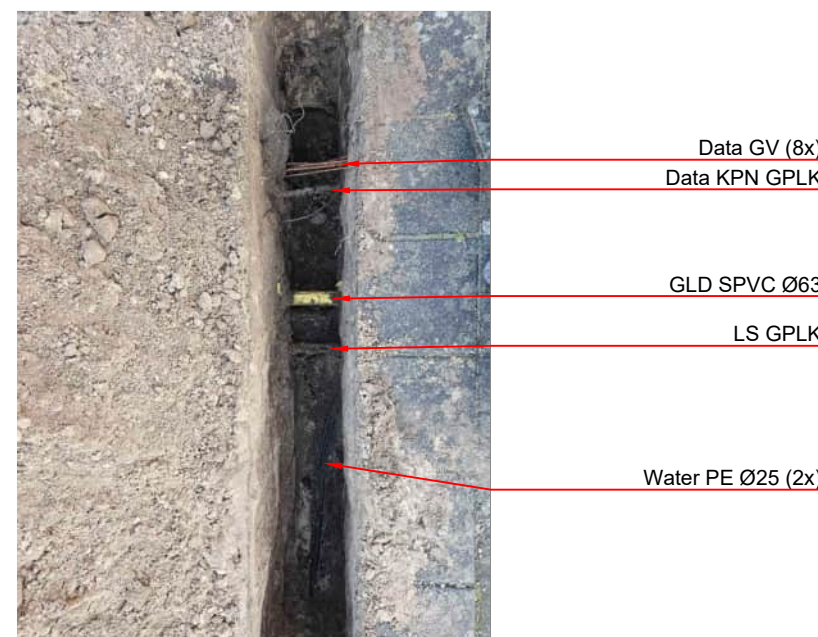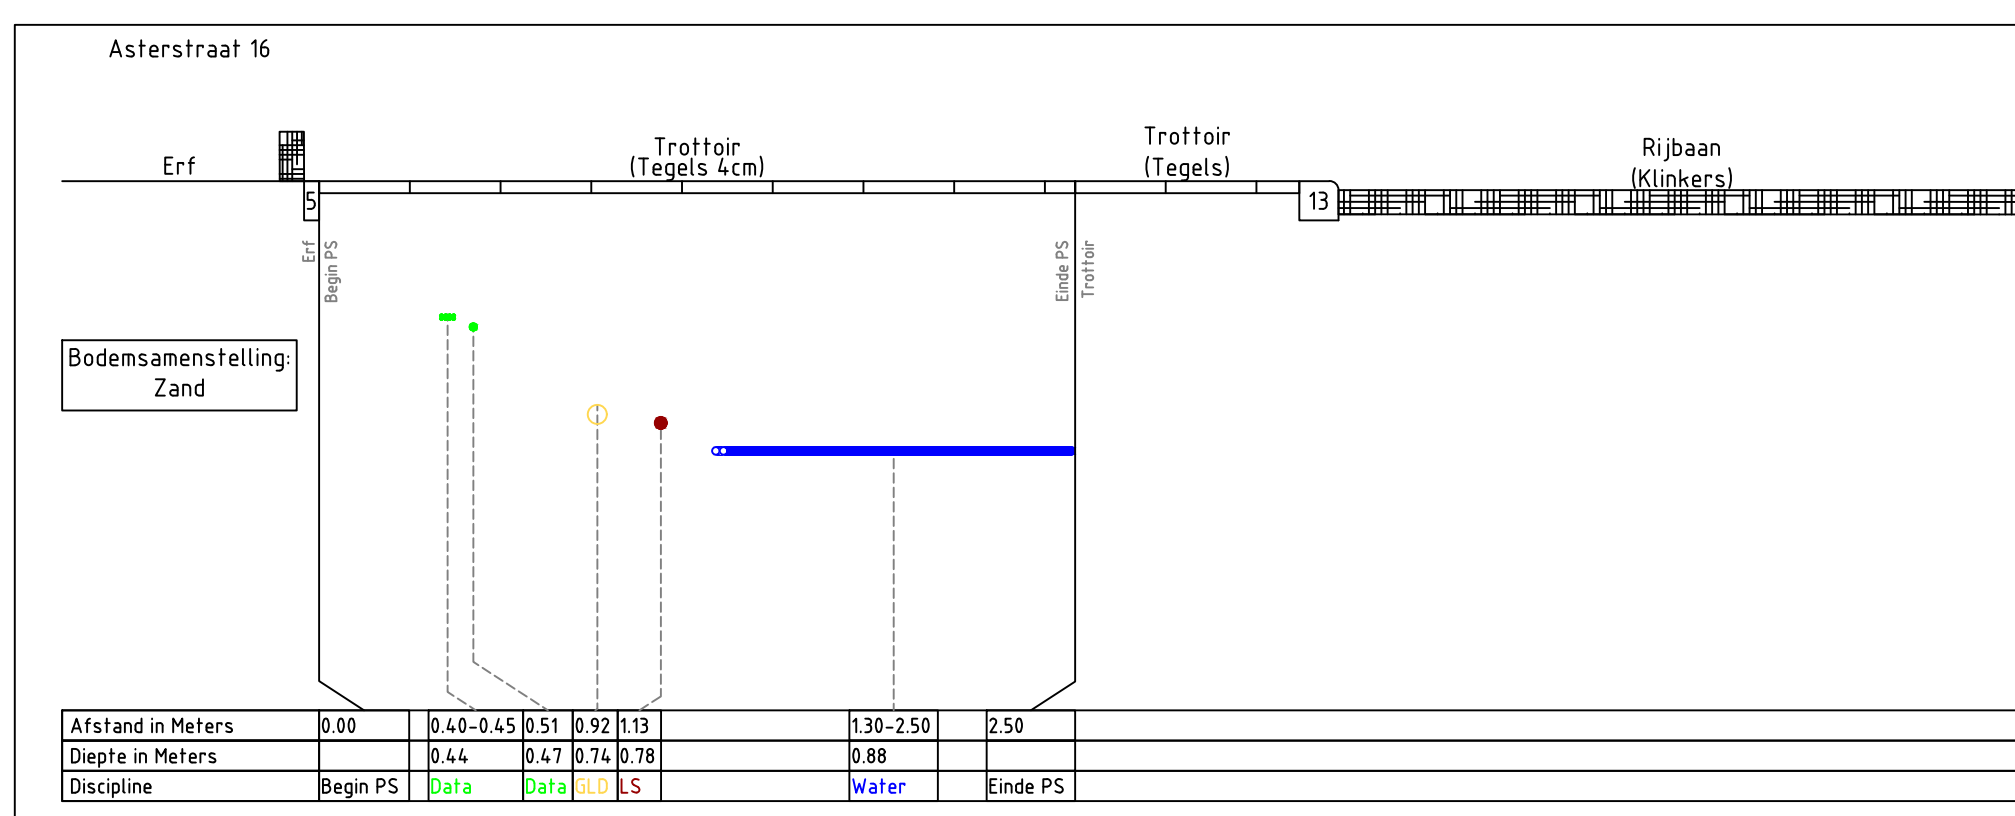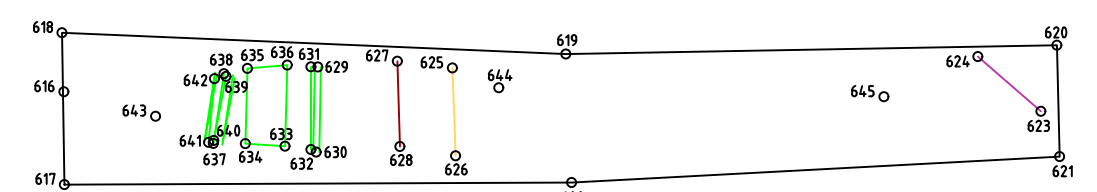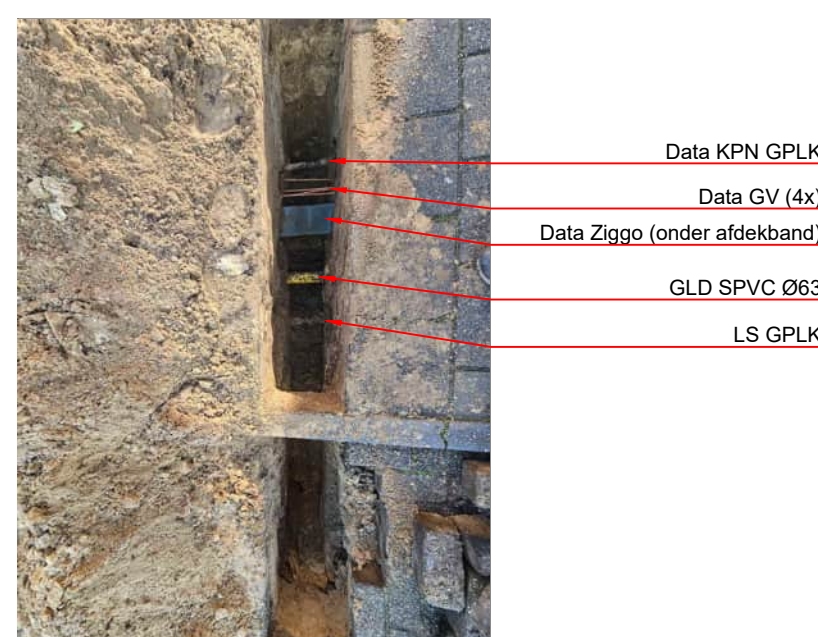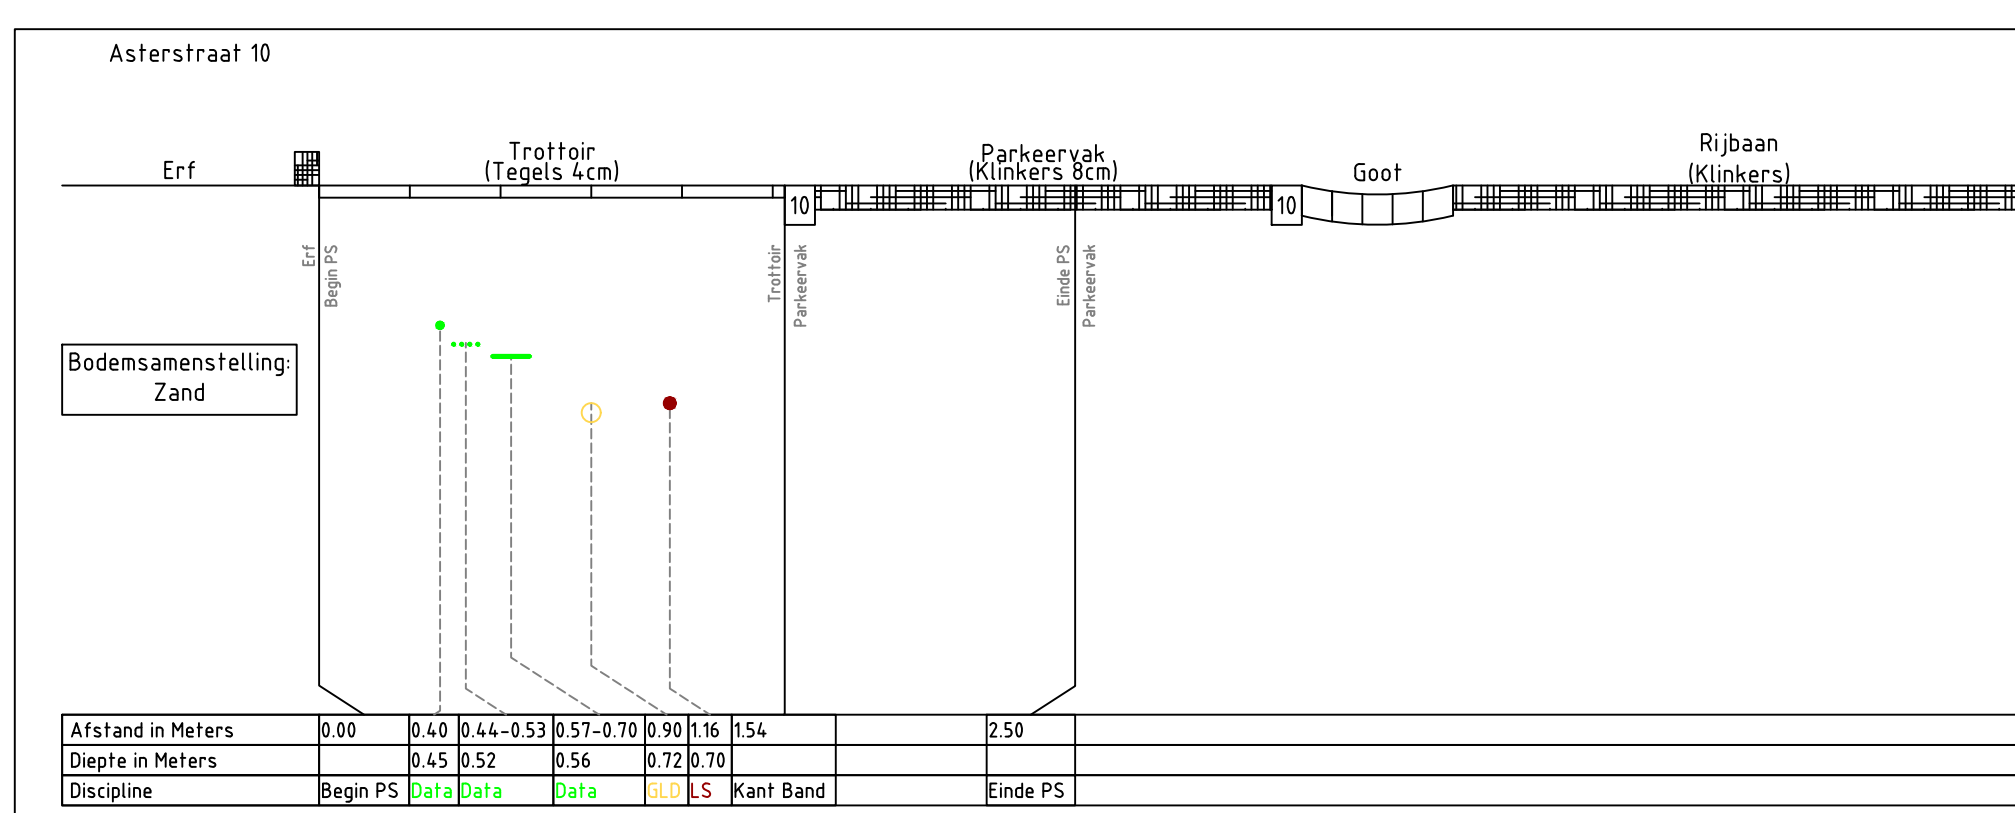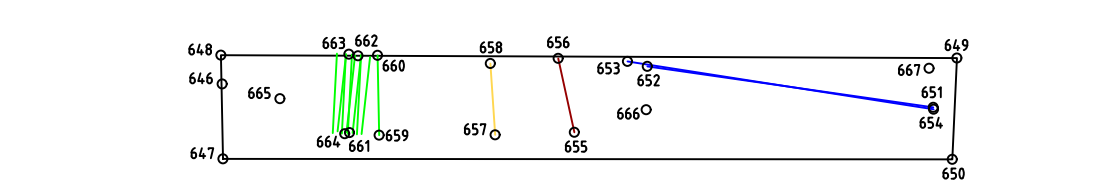[illegible]



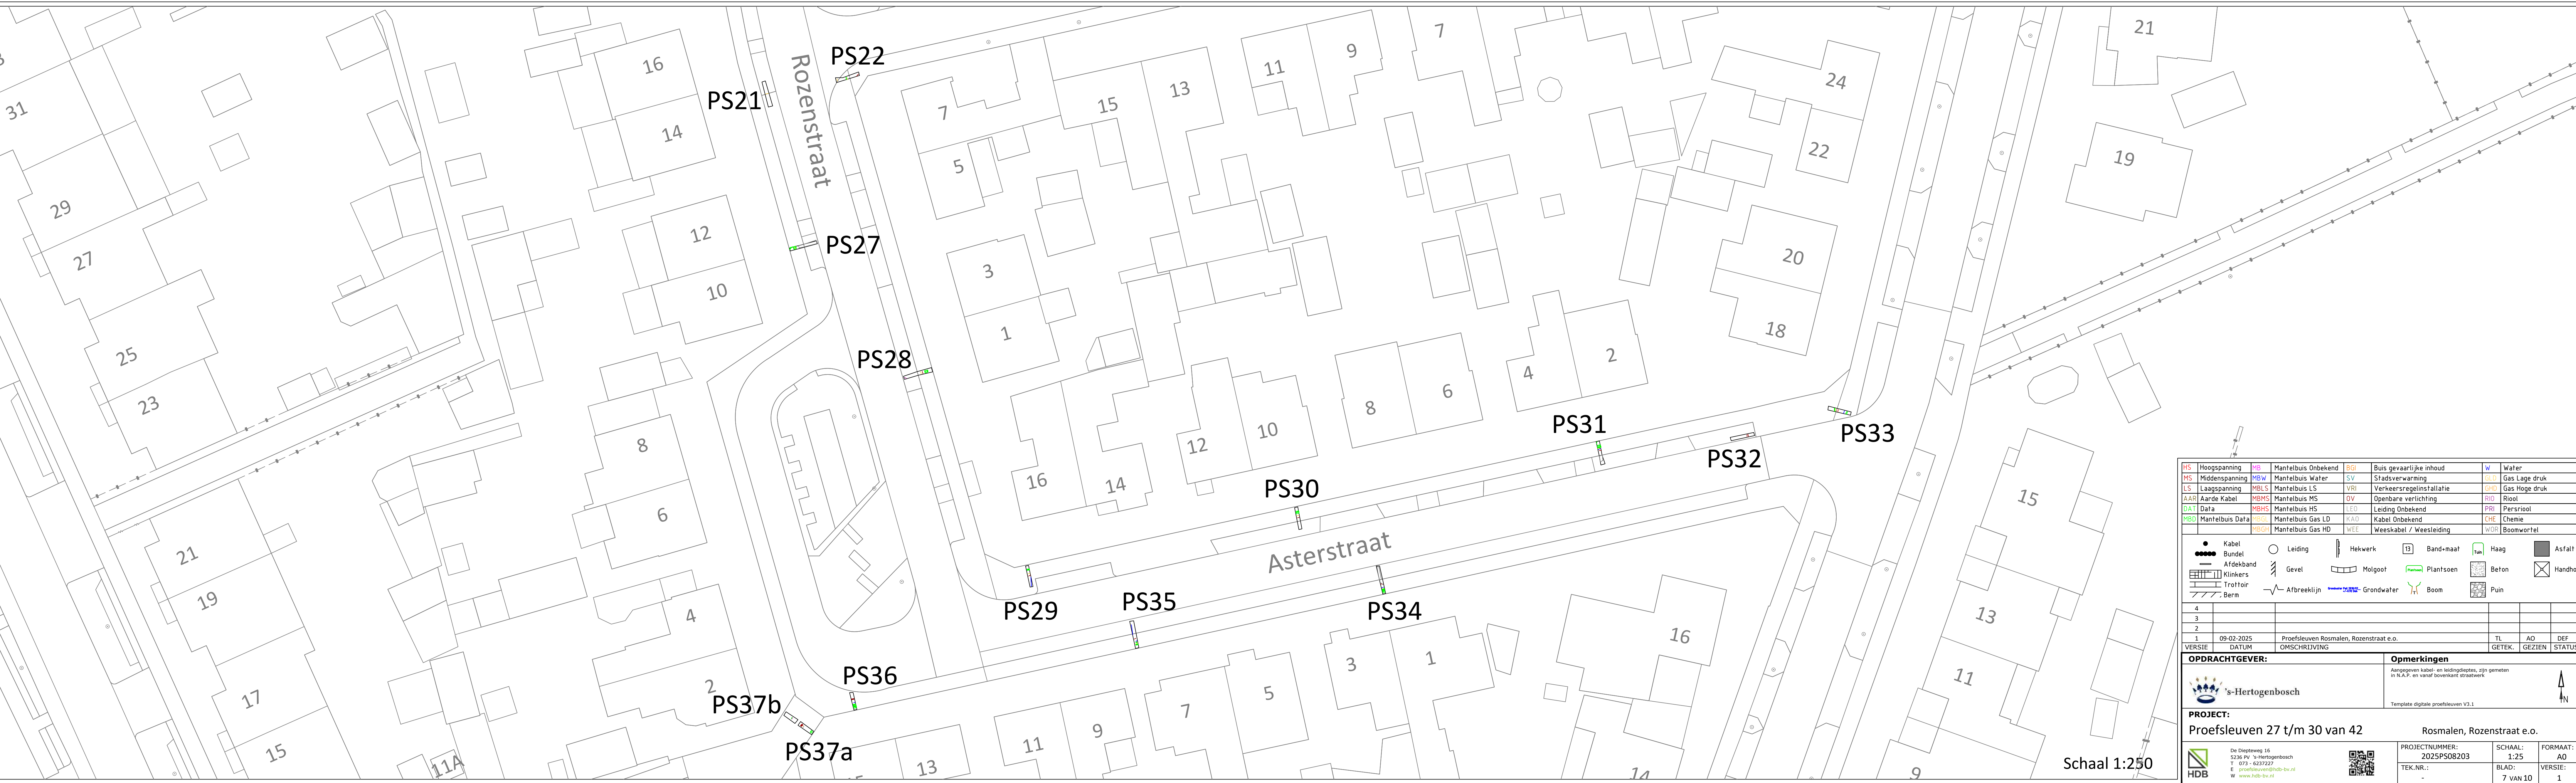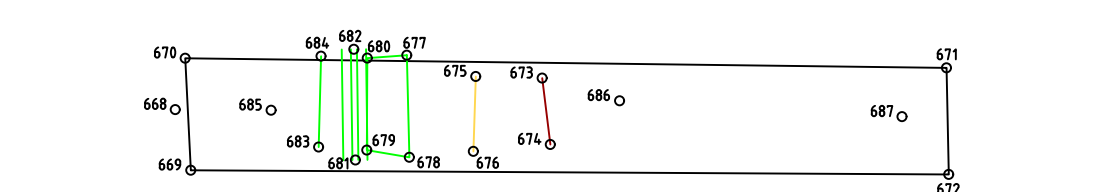



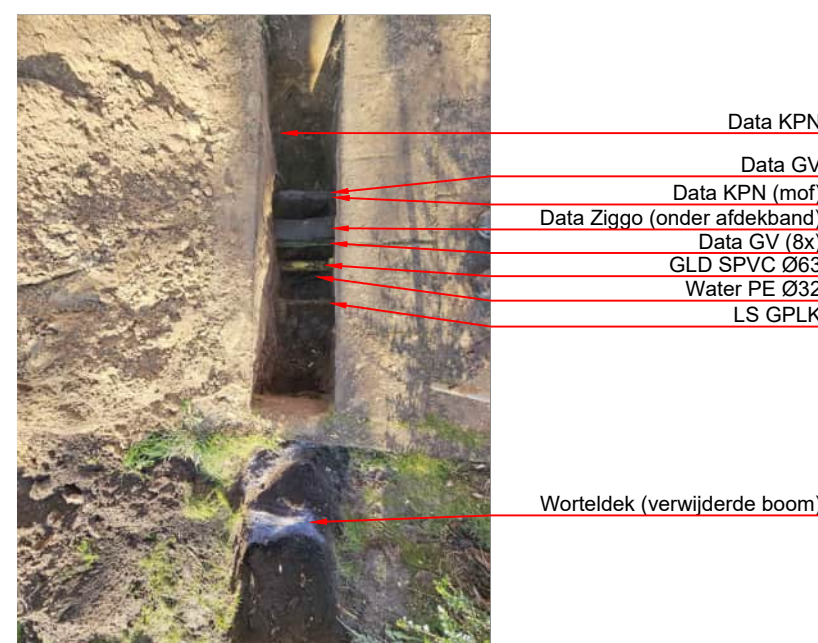
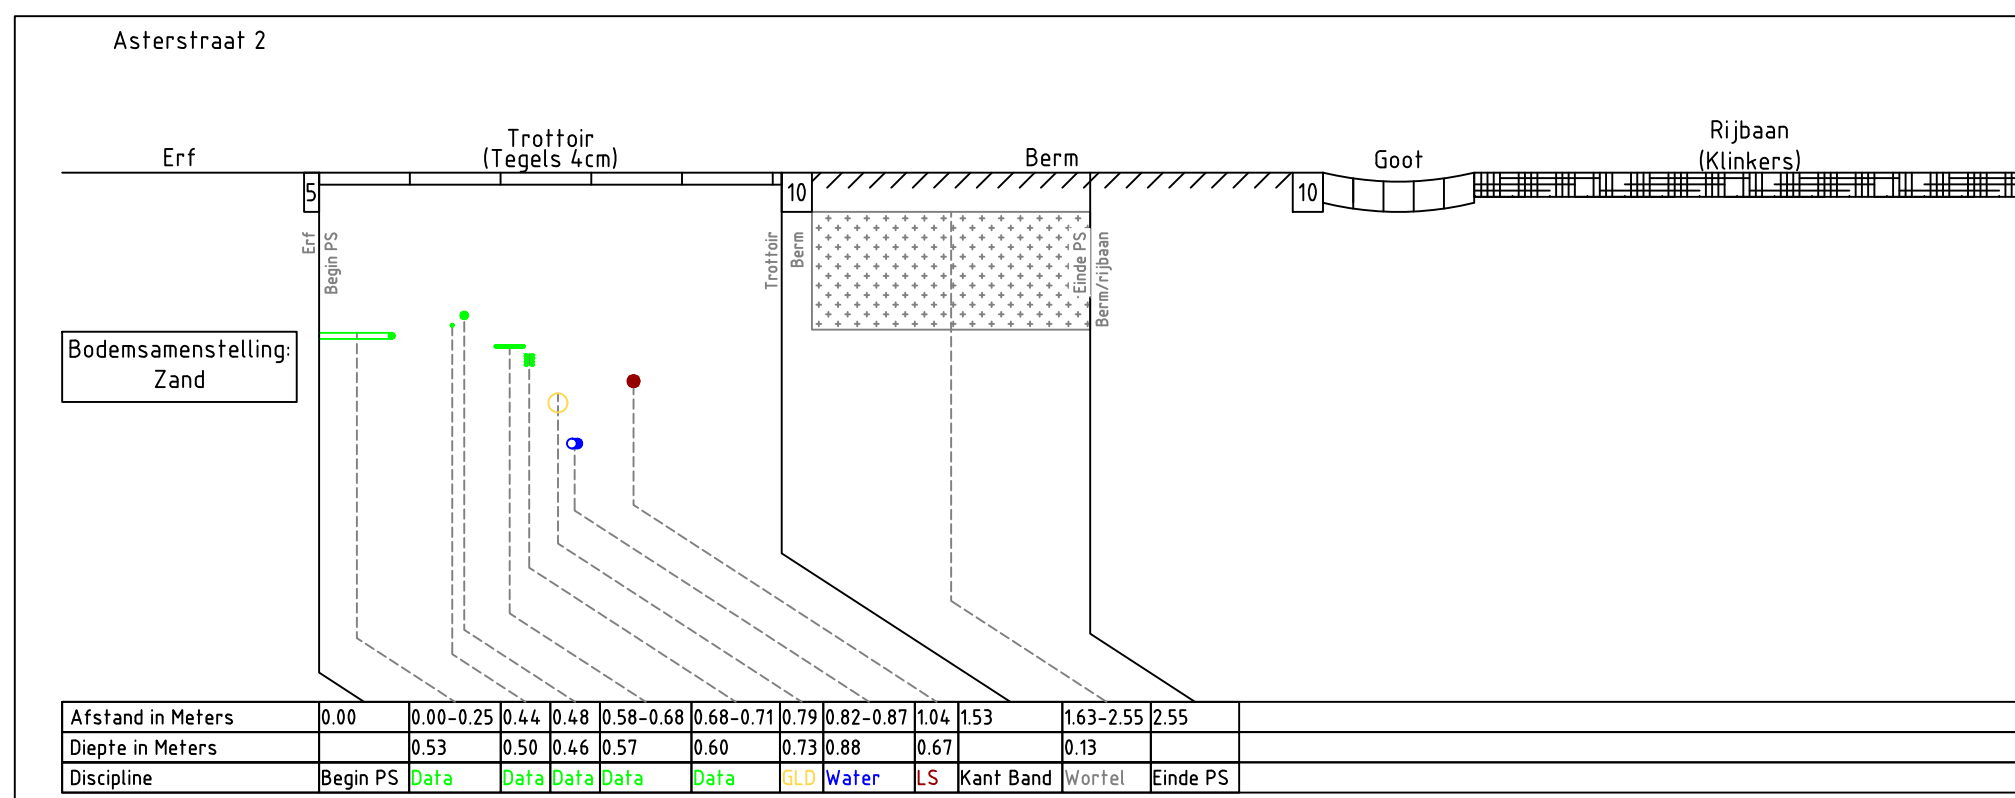




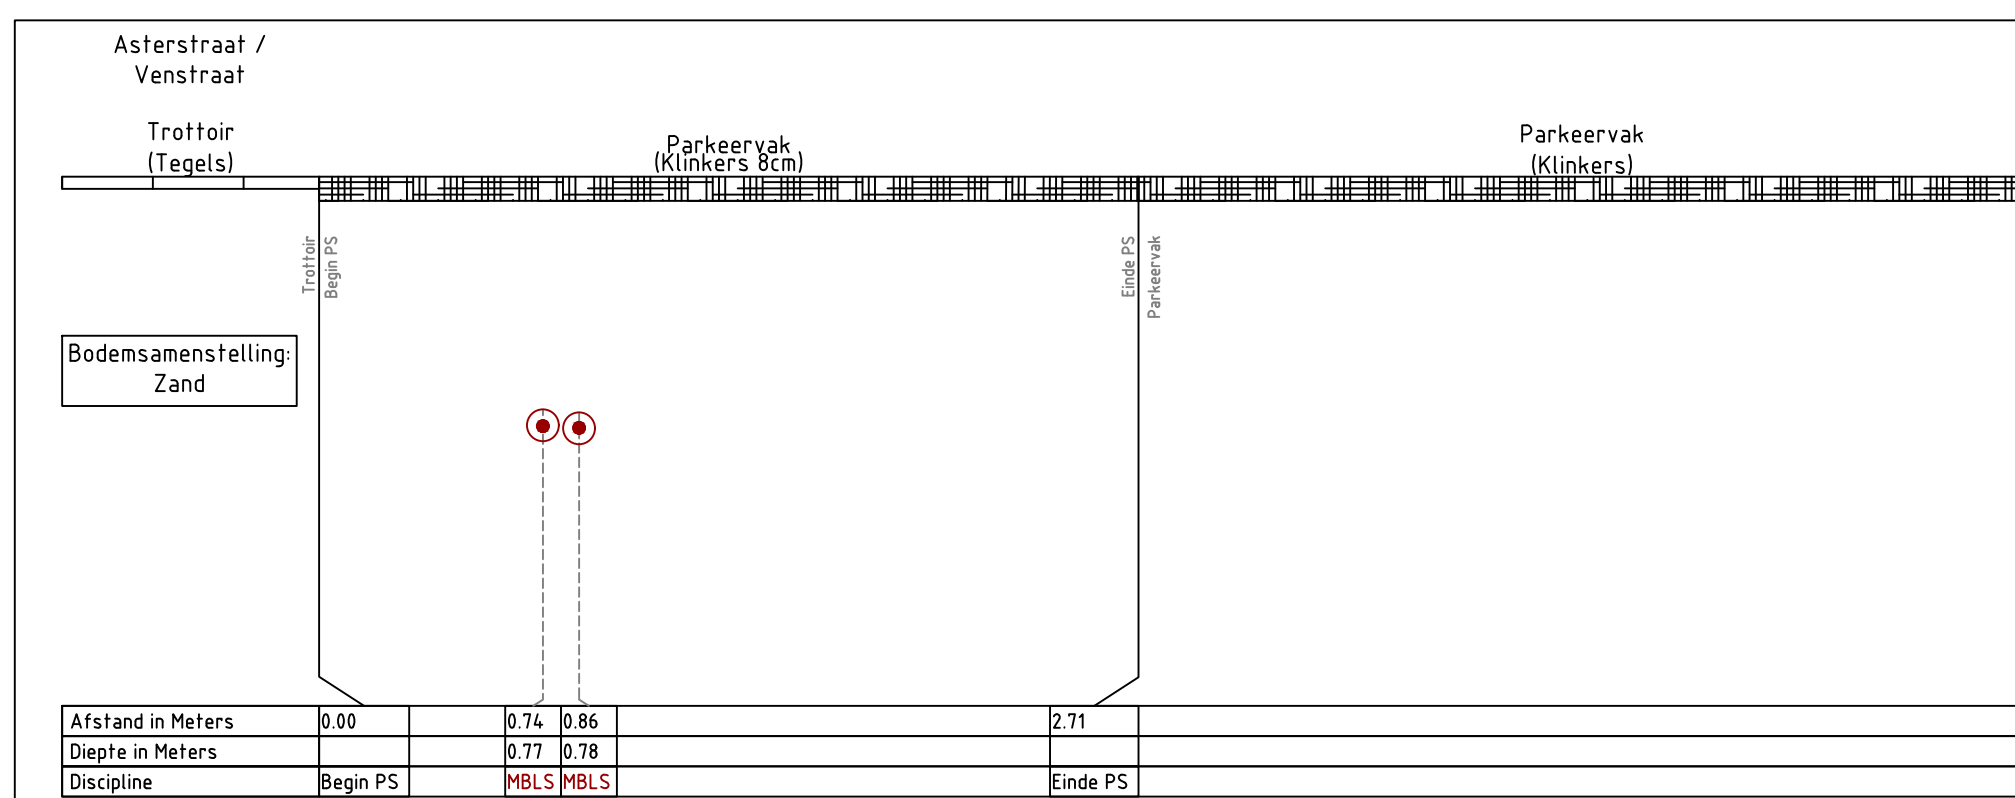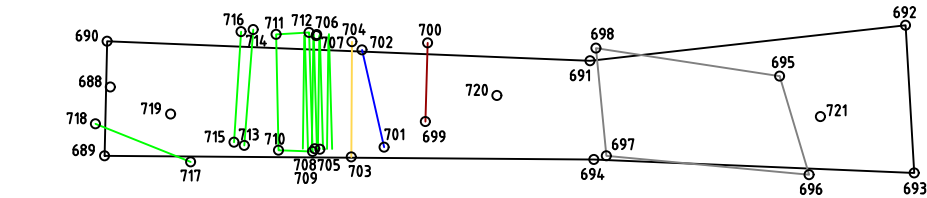

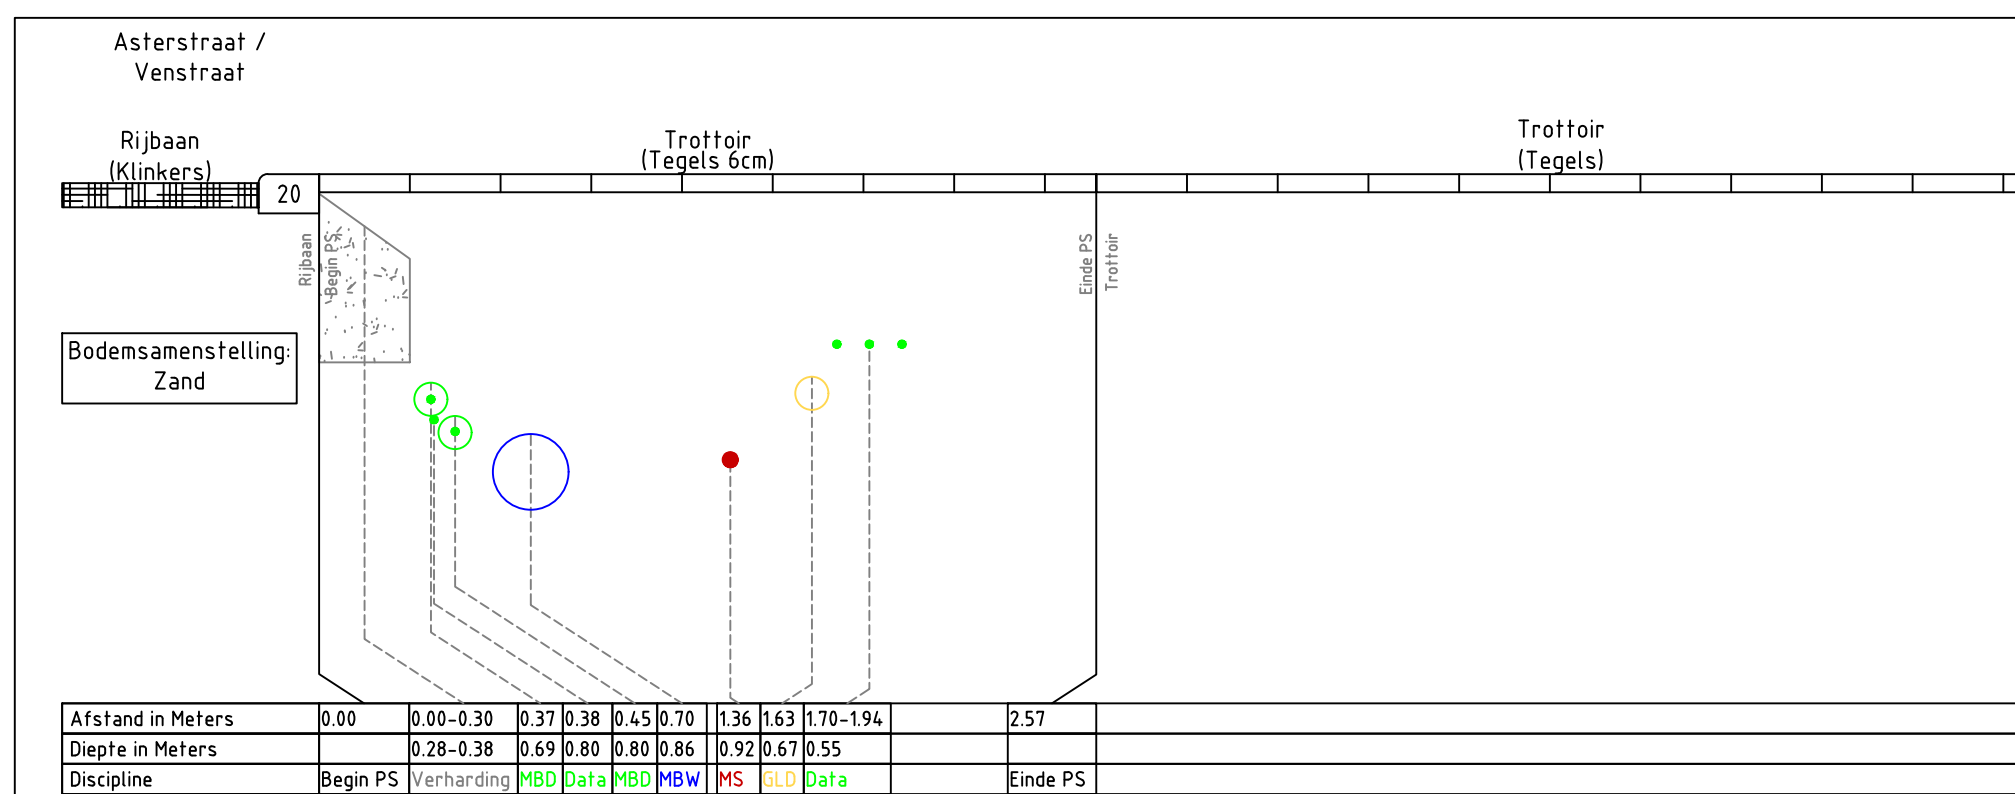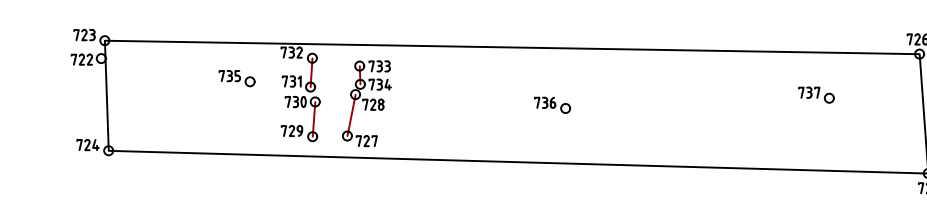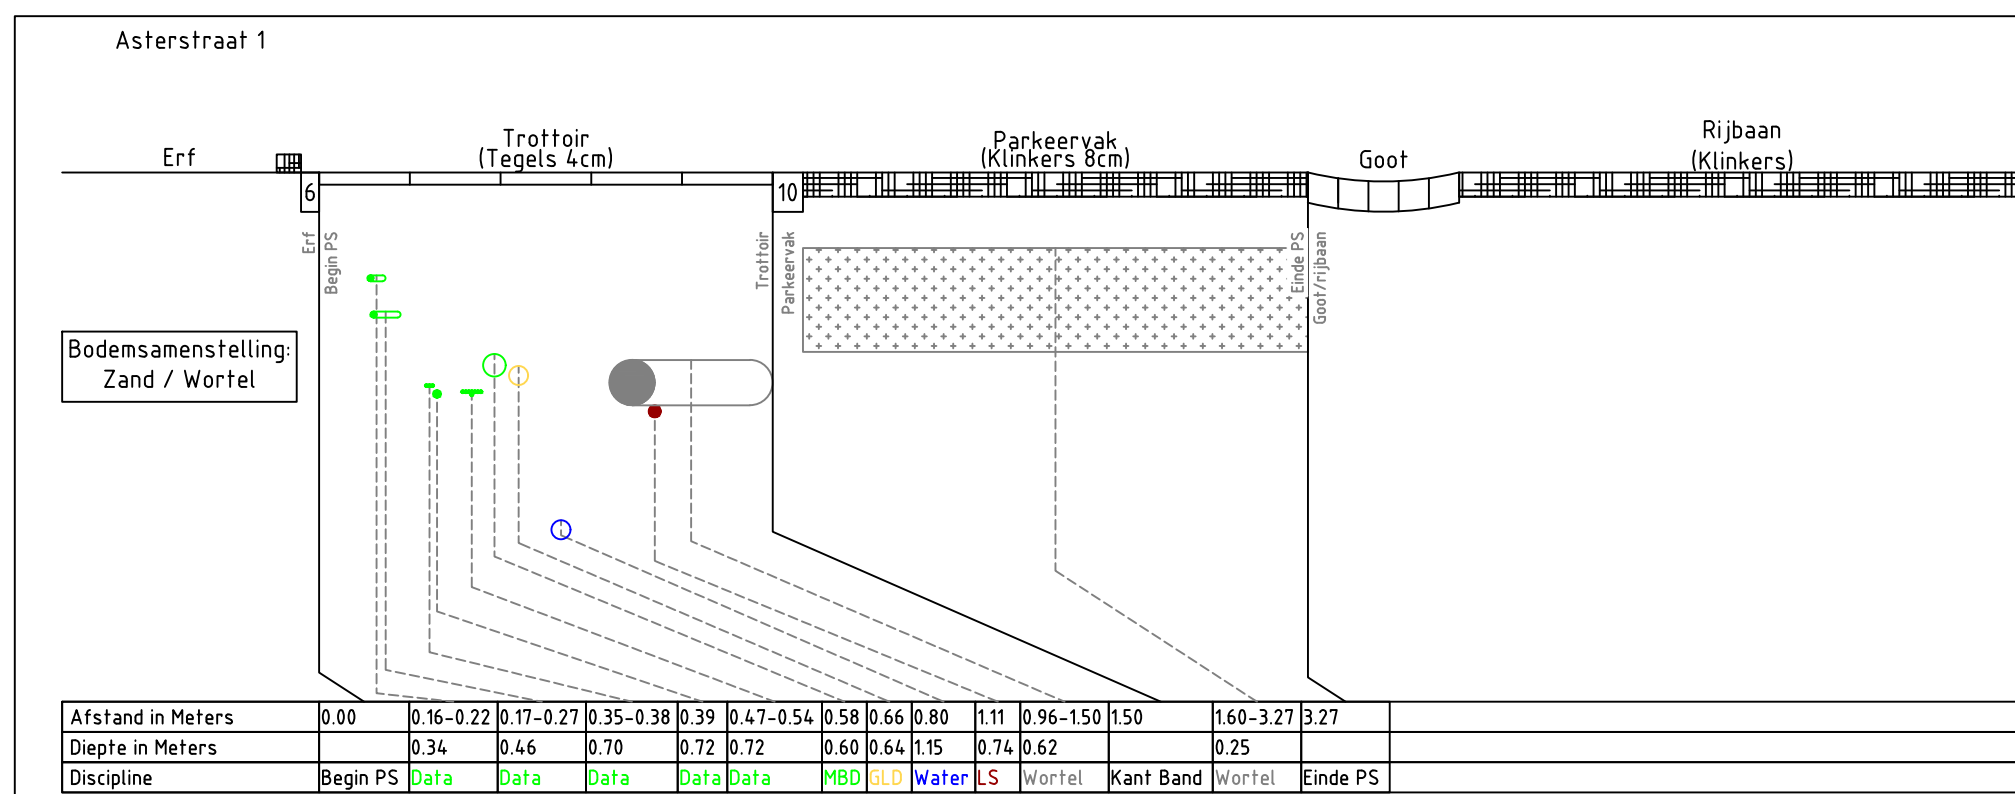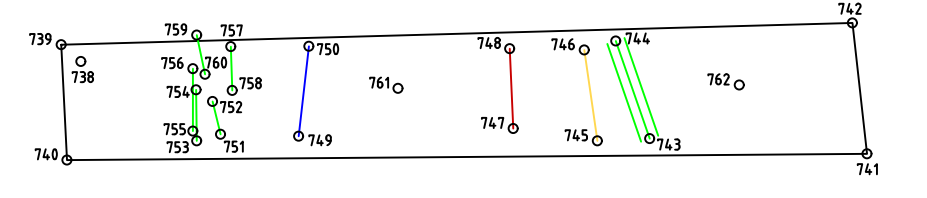[illegible]



