




1

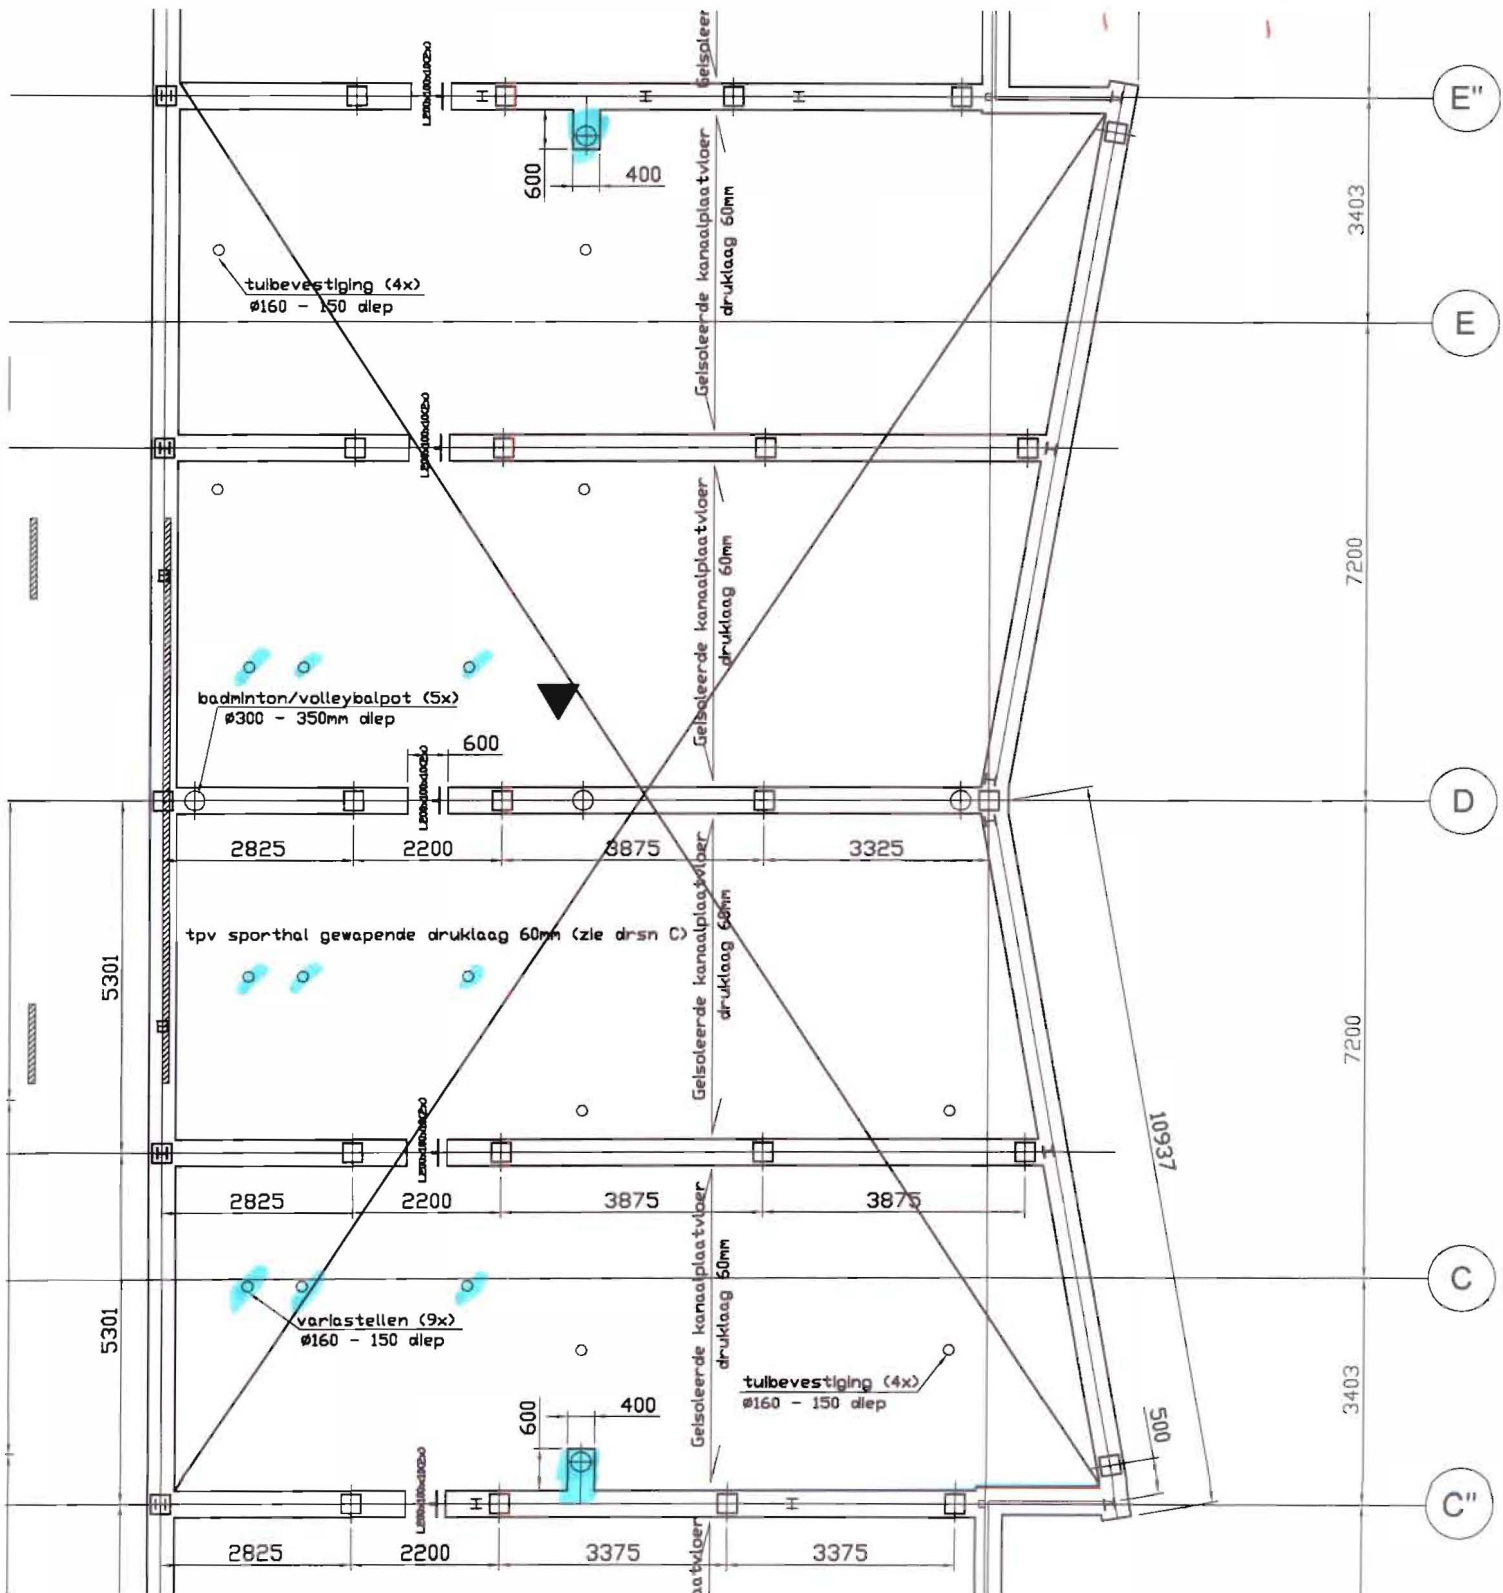

2

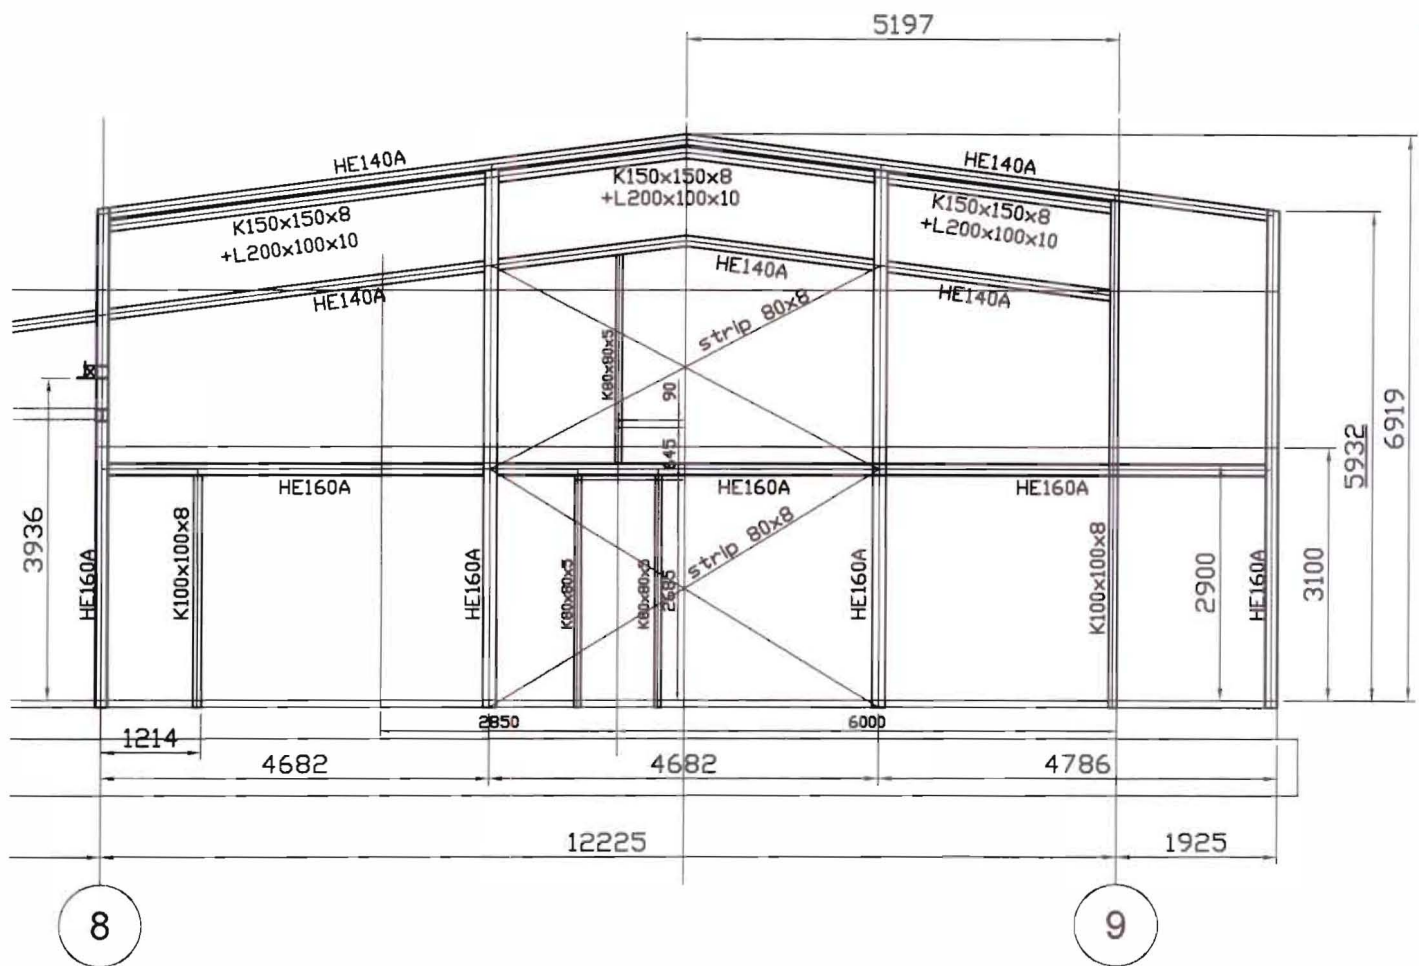


AS E''

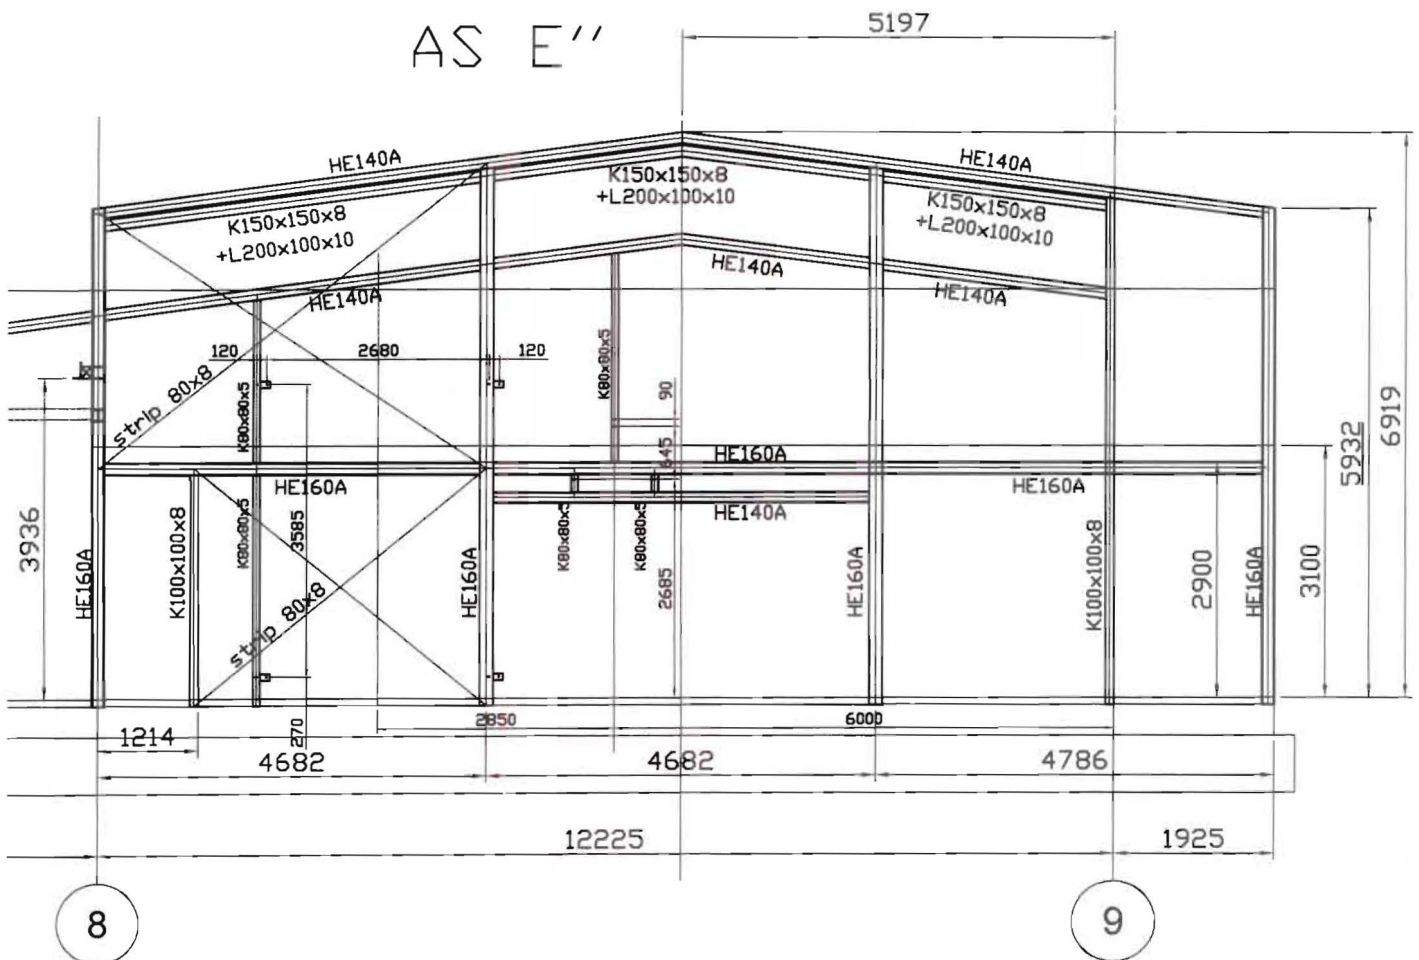

AS C''

As E'' & C'' AANGEPAST
IUM HULPSTAAL

3

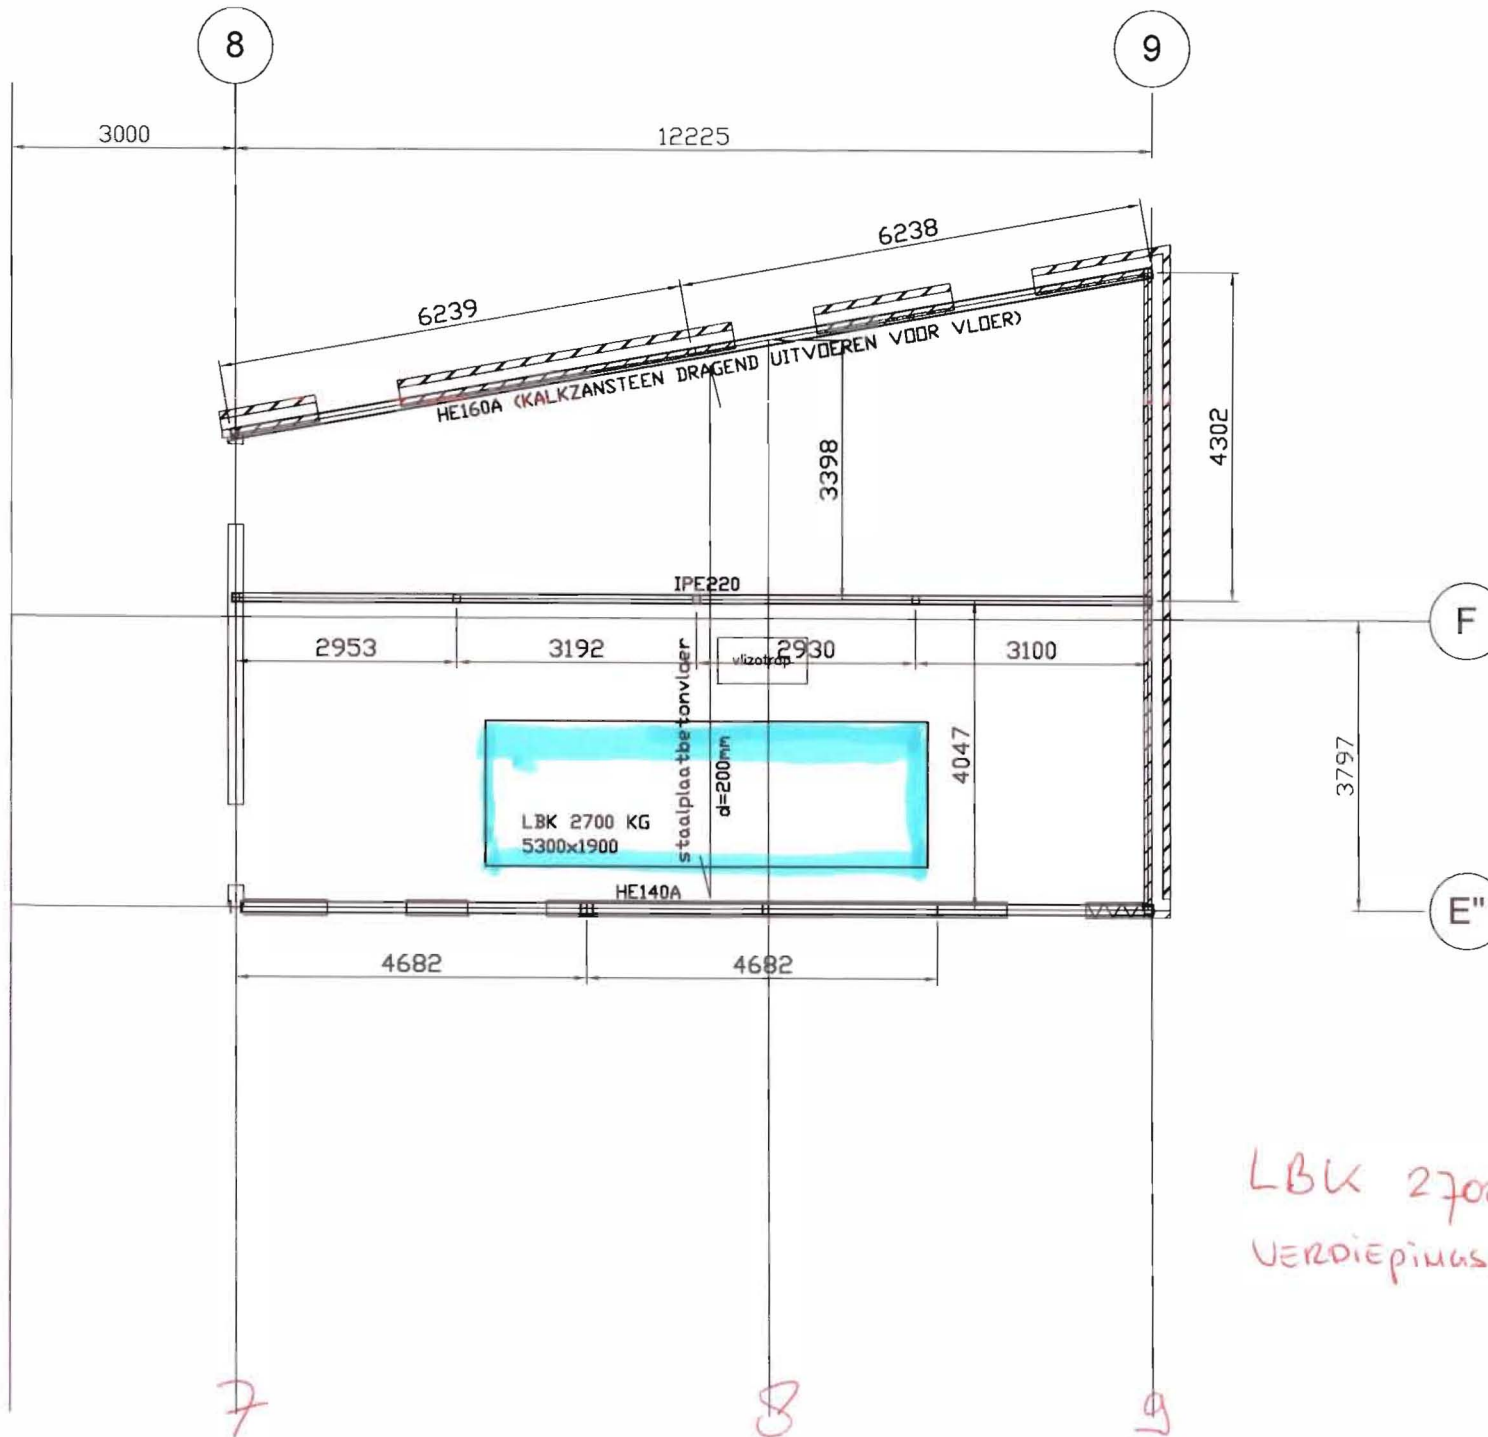

LBK 2700 kg op
verdiepingsvloer.

