


brug

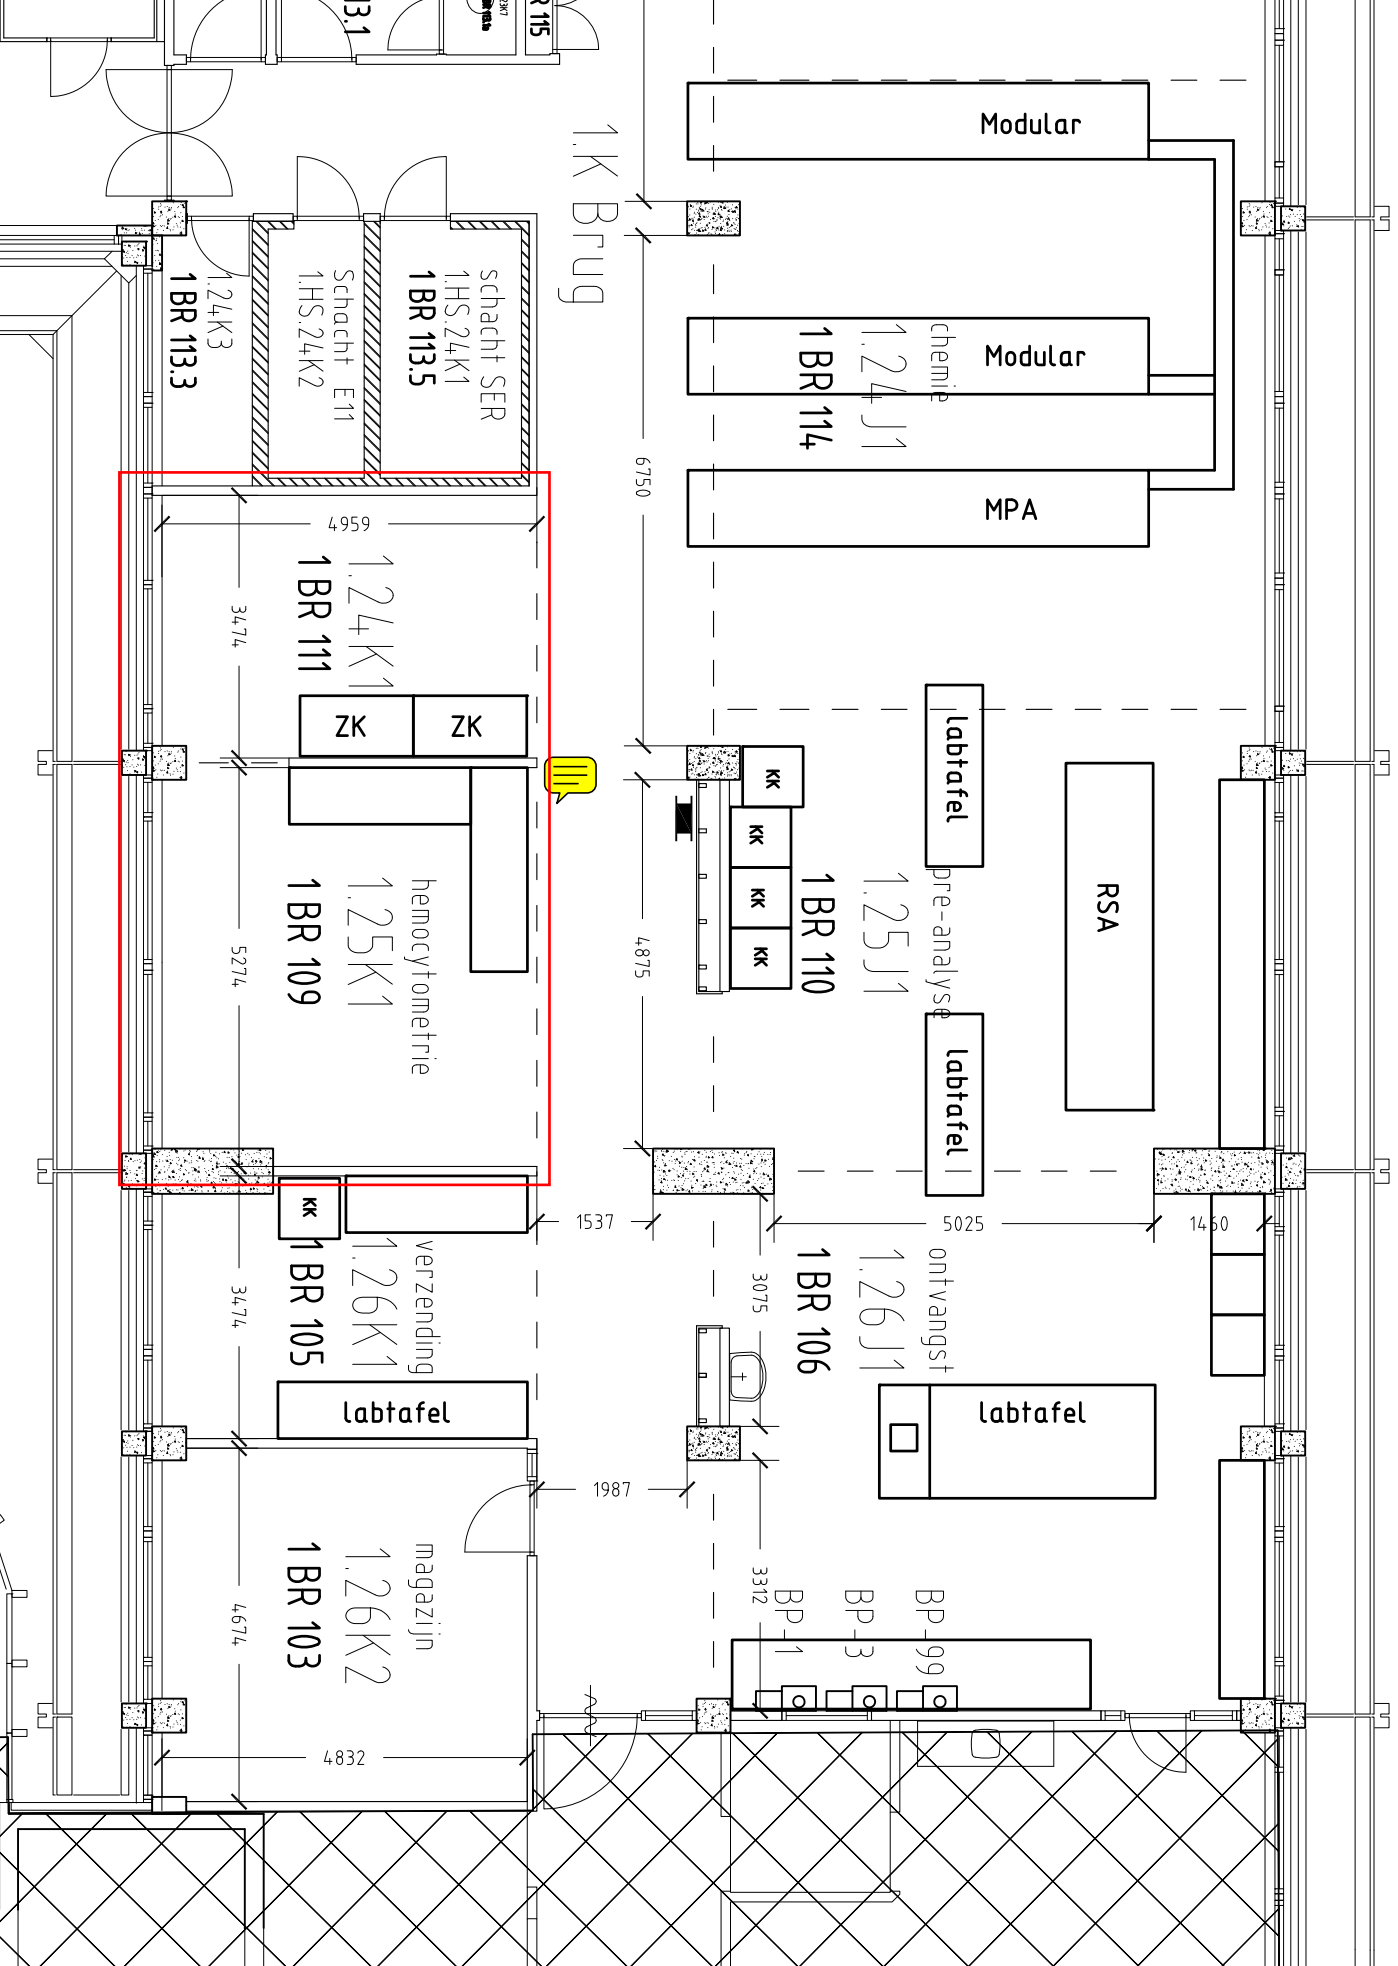

1.K Brug

1 BR 1133

Schacht E11
1.HS.24K2

Schacht SER
1.HS.24K1
1 BR 1135

1.24K3
1 BR 1133

1.24K1
1 BR 111

hemocytometrie
1.25K1
1 BR 109

verzendings
1.26K1
1 BR 105

magazijn
1.26K2
1 BR 103

Modular
chemie
1.24J1
1 BR 114
Modular
MPA

labtafel
pre-analyse
1.25J1
1 BR 110
KK
KK
KK
KK

ontvangst
1.26J1
1 BR 106

labtafel
BP-99
BP-3
BP-1

RSA

labtafel

6750

4.875

1537

1987

4832

4.959

34.74

52.74

34.74

4.674


















