


tracé: aparte kabelgoot/baderbaan

[illegible]


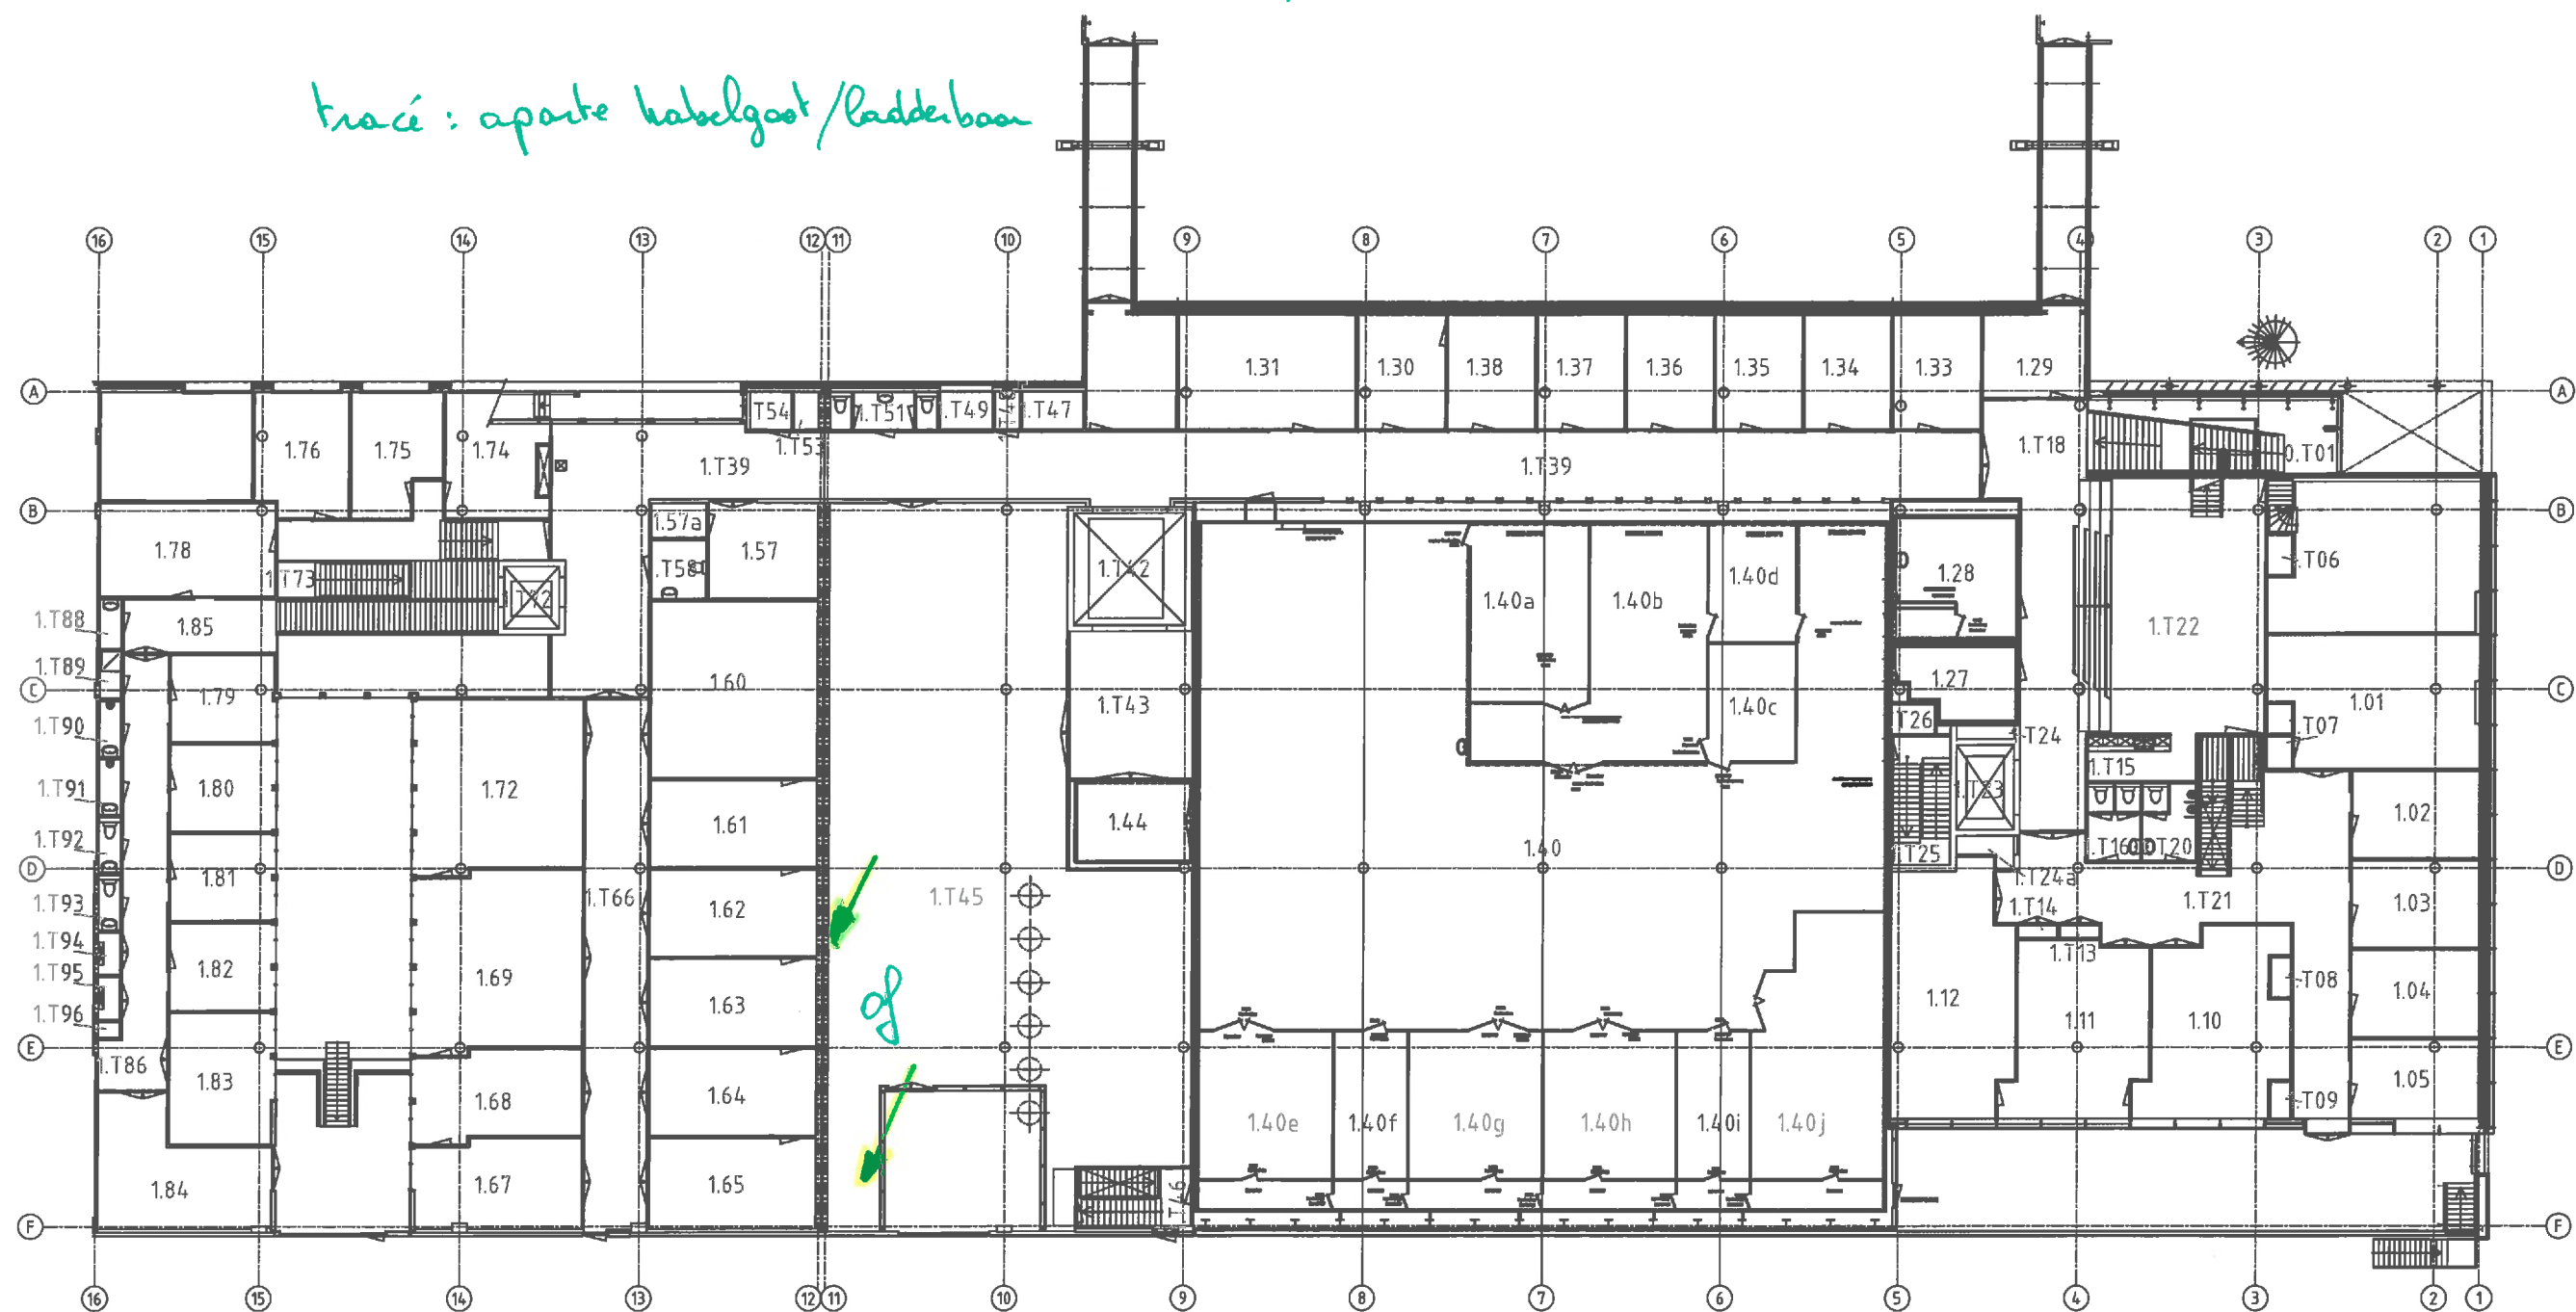


