
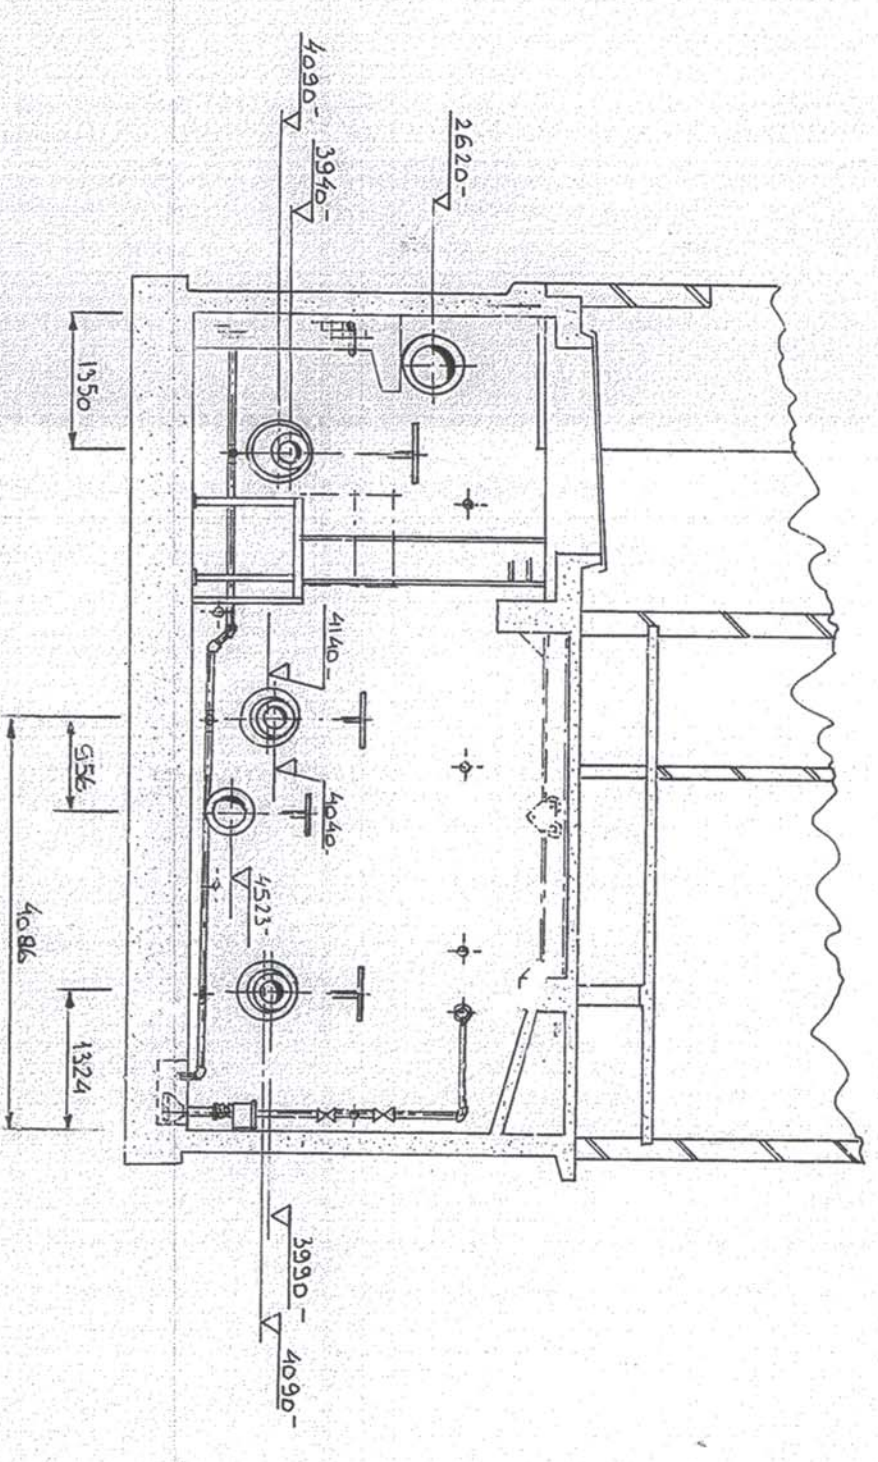
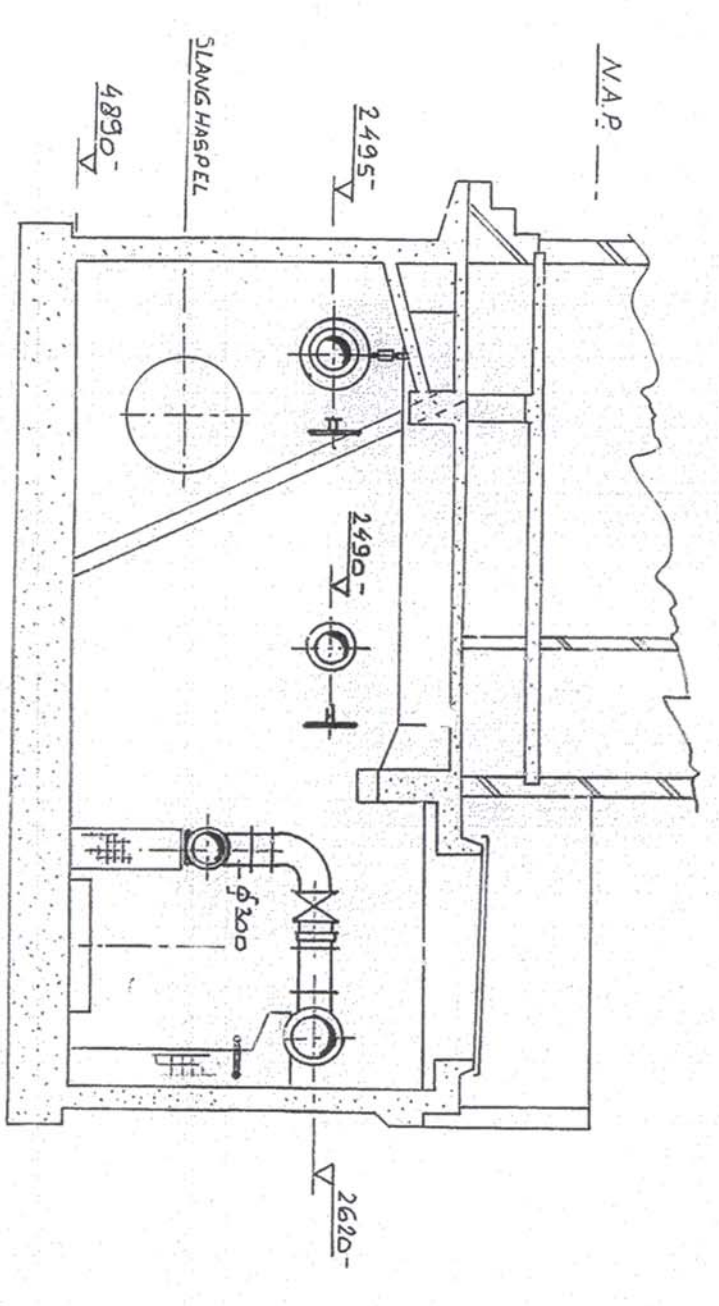
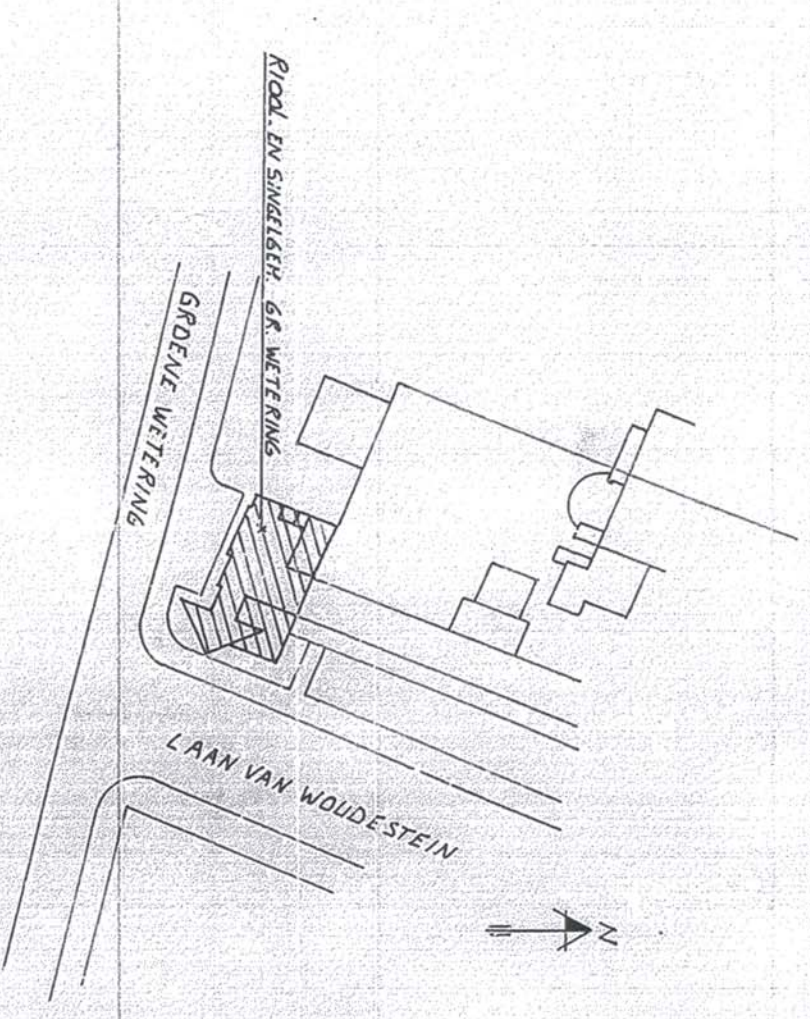
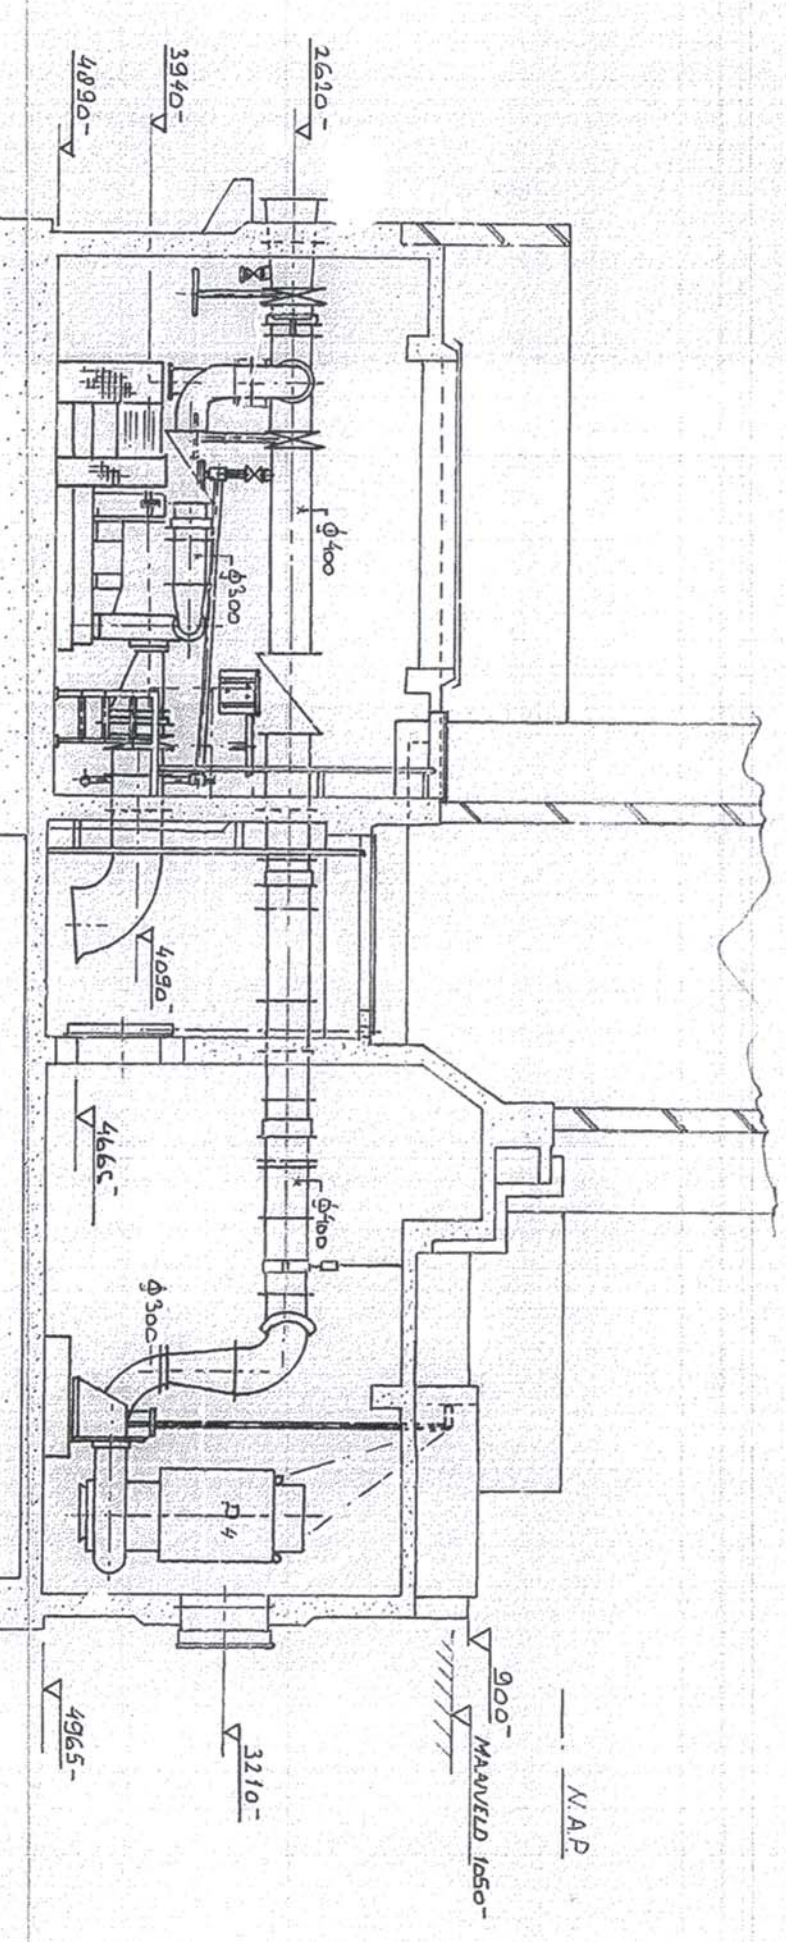
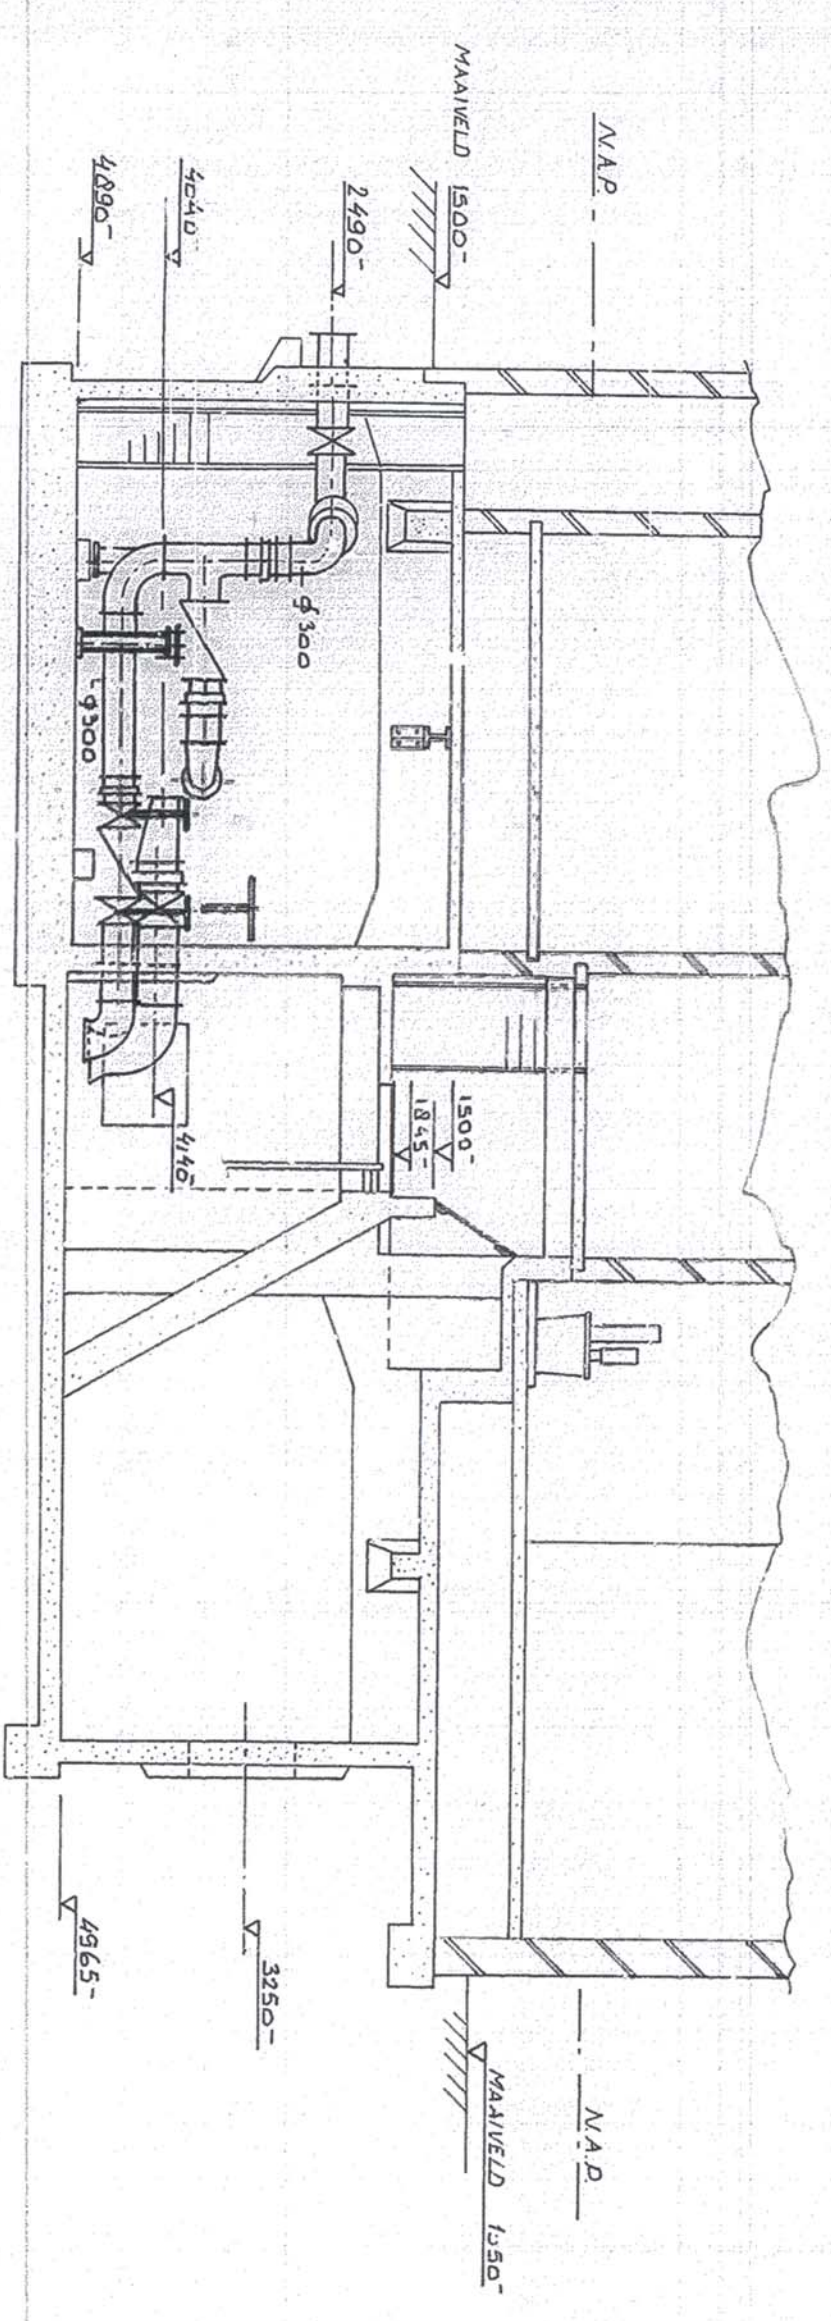
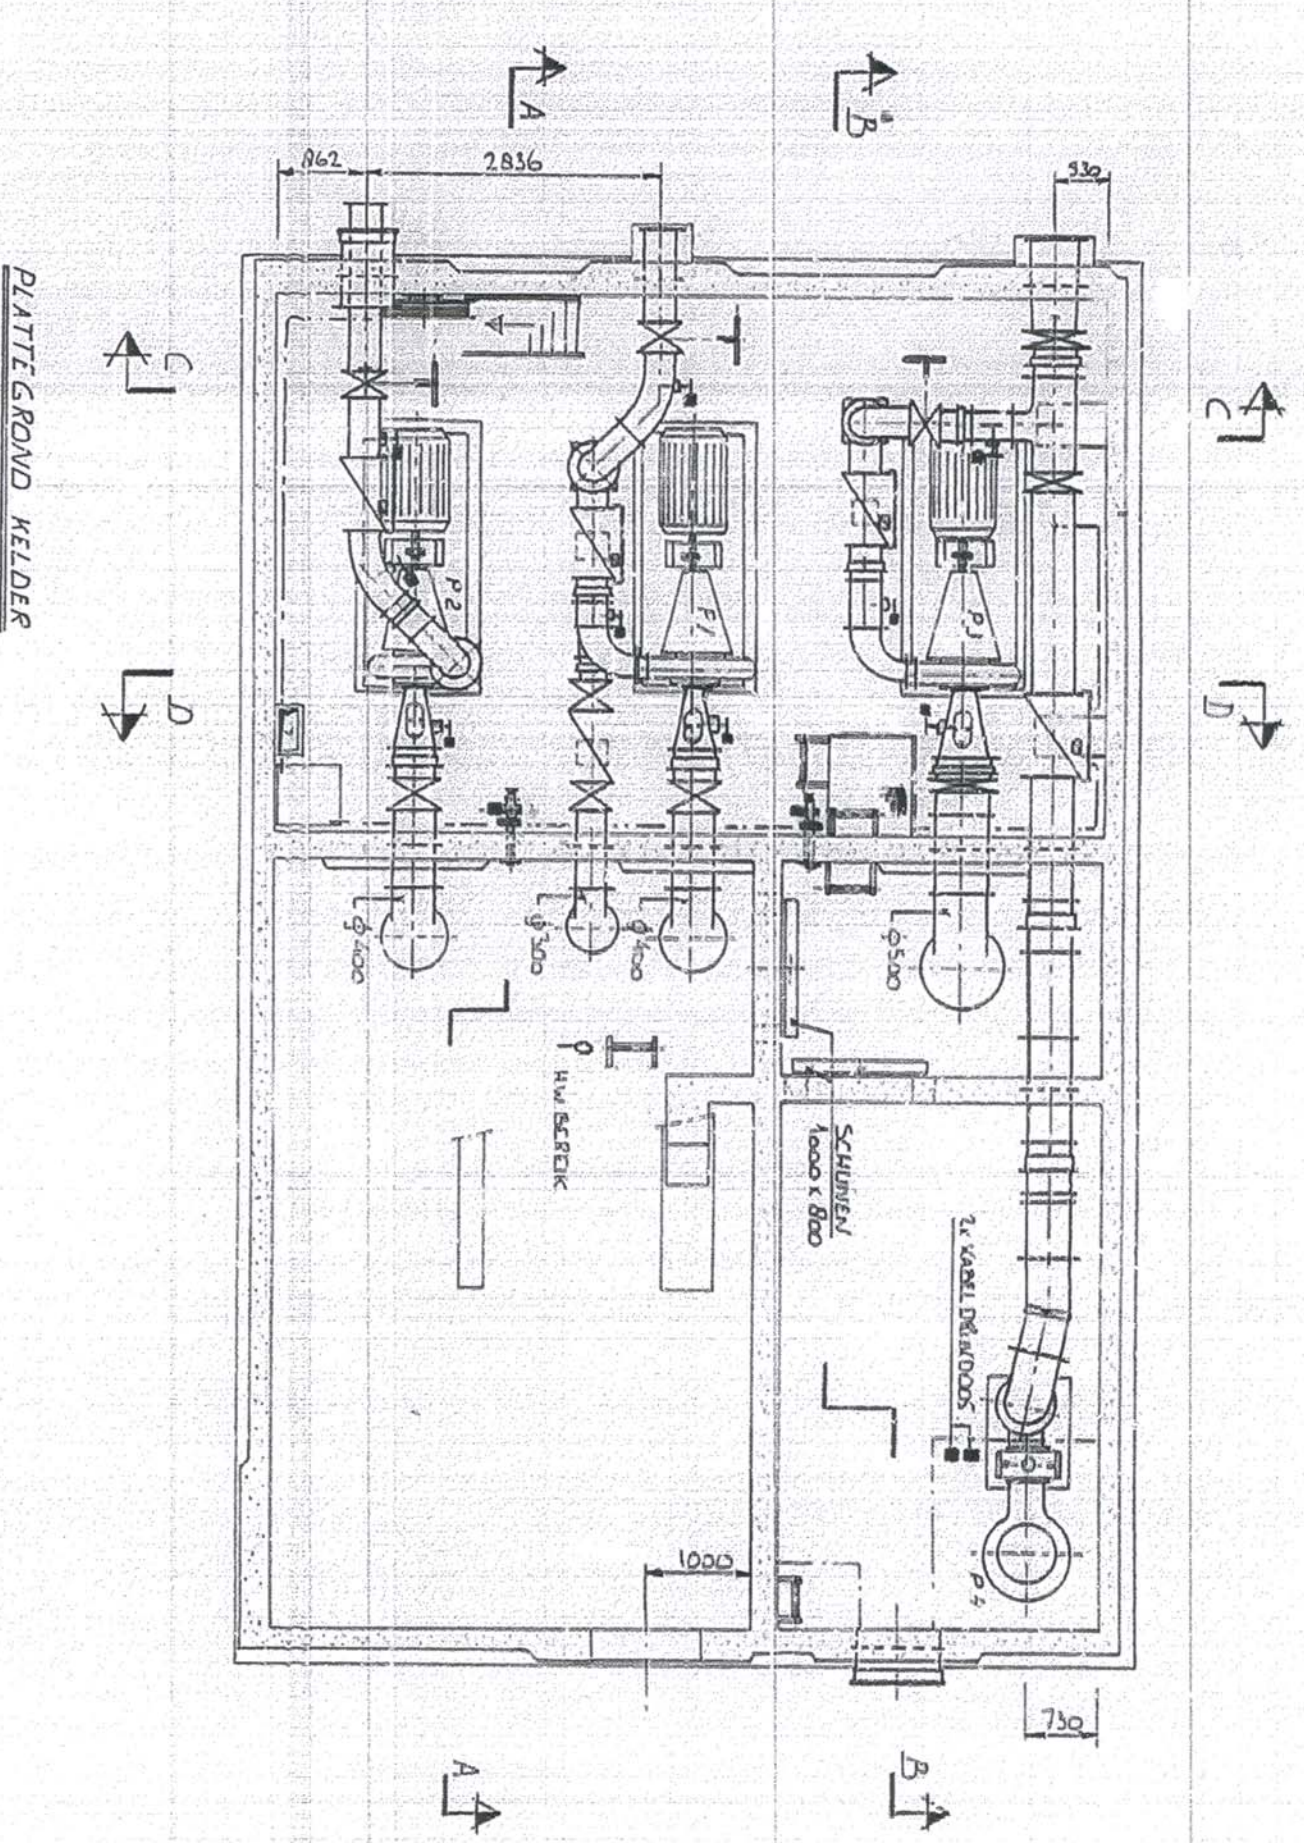



TEK ARCHIEF
PORT 740
No. 429
GEMWERKEN ROAM

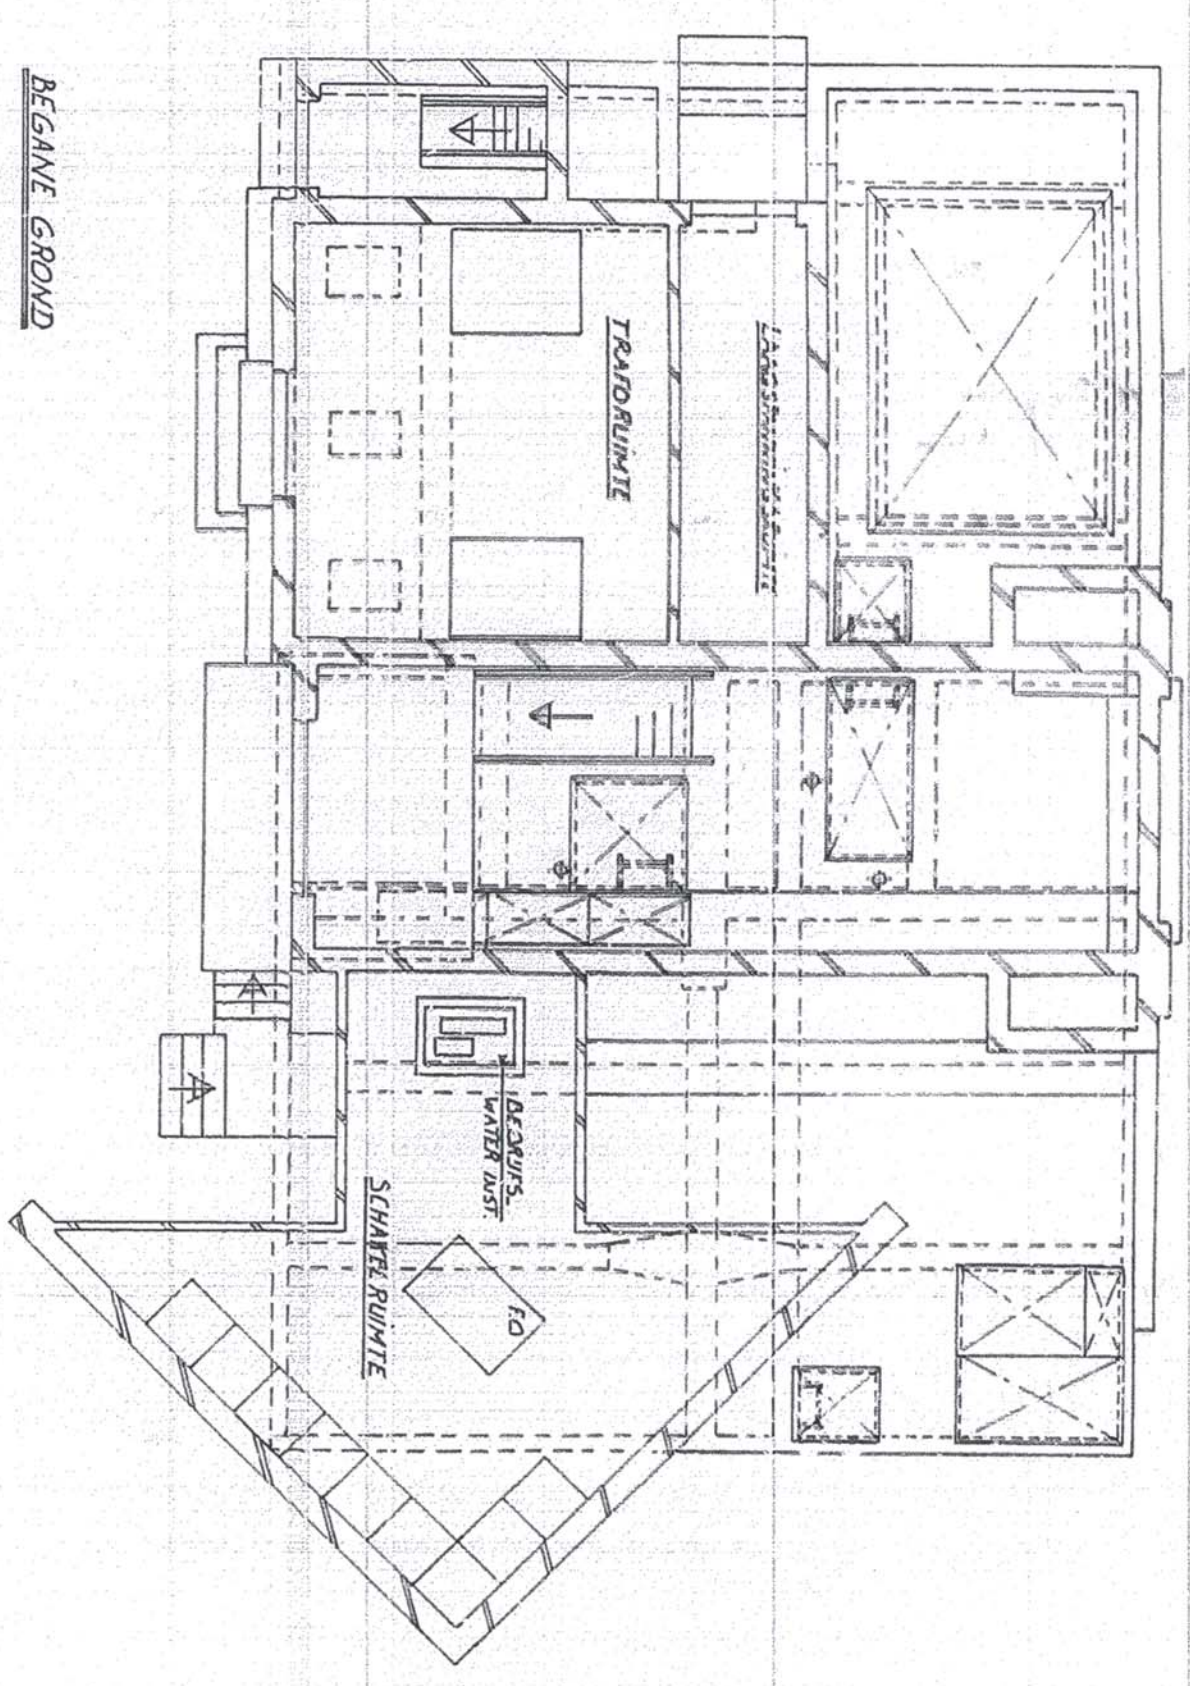

TEK A.D.I.-8 G.W. N° 7287-27
"REVISIE"

VEROLME IJSEL MONDE B.V.
ENGINEERING WORKS AND FIELD CONSTRUCTION
RIOOL-EN SINGELGEMAAI GROENE WETTING
POMPSTELLING

