



Dwarsprofiel DWP-1
t.o.v. as ALM - (1)
bij metring 192.436
Schaal 1:100
-2.750m t.o.v. NAP

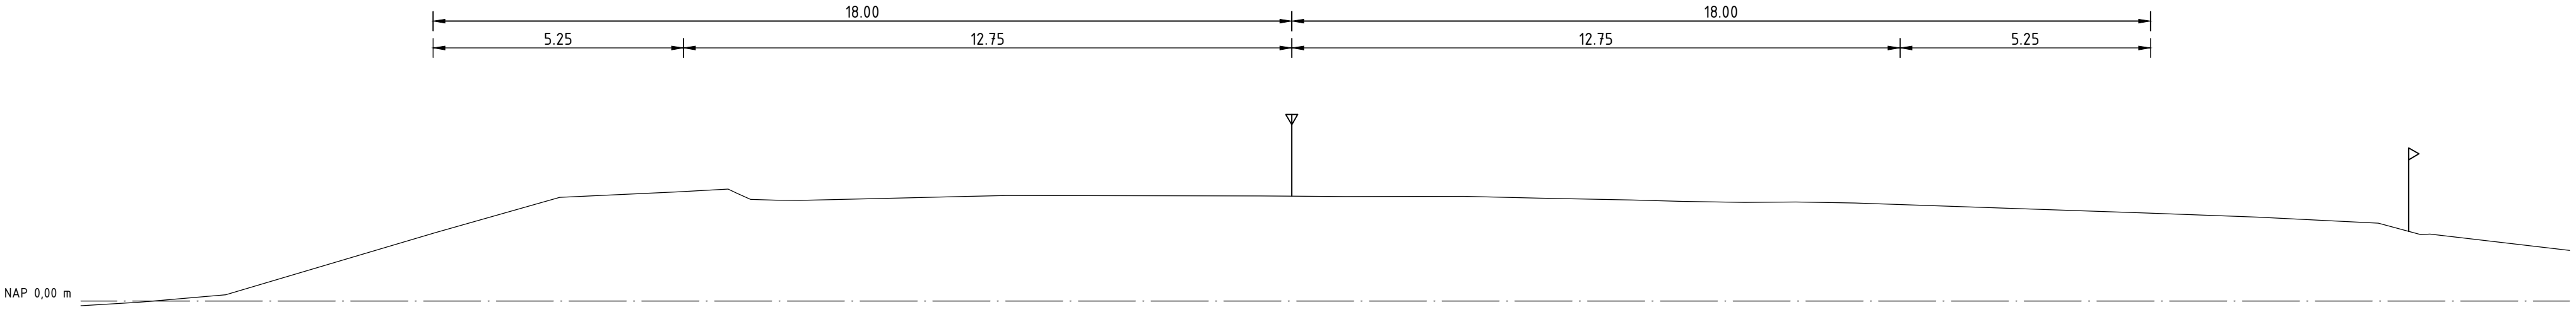

Hoogte	-0.097	-0.026	0.130	1.436	2.115	2.281	2.349	2.134	2.112	2.112	2.164	2.106	2.212	2.205	2.200	2.190	2.194	2.199	2.119	2.092	2.008	2.016	2.055	1.844	1.798	1.634	1.392	1.061
Afstand	-22.380	-24.461	-21.247	-17.952	-15.344	-12.881	-10.812	-11.344	-10.889	-10.315	-7.977	-6.779	-5.985	-0.657	0.000	1.110	3.609	5.205	7.122	8.888	9.491	10.566	11.810	17.953	22.244	22.718	23.669	26.785

Dwarsprofiel DWP-2
t.o.v. as ALM - (1)
bij metring 192.436
Schaal 1:100
-2.750m t.o.v. NAP

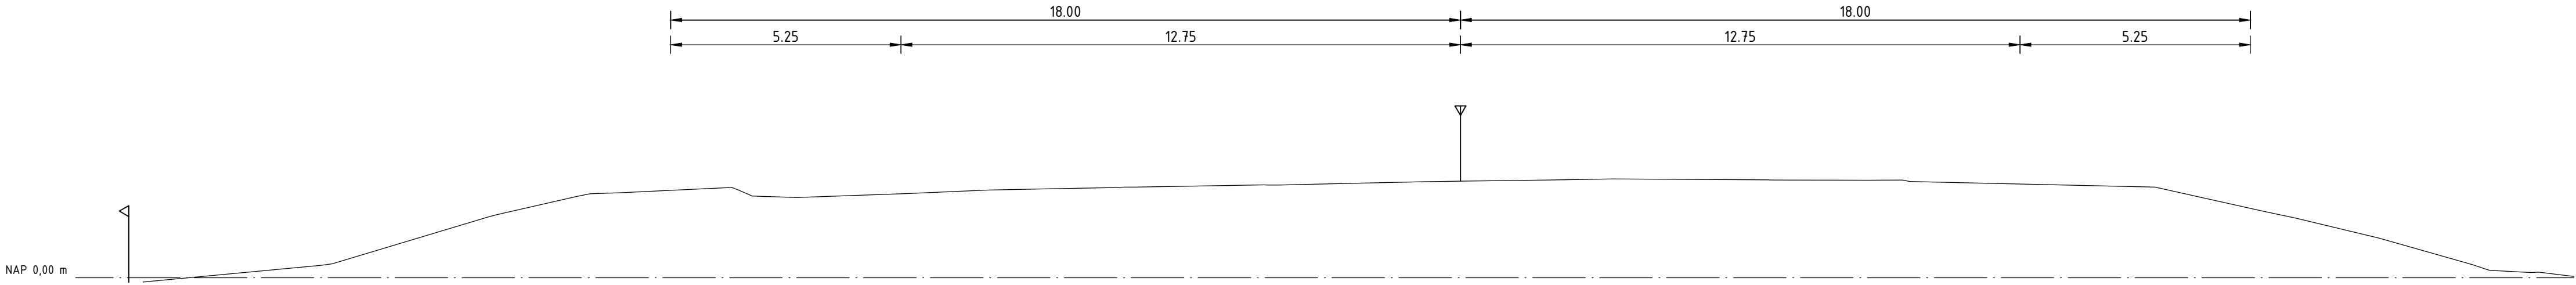

Afstand	-31.571	-30.020	-25.710	-21.554	-19.835	-18.102	-17.760	-16.482	-15.598	-15.119	-12.827	-10.377	-9.538	-7.789	-7.411	-4.198	-2.905	-0.813	0.000	1.992	3.472	6.863	15.824	18.311	19.033	20.934	22.866	24.387	25.374