


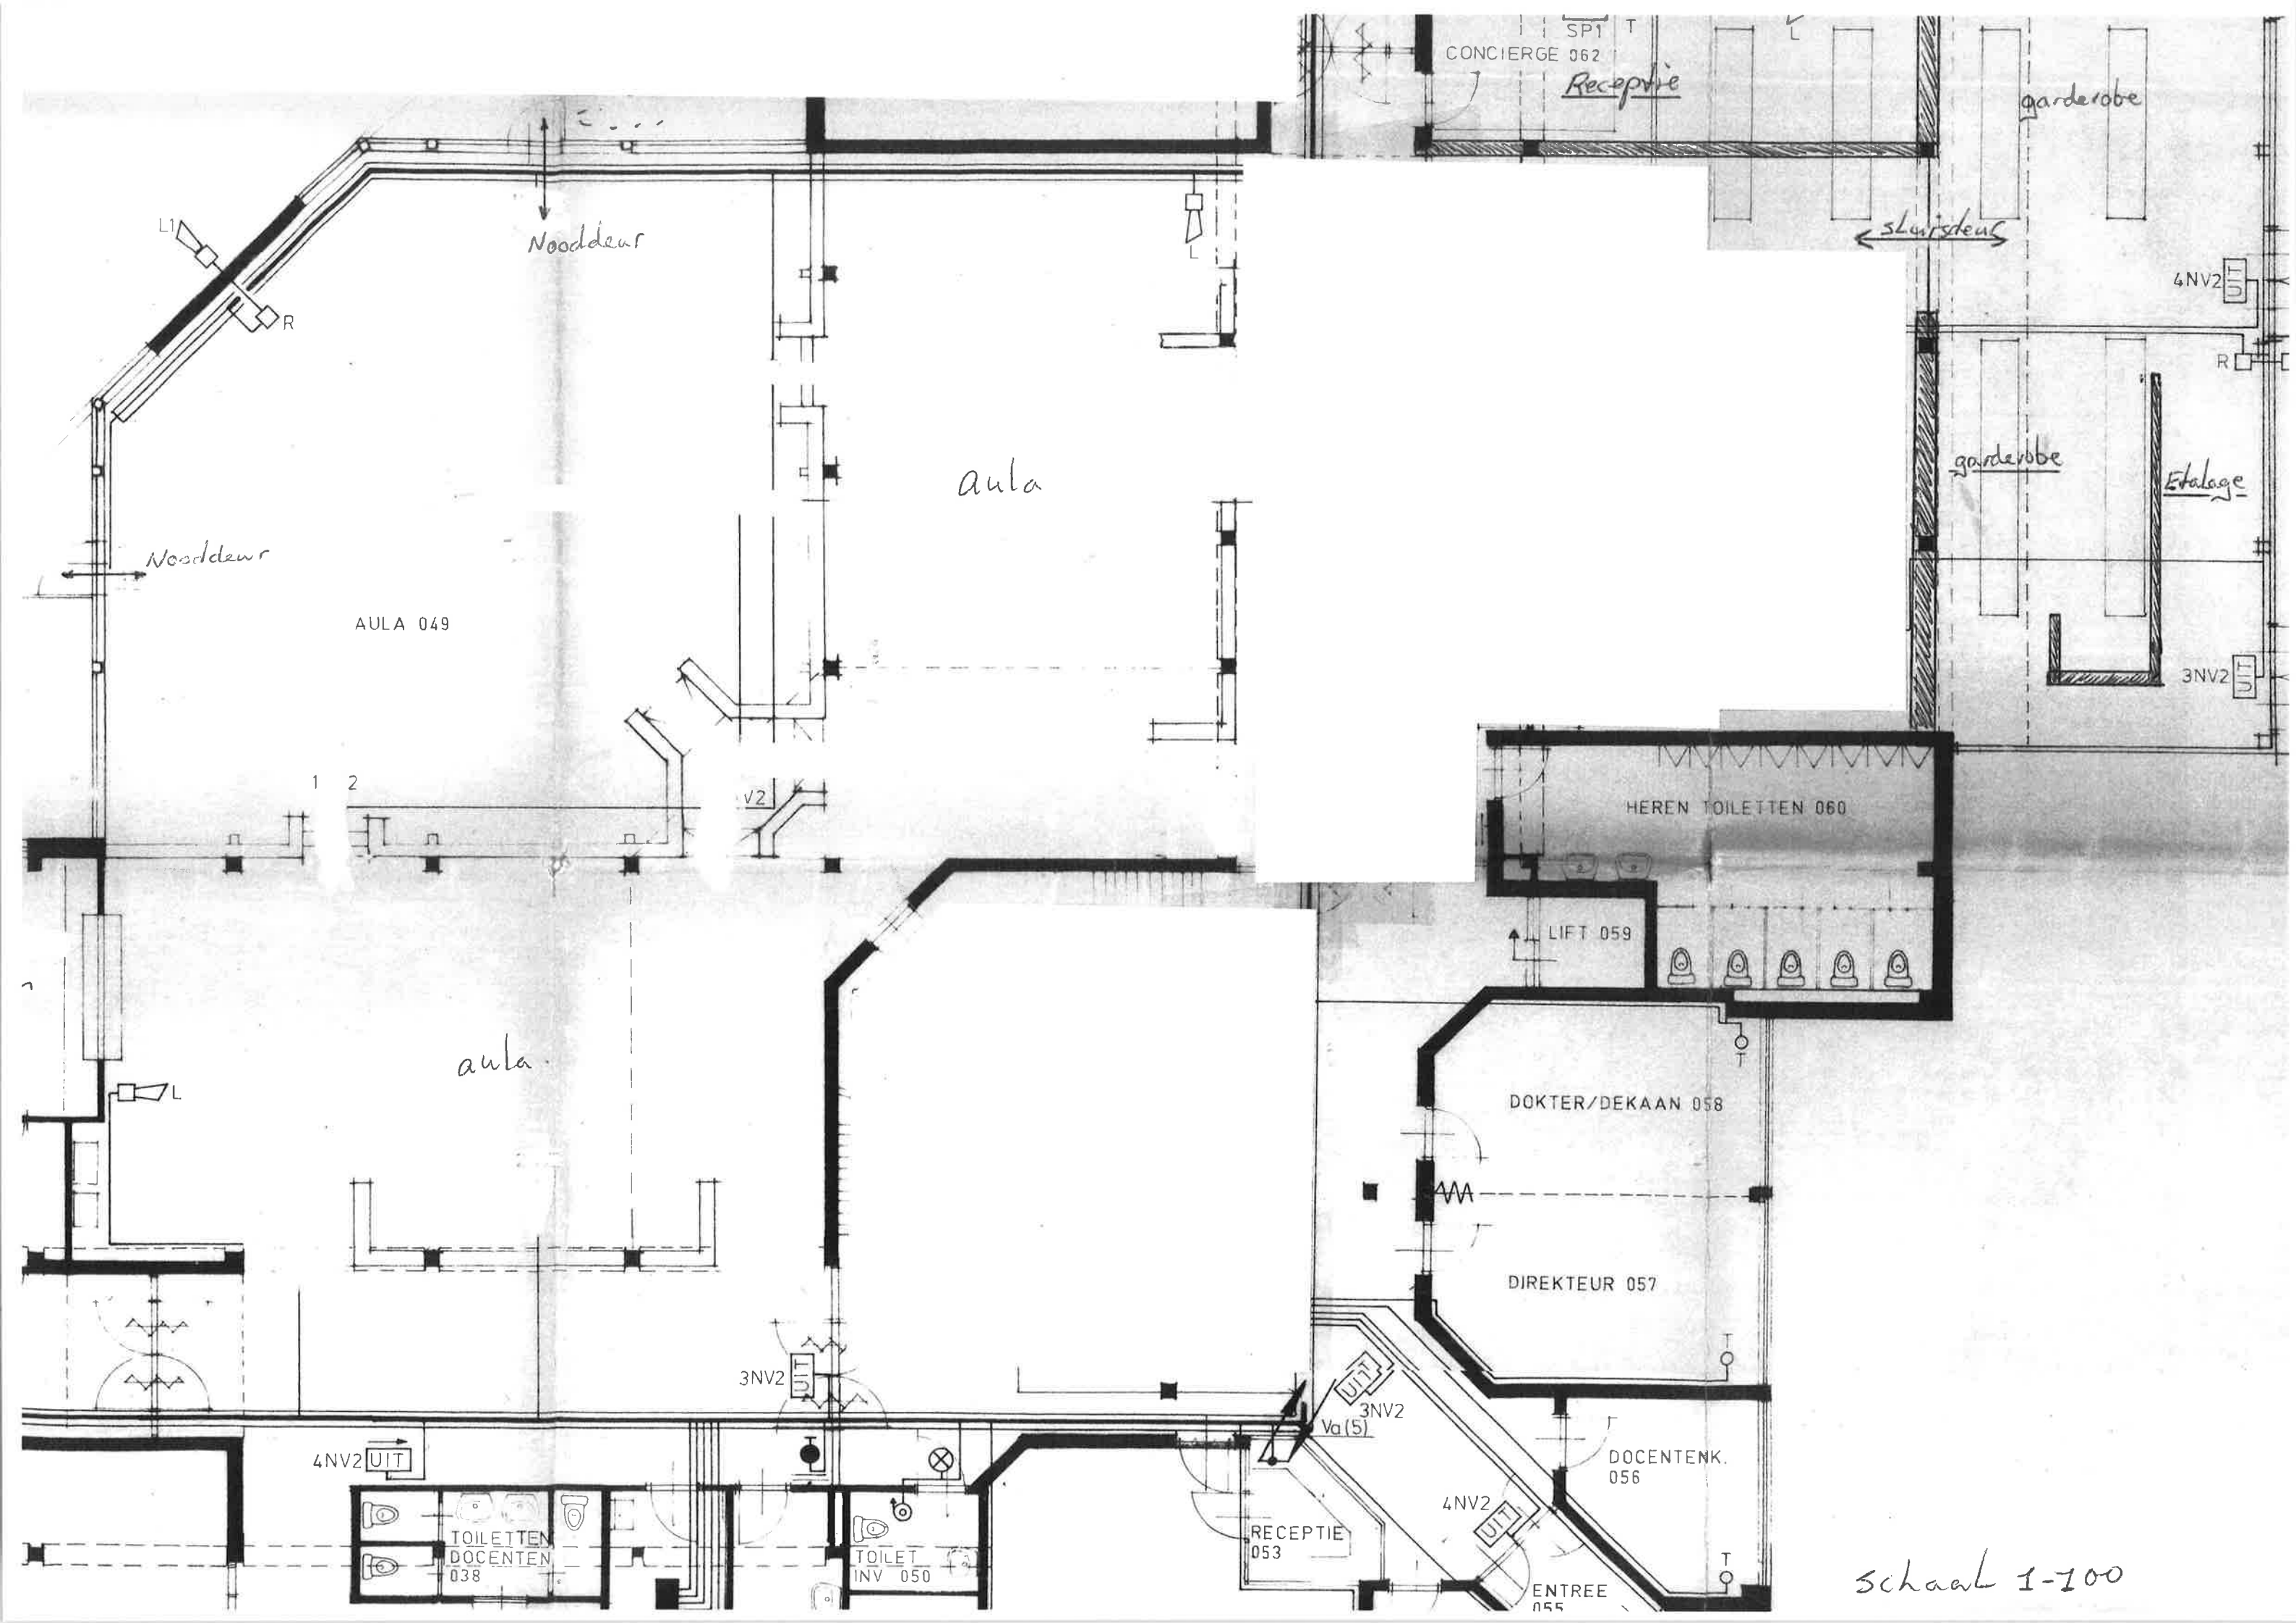

Schaal 1-100



