



13:05 FAX 31 77 3824844




ENVIROTECH NL

NO. 805 810 100
@ 002 / 000

GEHO PUMPS

PUMP TYPE **RP 100-270-42**
n (min⁻¹) **485 t/m 960**

No **805.810.100**
Date **JAN1987**
Impeller **270/100x85**

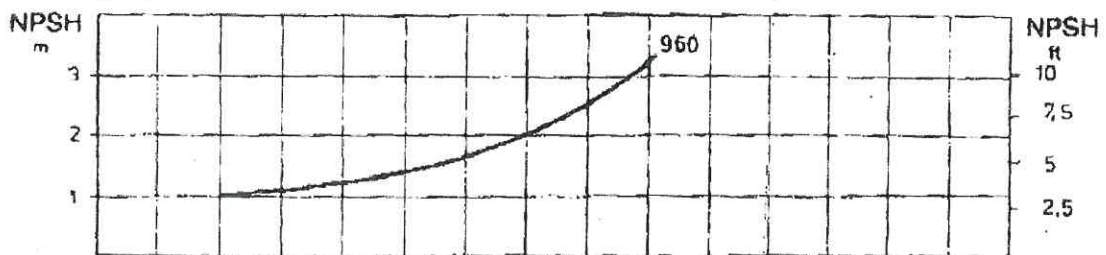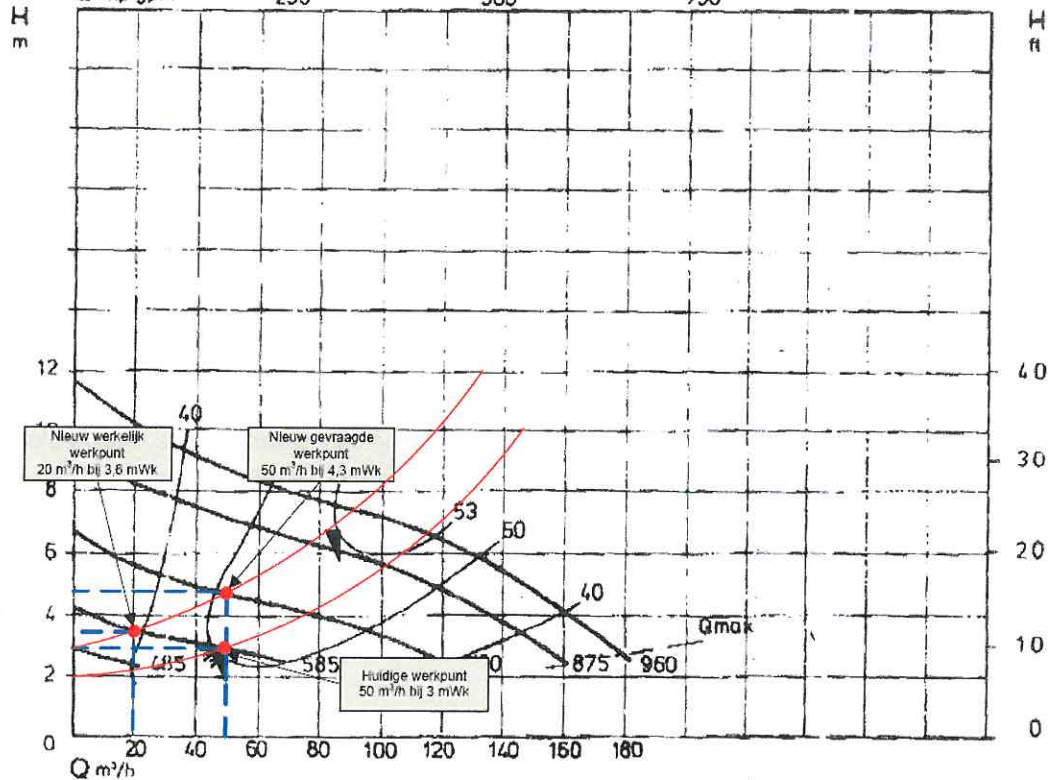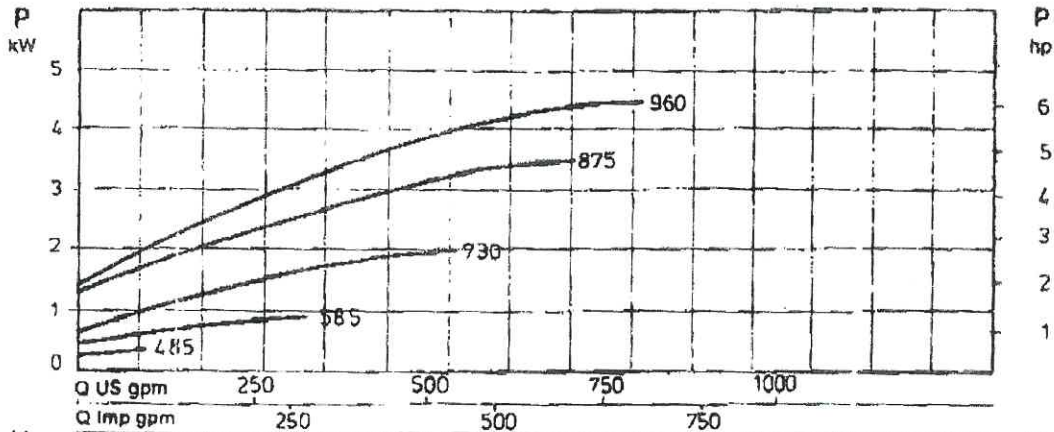

These curves are made up in accordance with the rules for centrifugal pumps of VDI DIN 1944

806.080.017

Enquiry No: Quotation No: Order No: